
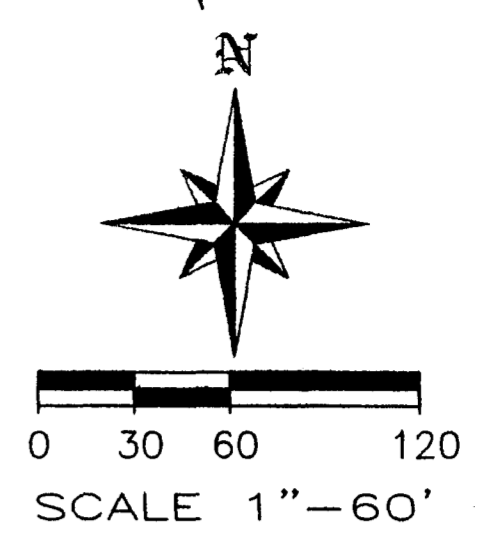


split

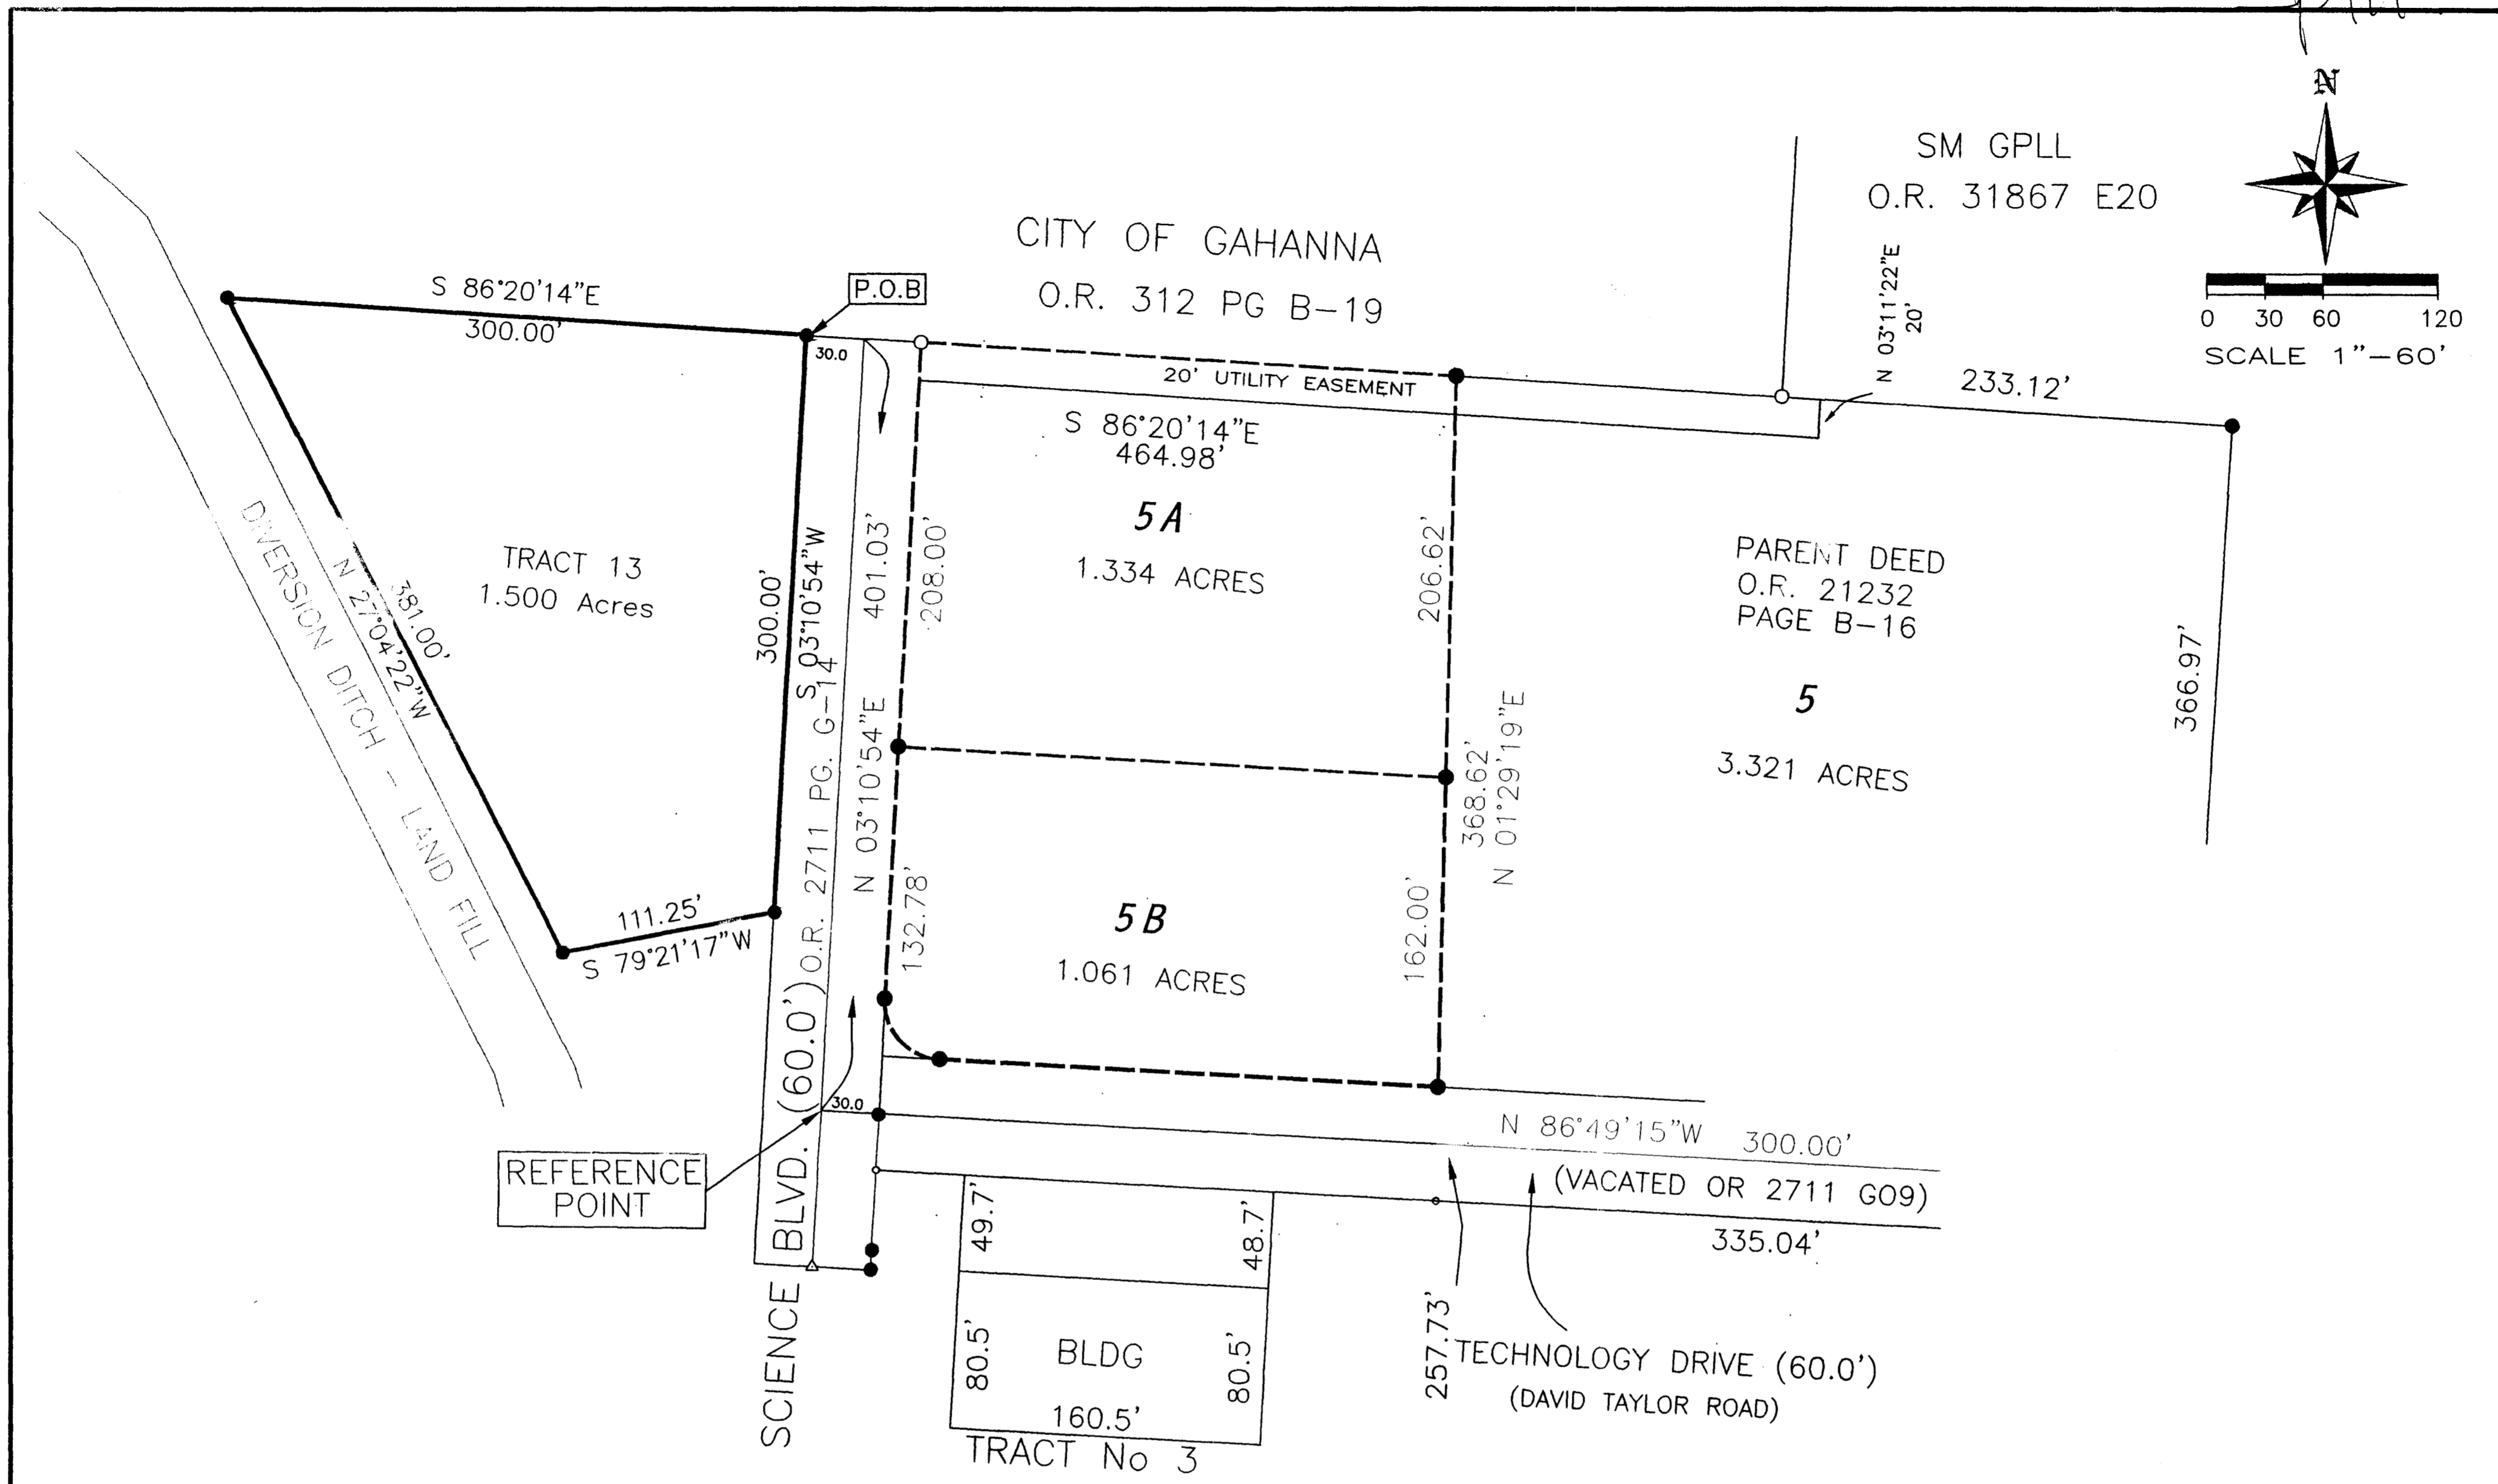


**LAND SURVEY**  
**PLAT OF SURVEY MADE**


FOR:  
**TIM MEHAN**

SHOWING A SMALL TRACT OF LAND LYING IN THE STATE OF OHIO,  
 COUNTY OF FRANKLIN, CITY OF GAHANNA, LOCATED IN PART OF  
 LOT 23 OF QUARTER TOWNSHIP 3, TOWNSHIP 1, RANGE 16,  
 UNITED STATES MILITARY DISTRICT, BEING PART OF THAT 13.555 ACRES  
 TRACT OF LAND DESCRIBED IN OFFICIAL RECORD 21232, PAGE B-16,  
 TO BRICK MOULDING CO. (AS RECORDED IN THE RECORDER'S OFFICE,  
 FRANKLIN COUNTY, OHIO).  
 SURVEY MADE DURING OCT. 1999

- 1" IRON PIN FOUND
  - 5/8" REBAR & YELLOW PLASTIC CAP STAMPED "XYZ 7408" (SET)
  - P K NAIL
- ALL MONUMENTS FOUND OR SET ARE IN GOOD CONDITION UNLESS OTHERWISE NOTED.

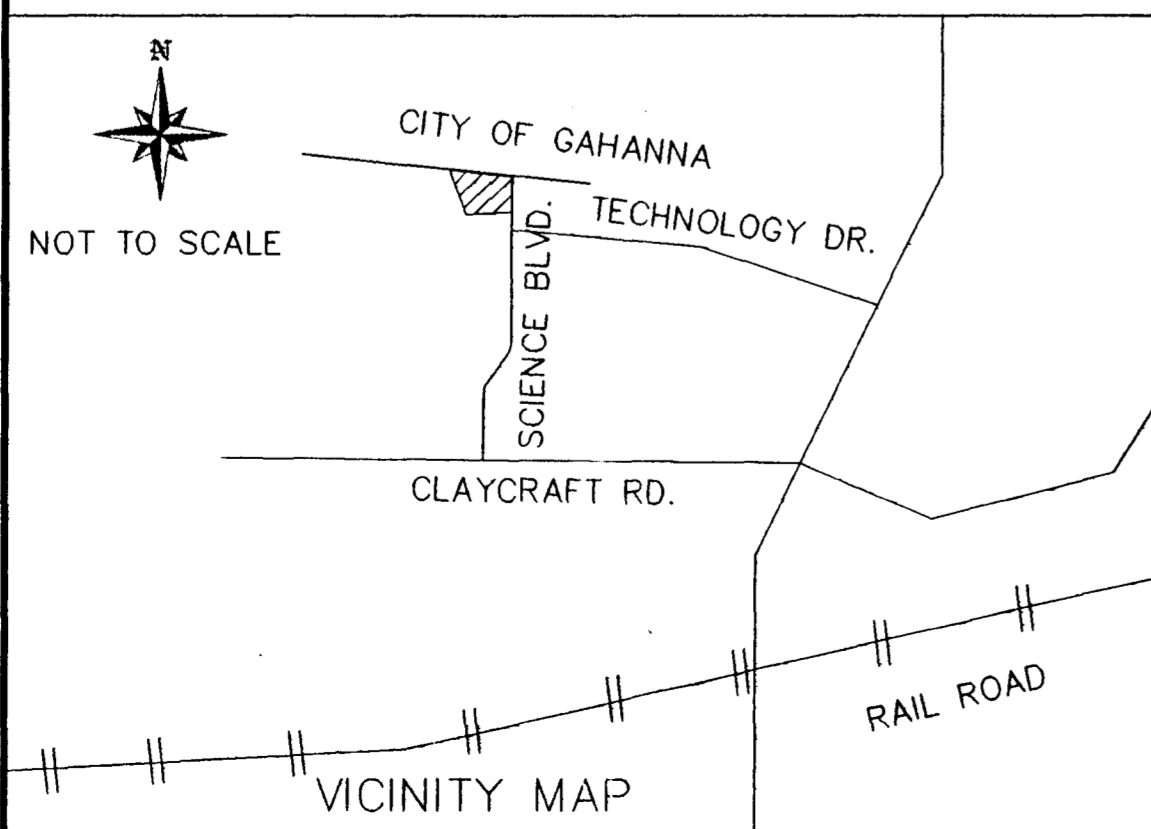

By: David E. Slagle 4-3-2000  
 DAVID E. SLAGLE PS# 7408

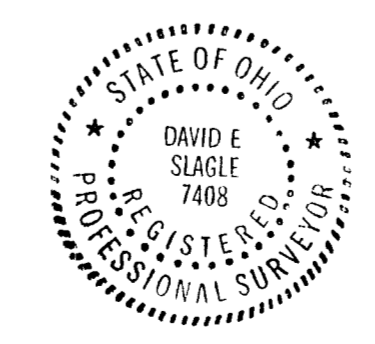

FOR: <b>TIM MEHAN</b>	
<b>XYZ</b>	DATE: 11/24/99
	SCALE: 1"=60'
	REVISED: 3/31/2000
JOB NO 99188	F.B NO FILE
MAP NO 99188	DRAWN BY: M.P.G.
	CKD BY: D.E.S.
	CAD FILE 99188

**SURVEY SERVICE INC.**  
 3958 La ROSA CT  
 GROVE CITY OH 43123  
 FAX: 614-875-6872 PH: 614-871-4980