


SURVEY OF ACREAGE PARCEL
SECTION 3, TOWNSHIP 1, RANGE 16
UNITED STATES MILITARY LANDS
CITY OF GAHANNA, FRANKLIN COUNTY, OHIO

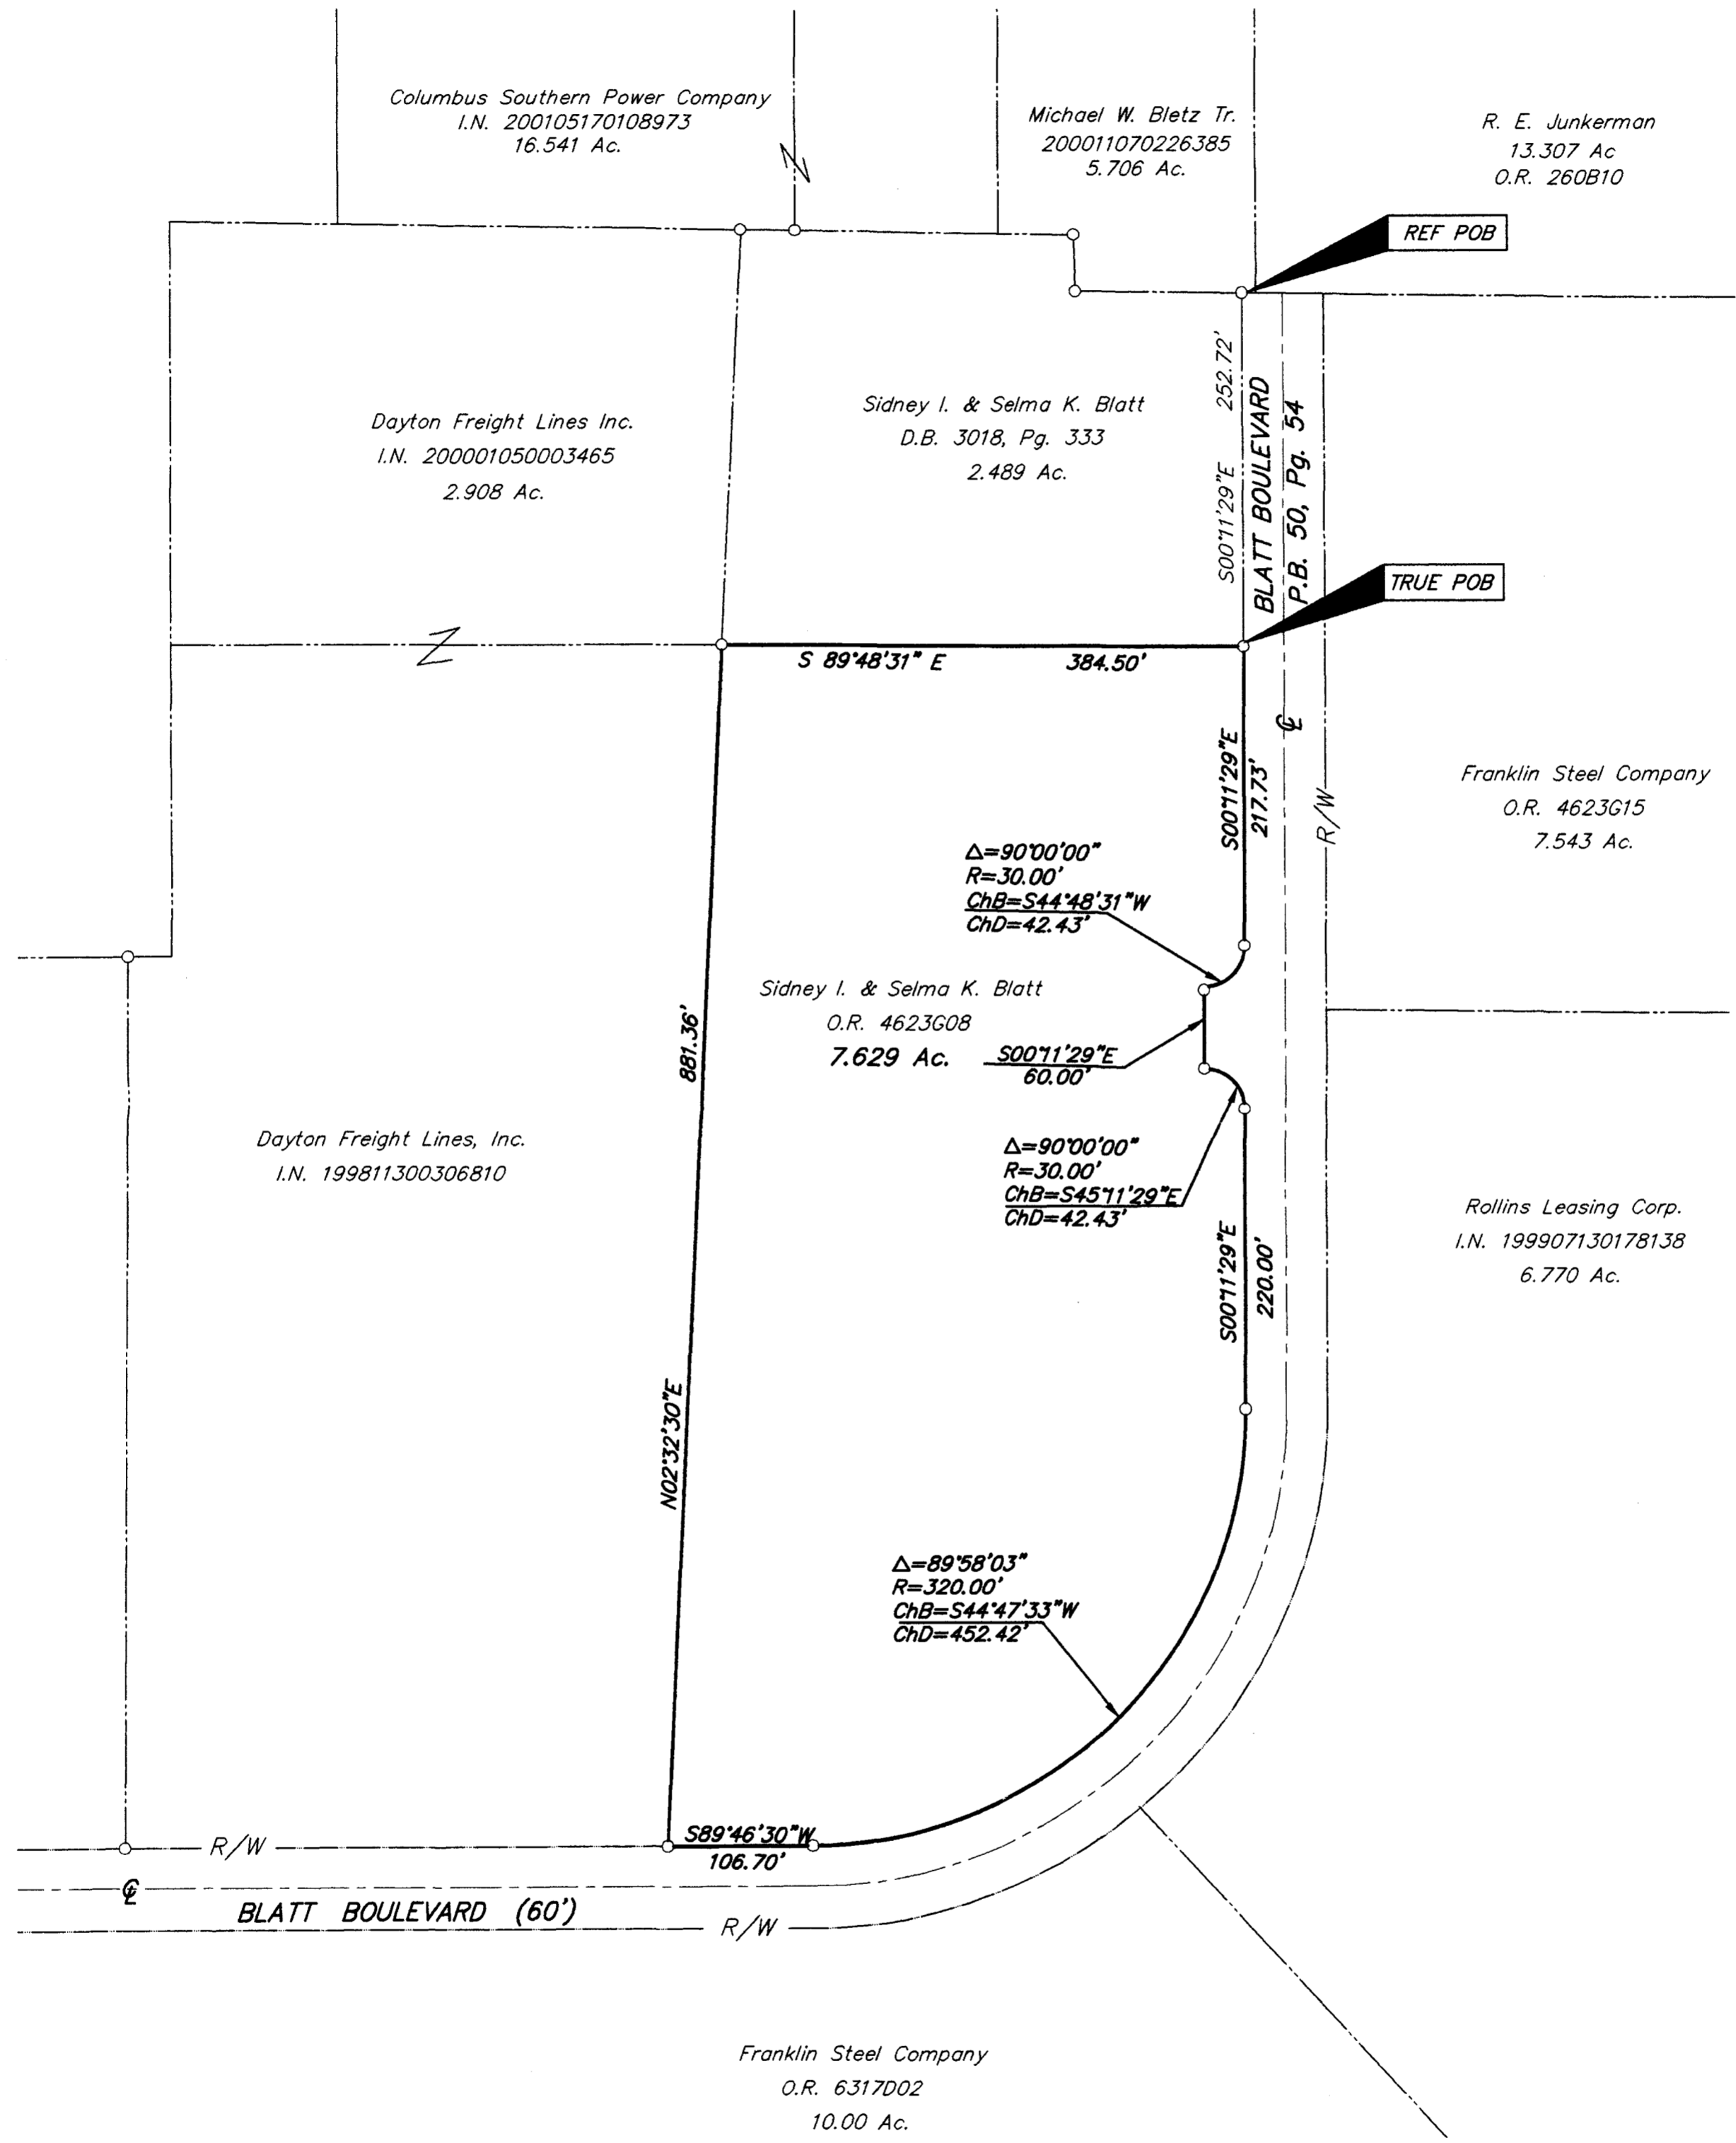

- = MON. FND.
- = I.P. FND.
- = I.P. SET
- = MAG. NAIL FND.
- = MAG. NAIL SET
- ▲ = R.R. SPK. FND.
- △ = R.R. SPK. SET
- = P.K. NAIL FND.

I.P.S Set are 13/16" I.D. Iron pipe W/ cap inscribed EMH&T, Inc.



GRAPHIC SCALE (IN FEET)

BASIS OF BEARINGS: The bearings shown hereon are based on the same meridian as the centerline of Blatt Boulevard being North 89° 46' 30" East of record in Plat Book 50, Page 54.



SURVEYED & PREPARED
 BY
EMH&T
 CONSULTING ENGINEERS & SURVEYORS
 170 MILL STREET
 GAHANNA, OHIO 43230
 (614) 471-5150

By Clark E. White
 Professional Surveyor No. 7868

SCALE: 1" = 100'
 Revised JUNE 26, 2001
 JUNE 28, 2001

Q:\PROJECT\20010802.01\DWG\10802b6.dwg - 0 XREFS - PLOTTED BY TBAUM - June 26, 2001 - 8:03 AM