

Survey of Lot 14 and a 0.457± acre tract adjoining (all as conveyed to Georgia A. Thrash in Official Records Volume 13808-F-06 and F-08 respectively, Recorder's Office, Franklin County, Ohio), and being in Section 4, Township 1, Range 16, United States Military Lands, Blacklick (formerly Smithville), Ohio.


For
M.S. GEORGIA A. THRASH

MULBERRY ST. 60'

POC. NORTH - 79.27' SOUTH - 183.72' NORTH - 227.81' (Meas.)

WALNUT ST. Spike (fd.)

BASIS OF BEARINGS : E of Mulberry St. assumed NORTH.

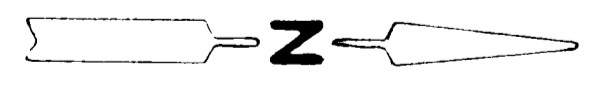

Scale 1" = 20'

January 15, 1990


Revised August 15, 1990

We hereby certify that the foregoing plat was prepared from an actual survey of the premises made in January, 1990 and is correct to the best of our knowledge.
 Iron pins set are 30"x1"(O.D.) with orange plastic caps inscribed P.S. 6579

Albert J. Myers

Myers Surveying
 COMPANY

2740 East Main Street
 Bexley, Ohio 43209
 (614) 235-8677
 Telefax 235-4689

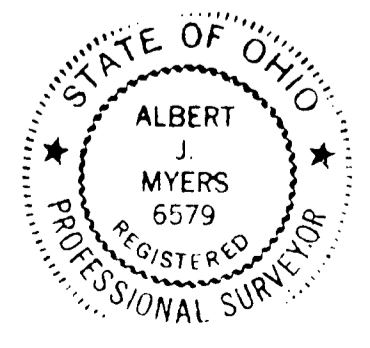

1000-13808-13001