


SURVEY OF ACREAGE PARCEL
 LOCATED IN
SECTION 5, TOWNSHIP 16, RANGE 20
REFUGEE LANDS
 CITY OF REYNOLDSBURG, FRANKLIN COUNTY, OHIO

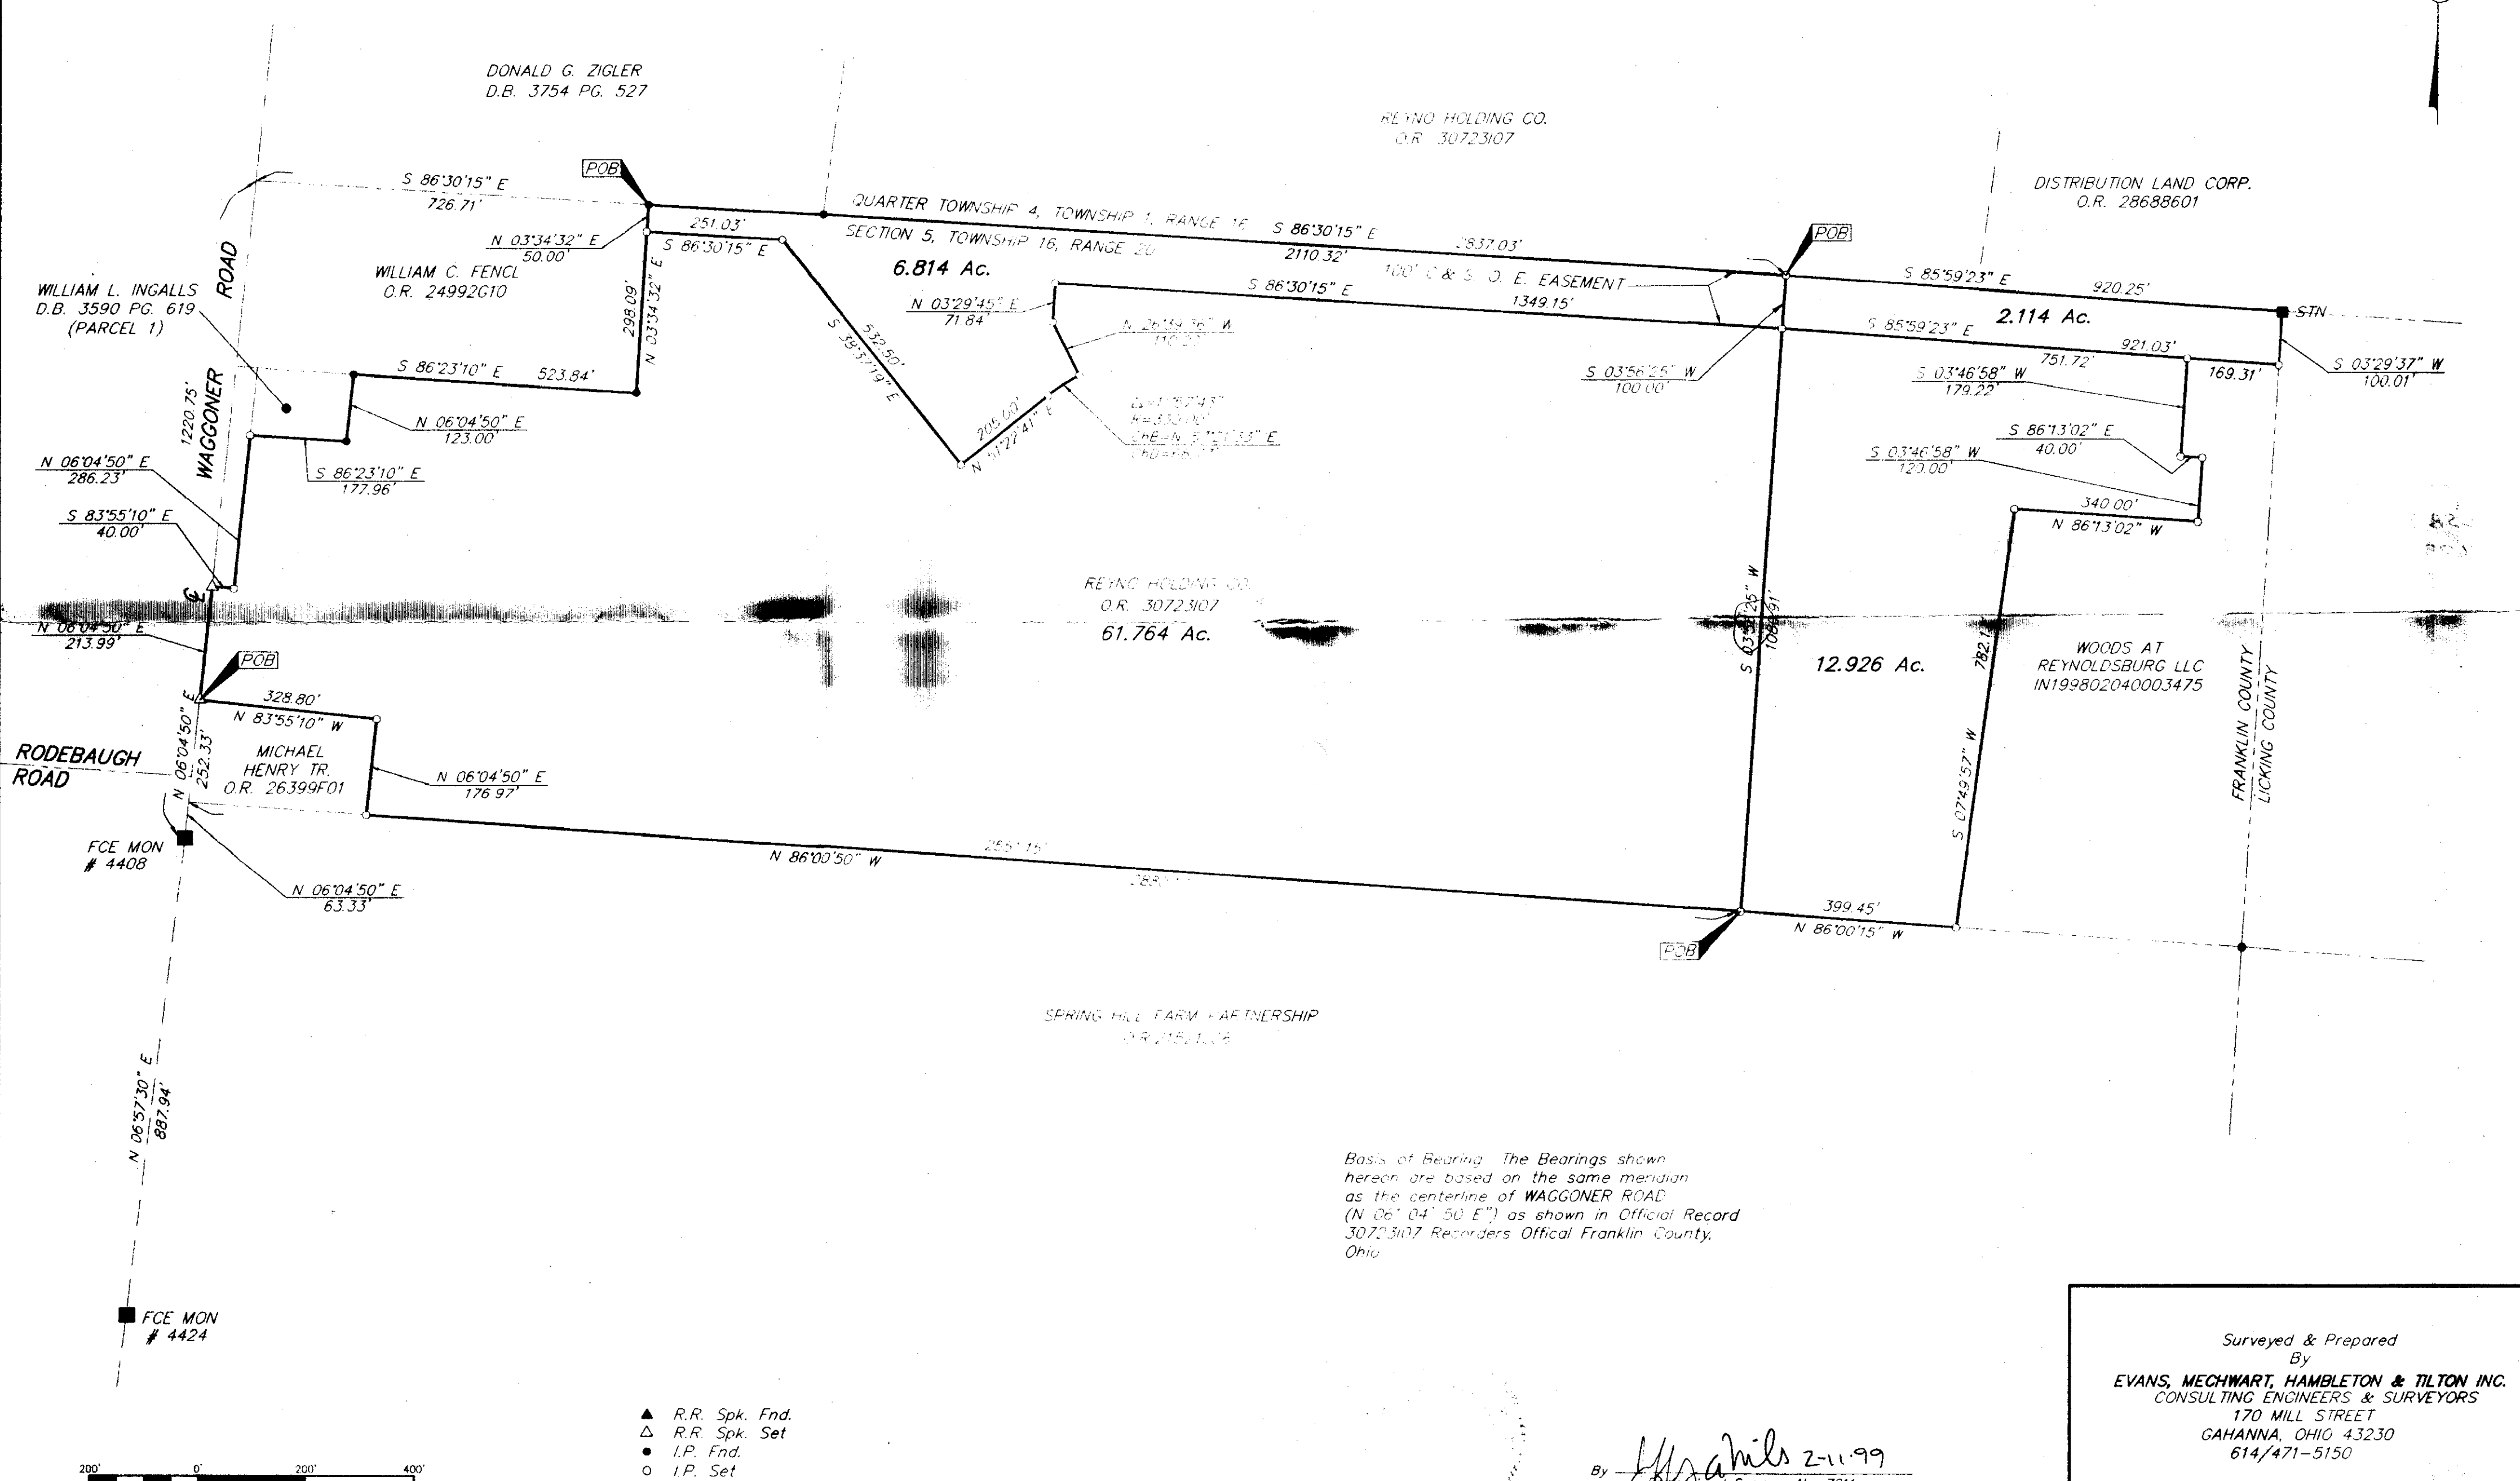

Basis of Bearing: The Bearings shown herein are based on the same meridian as the centerline of WAGGONER ROAD (N 06° 04' 50" E") as shown in Official Record 30723107 Recorders Office Franklin County, Ohio.

- ▲ R.R. Spk. Fnd.
- △ R.R. Spk. Set
- I.P. Fnd.
- I.P. Set



GRAPHIC SCALE
(IN FEET)

I.P. set are 3/4" O.D. Iron Pin
30" long w/cap inscribed EMH&T.

By *[Signature]* 2-11-99
Professional Surveyor No. 7211

Surveyed & Prepared
By
EVANS, MECHWART, HAMBLETON & TILTON INC.
 CONSULTING ENGINEERS & SURVEYORS
 170 MILL STREET
 GAHANNA, OHIO 43230
 614/471-5150

SCALE: 1" = 200' FEBRUARY 11, 1999

11:58PM - 4/1 SURVEY PROJECT P02072.DWG P2072B/DWG - 0 ARCS - PLOTTED BY J.BUSHBY - February 11, 1999 - 6:57 AM