REVISIONS:			
1	Sept. 21, 1999	Boundary	mdf
No.	Date	Description	By

Boundary Survey of 5.100 Acres located in
Half Section 6, Township 16, Range 20, Refugee Lands,
Truro Township, Franklin County, Ohio, for...

Bob and Jenny Eversole

120' 90' 60' 30' 0' 60' 120'

Scale 1" = 60'

February 9, 1999

N

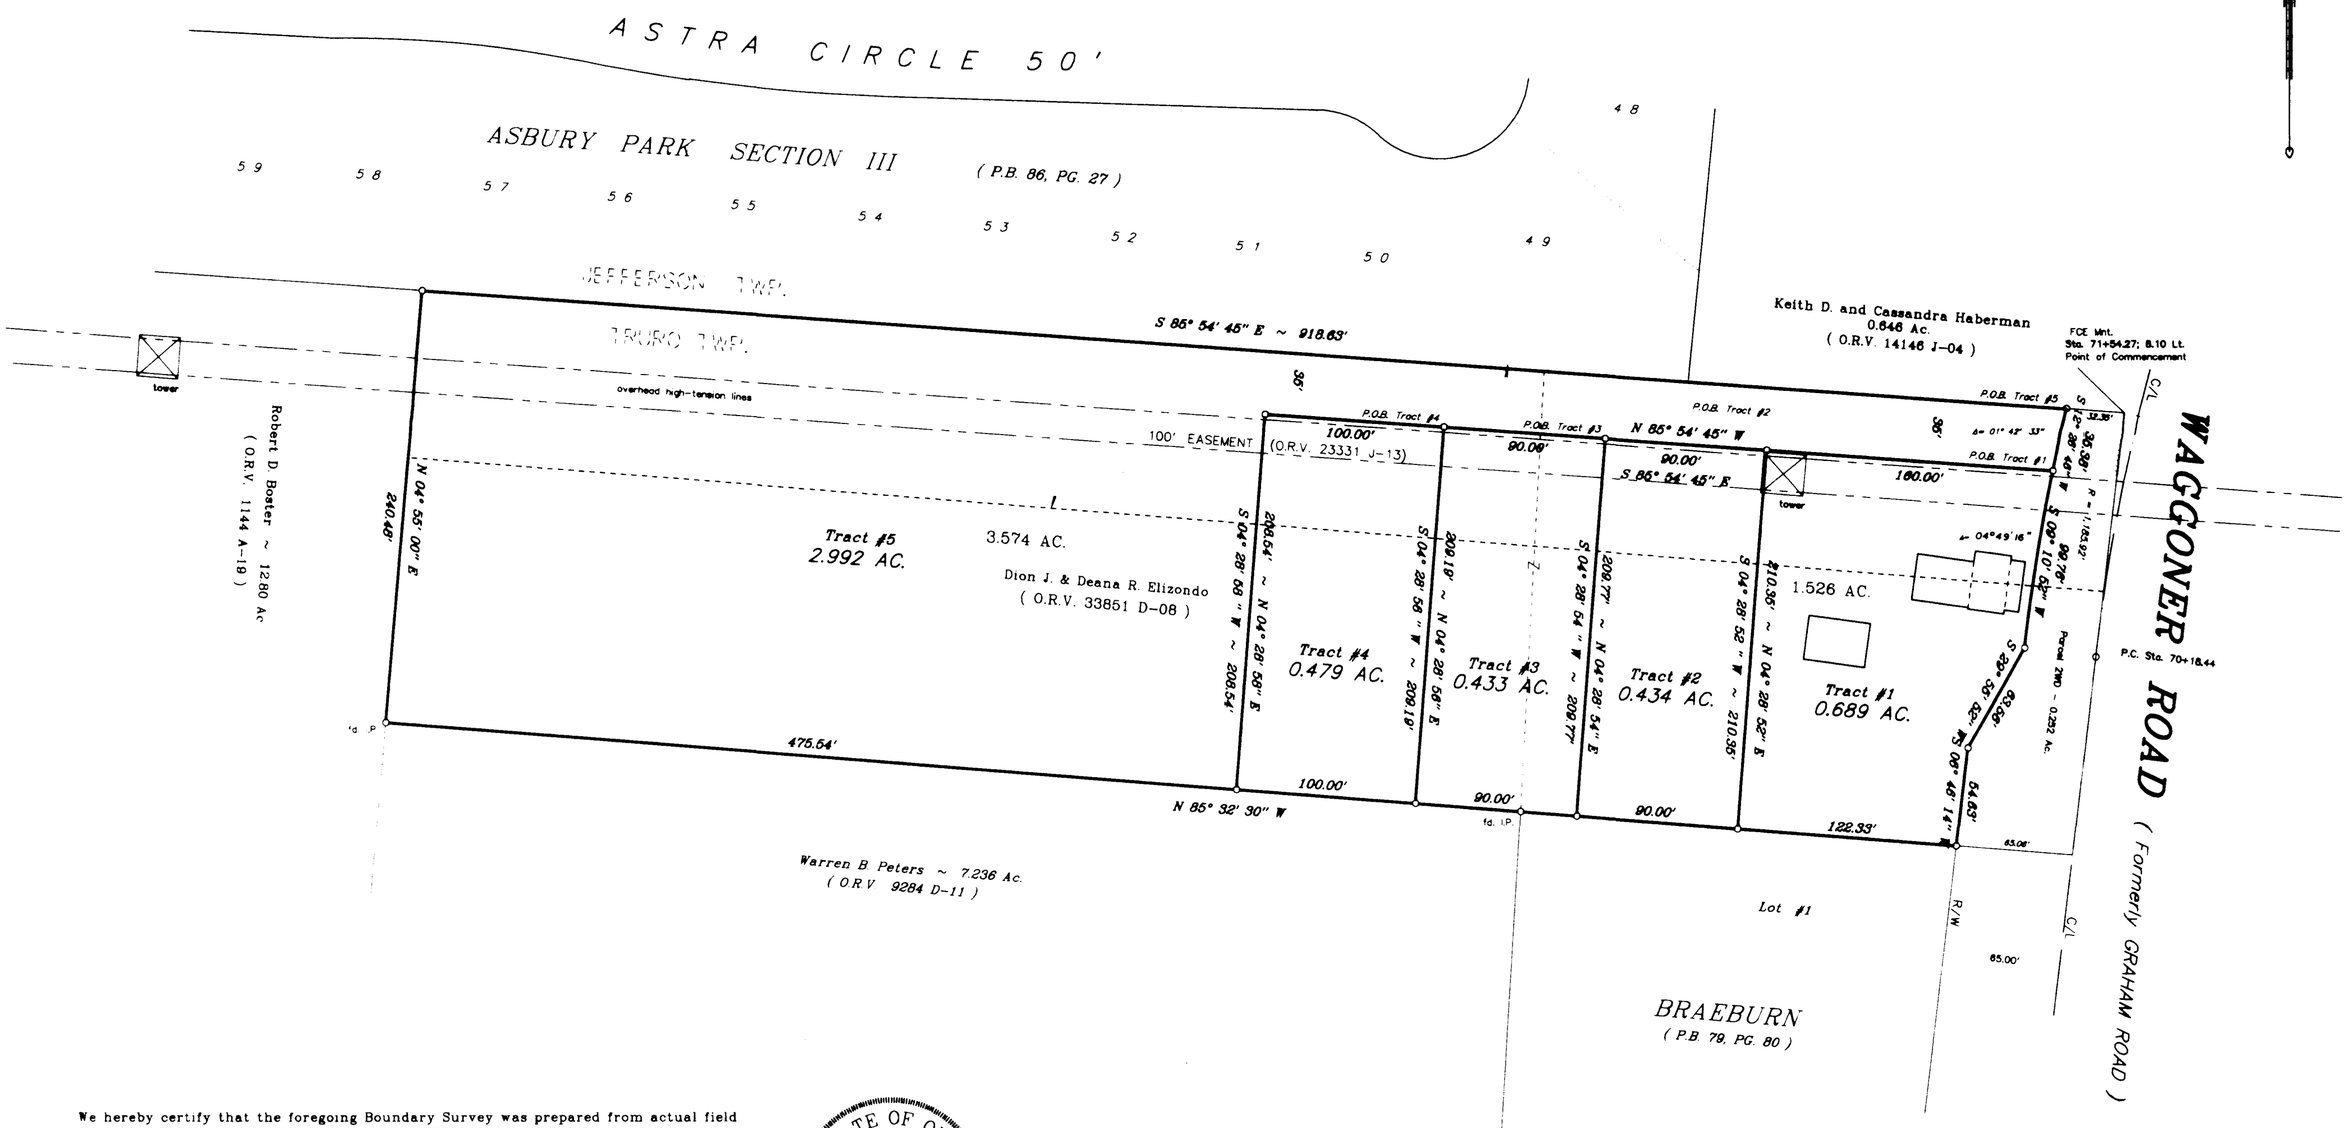

We hereby certify that the foregoing Boundary Survey was prepared from actual field measurements in accordance with Chapter 4733-37, Ohio Administrative Code. Iron pipes set are 30" X 1" (O.D.) with an orange plastic caps inscribed "P.S. 6579" Basis of bearings is the centerline of Waggoner Road held as N 06° 46' 14" E, as shown on right-of-way plans for Waggoner Road, TRU-106-2.18, sheet 31 of 33, on file in Franklin County Enginerr's Office

BY Matthew D Farley

Matthew D. Farley, Professional Surveyor No. 7566

STATE OF OHIO
MATTHEW D. FARLEY
7566
REGISTERED
PROFESSIONAL SURVEYOR

Myers Surveying COMPANY
2740 East Main Street
Bexley, Ohio 43209-2577
(614) - 235 - 8677

All iron pipes shown are set unless otherwise noted