

# SURVEY OF ACREAGE PARCELS LOCATED IN SECTION 5, TOWNSHIP 16, RANGE 20 REFUGEE LANDS CITY OF REYNOLDSBURG, FRANKLIN COUNTY, OHIO



Donald G. Zigler  
D.B. 3754 PG. 527

Reyno Holding Co.  
O.R. 30723107

Distribution Land Corp.  
O.R. 28688601

William C. Fencil &  
Elaine M. Fencil  
O.R. 24992G10  
O.R. 03918G09


QUARTER TOWNSHIP 4, TOWNSHIP 1, RANGE 16  
SECTION 5, TOWNSHIP 16, RANGE 20

6.815 Ac.

Reyno Holding Co.  
O.R. 30723107

2.114 Ac.  
Reyno Holding Co.  
O.R. 30723107

FRANKLIN COUNTY  
LICKING COUNTY

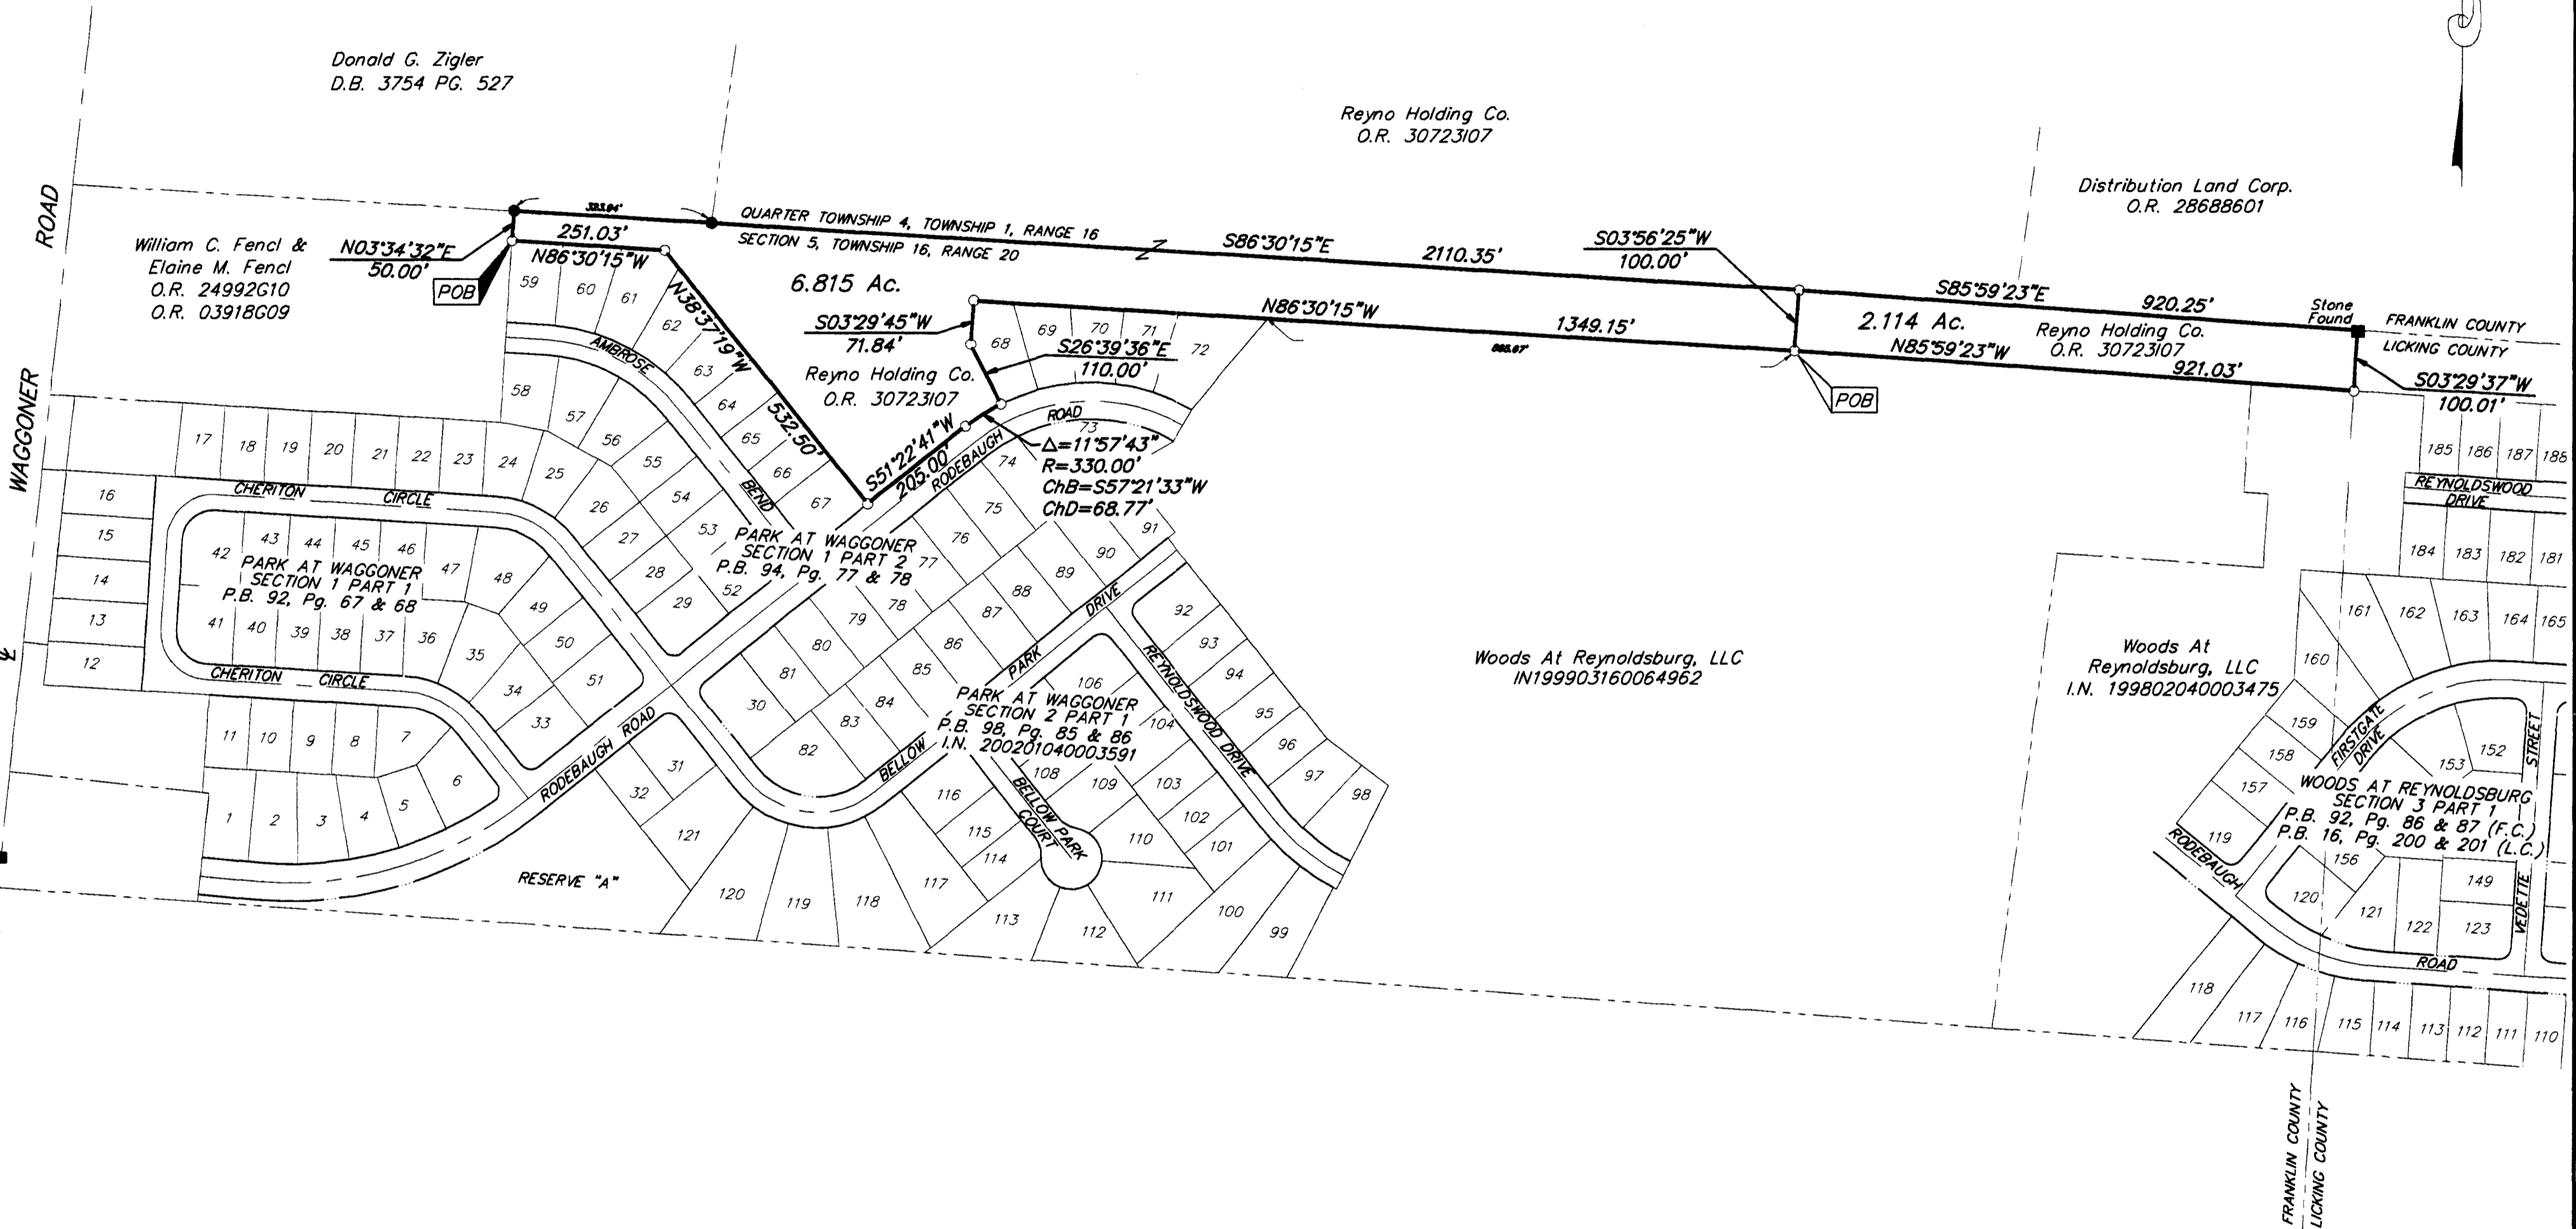

Woods At Reynoldsburg, LLC  
IN199903160064962


Woods At Reynoldsburg, LLC  
I.N. 199802040003475

WOODS AT REYNOLDSBURG  
SECTION 3 PART 1  
P.B. 92, Pg. 86 & 87 (F.C.)  
P.B. 16, Pg. 200 & 201 (L.C.)

Basis of Bearing: The Bearings shown hereon are based on the same meridian as the centerline of WAGGONER ROAD (N 06° 04' 50" E") as shown in Official Record 30723107 Recorders Office Franklin County, Ohio

- = MON. FND.
- = I.P. FND.
- = I.P. SET
- = MAG. NAIL FND.
- = MAG. NAIL SET
- ▲ = R.R. SPK. FND.
- △ = R.R. SPK. SET
- = P.K. NAIL FND.

I.P.S. Set are 1 3/16" I.D. Iron pipe w/ cap inscribed EMHT INC

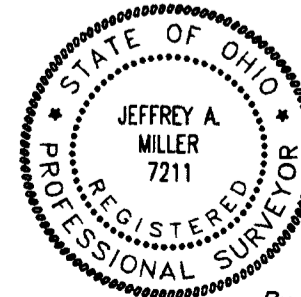

By *Jeff Miller* 3-11-02  
Professional Surveyor No. 7211

Surveyed & Prepared By  
EVANS, MECHWART, HAMBLETON & TILTON INC.  
CONSULTING ENGINEERS & SURVEYORS  
170 MILL STREET  
GAHANNA, OHIO 43230  
614/471-5150

SCALE: 1" = 200' MARCH 11, 2002



GRAPHIC SCALE (IN FEET)

C:\PROJECT\20020362.01\DWG\2072BV.DWG - O XREFS - PLOTTED BY MGREEN - March 04, 2002 - 4:35 PM