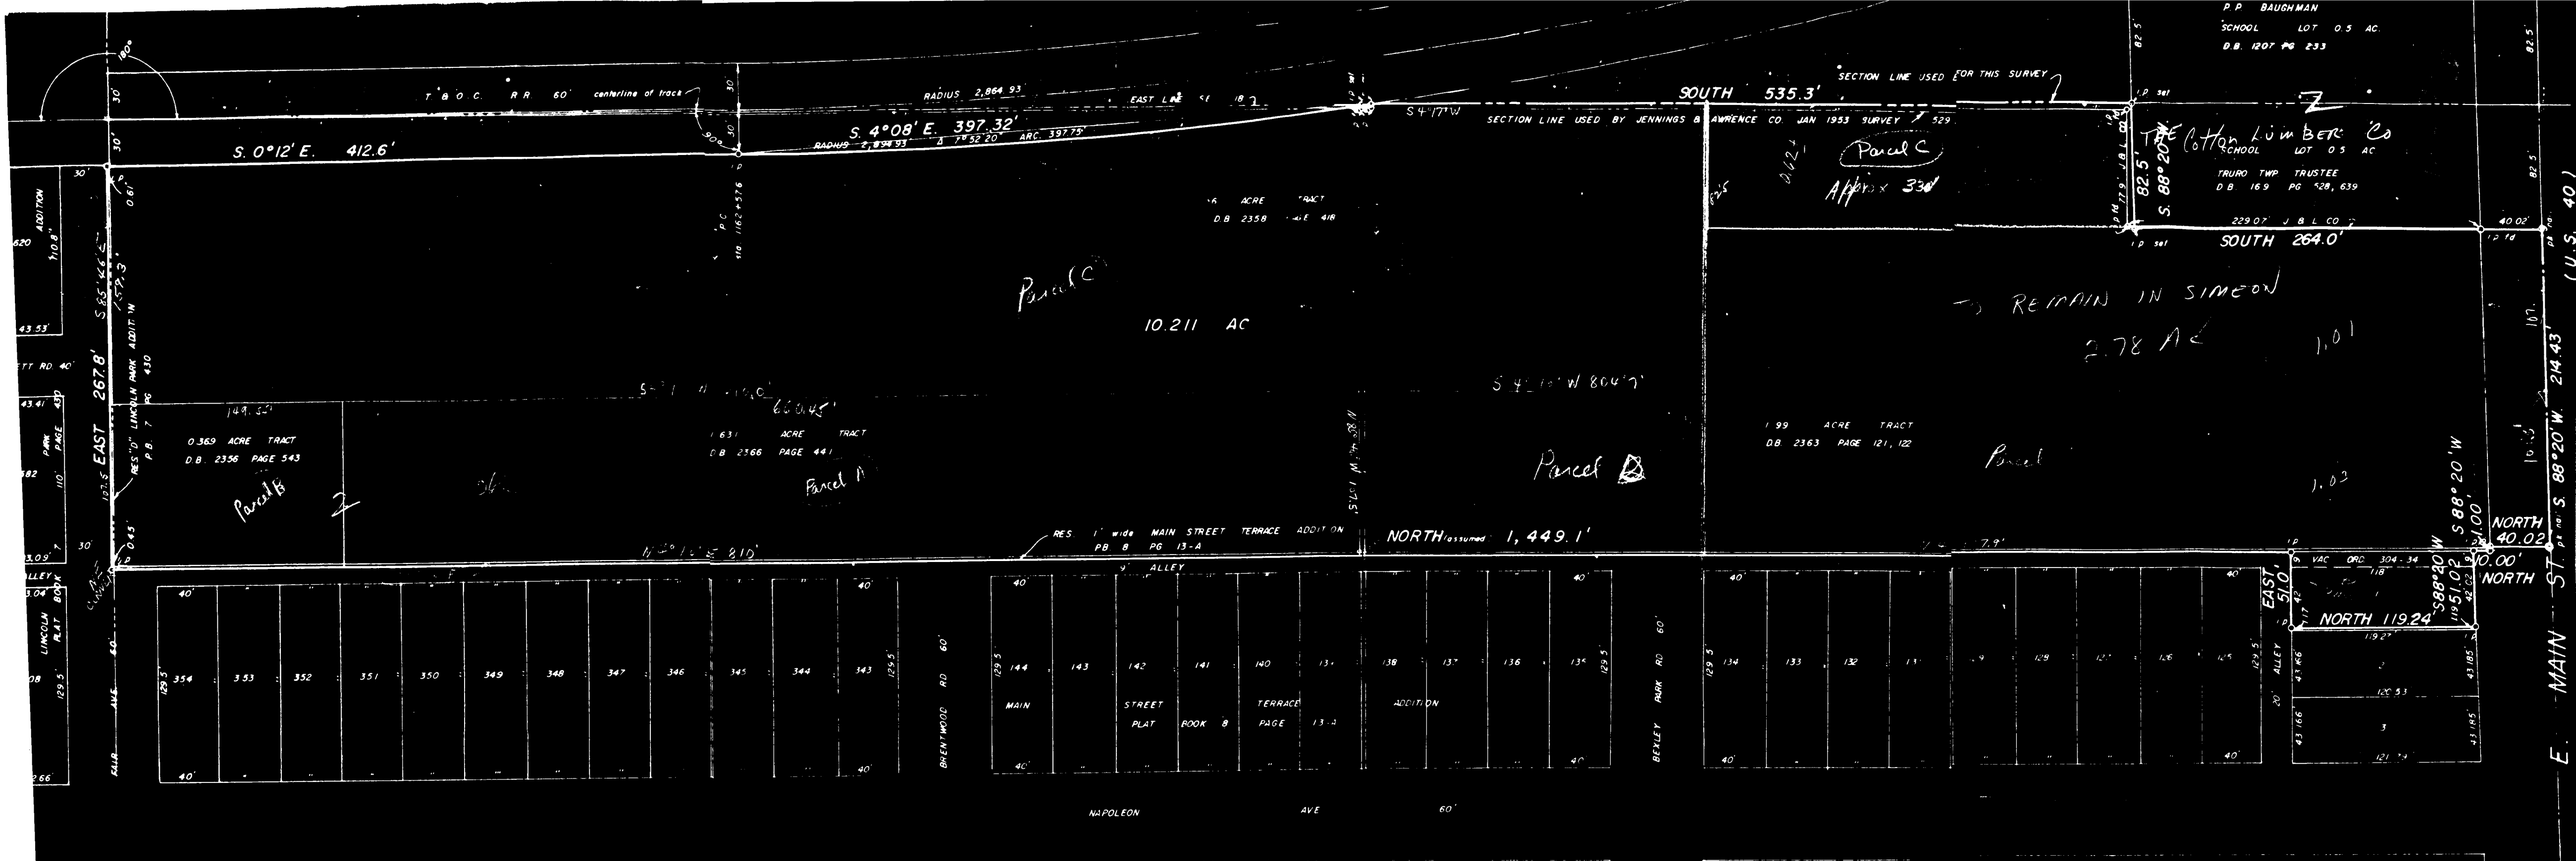

Report of survey of a part of ½ SEC. 29, Section 18, Township 12, North, Range 21 West, Refugee Lands, and being all of a 6 acre tract, and Reserve "D" Lincoln Addition (P.B. 7 Pg. 430), in D.B. 2358 Pg. 418, and all of a 1.99 acre tract, and 42' off the east side of Lot 1 of Main Street Terrace Addition (P.B. 8 Pg. 13-A), and all of an alley lysterly of and contiguous to said Lot 1 and Vacated by City of Columbus Ordinance No. 304-34, and all of a 1' wide by about 128' strip of land being a reservation of said Main Street Terracdition in D.B. 2363 Pg. 121, 122, and being all of a Reserve 1' wide by 1,449.55'± off the east side of said Main Street Terrace Addition in D.B. 2363 Pg. 124, and being all of a 0.369 acre tr D.B. 2356 Pg. 543, and all of a 1.631 acre tract in D.B. 2366 Pg. 441, Recorder's Office, Franklin County, Ohio in the City of Columbus, Ohio. All the above tracts of land are deeded Simeon Realty Company.

MARCH 23, 1962.

Scale 1" = 50'

for

1" = 50'

The direction of the west line of said 1' reserve was assumed to be NORTH and SOUTH for the purpose of this survey only, and all bearin used are relative to each other only.

...reby certify that the foregoing ...represents a true return of ...vey made by me in MAR. 1962.

...ERS SURVEYING CO.
...l Engineers & Surveyors
...mbus, Ohio

2910 120 1962 003 ...EON REALTY CO.