





E. MAIN STREET (80' R/W)

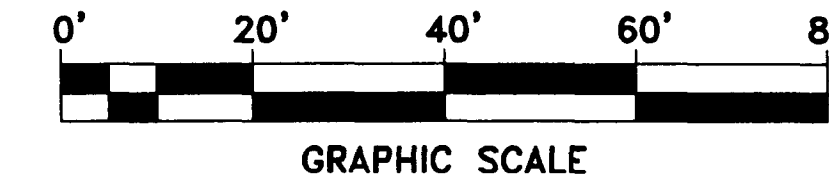


LEGEND

- San. — Sanitary Sewer
- St. — Storm Sewer
- W — Water Main
- G — Gas Line
- U/C — Underground Cables
- O/L — Overhead Lines
- Manhole
- ⊠ Storm Inlet
- ⊙ Fire Hydrant
- ⊕ Utility Pole
- Guy Wire
- x-x- Fence
- △ Sign
- Valve Box
- Gas Line Marker
- Telephone Closure
- I.P.S. ⚡ Iron Pin Set

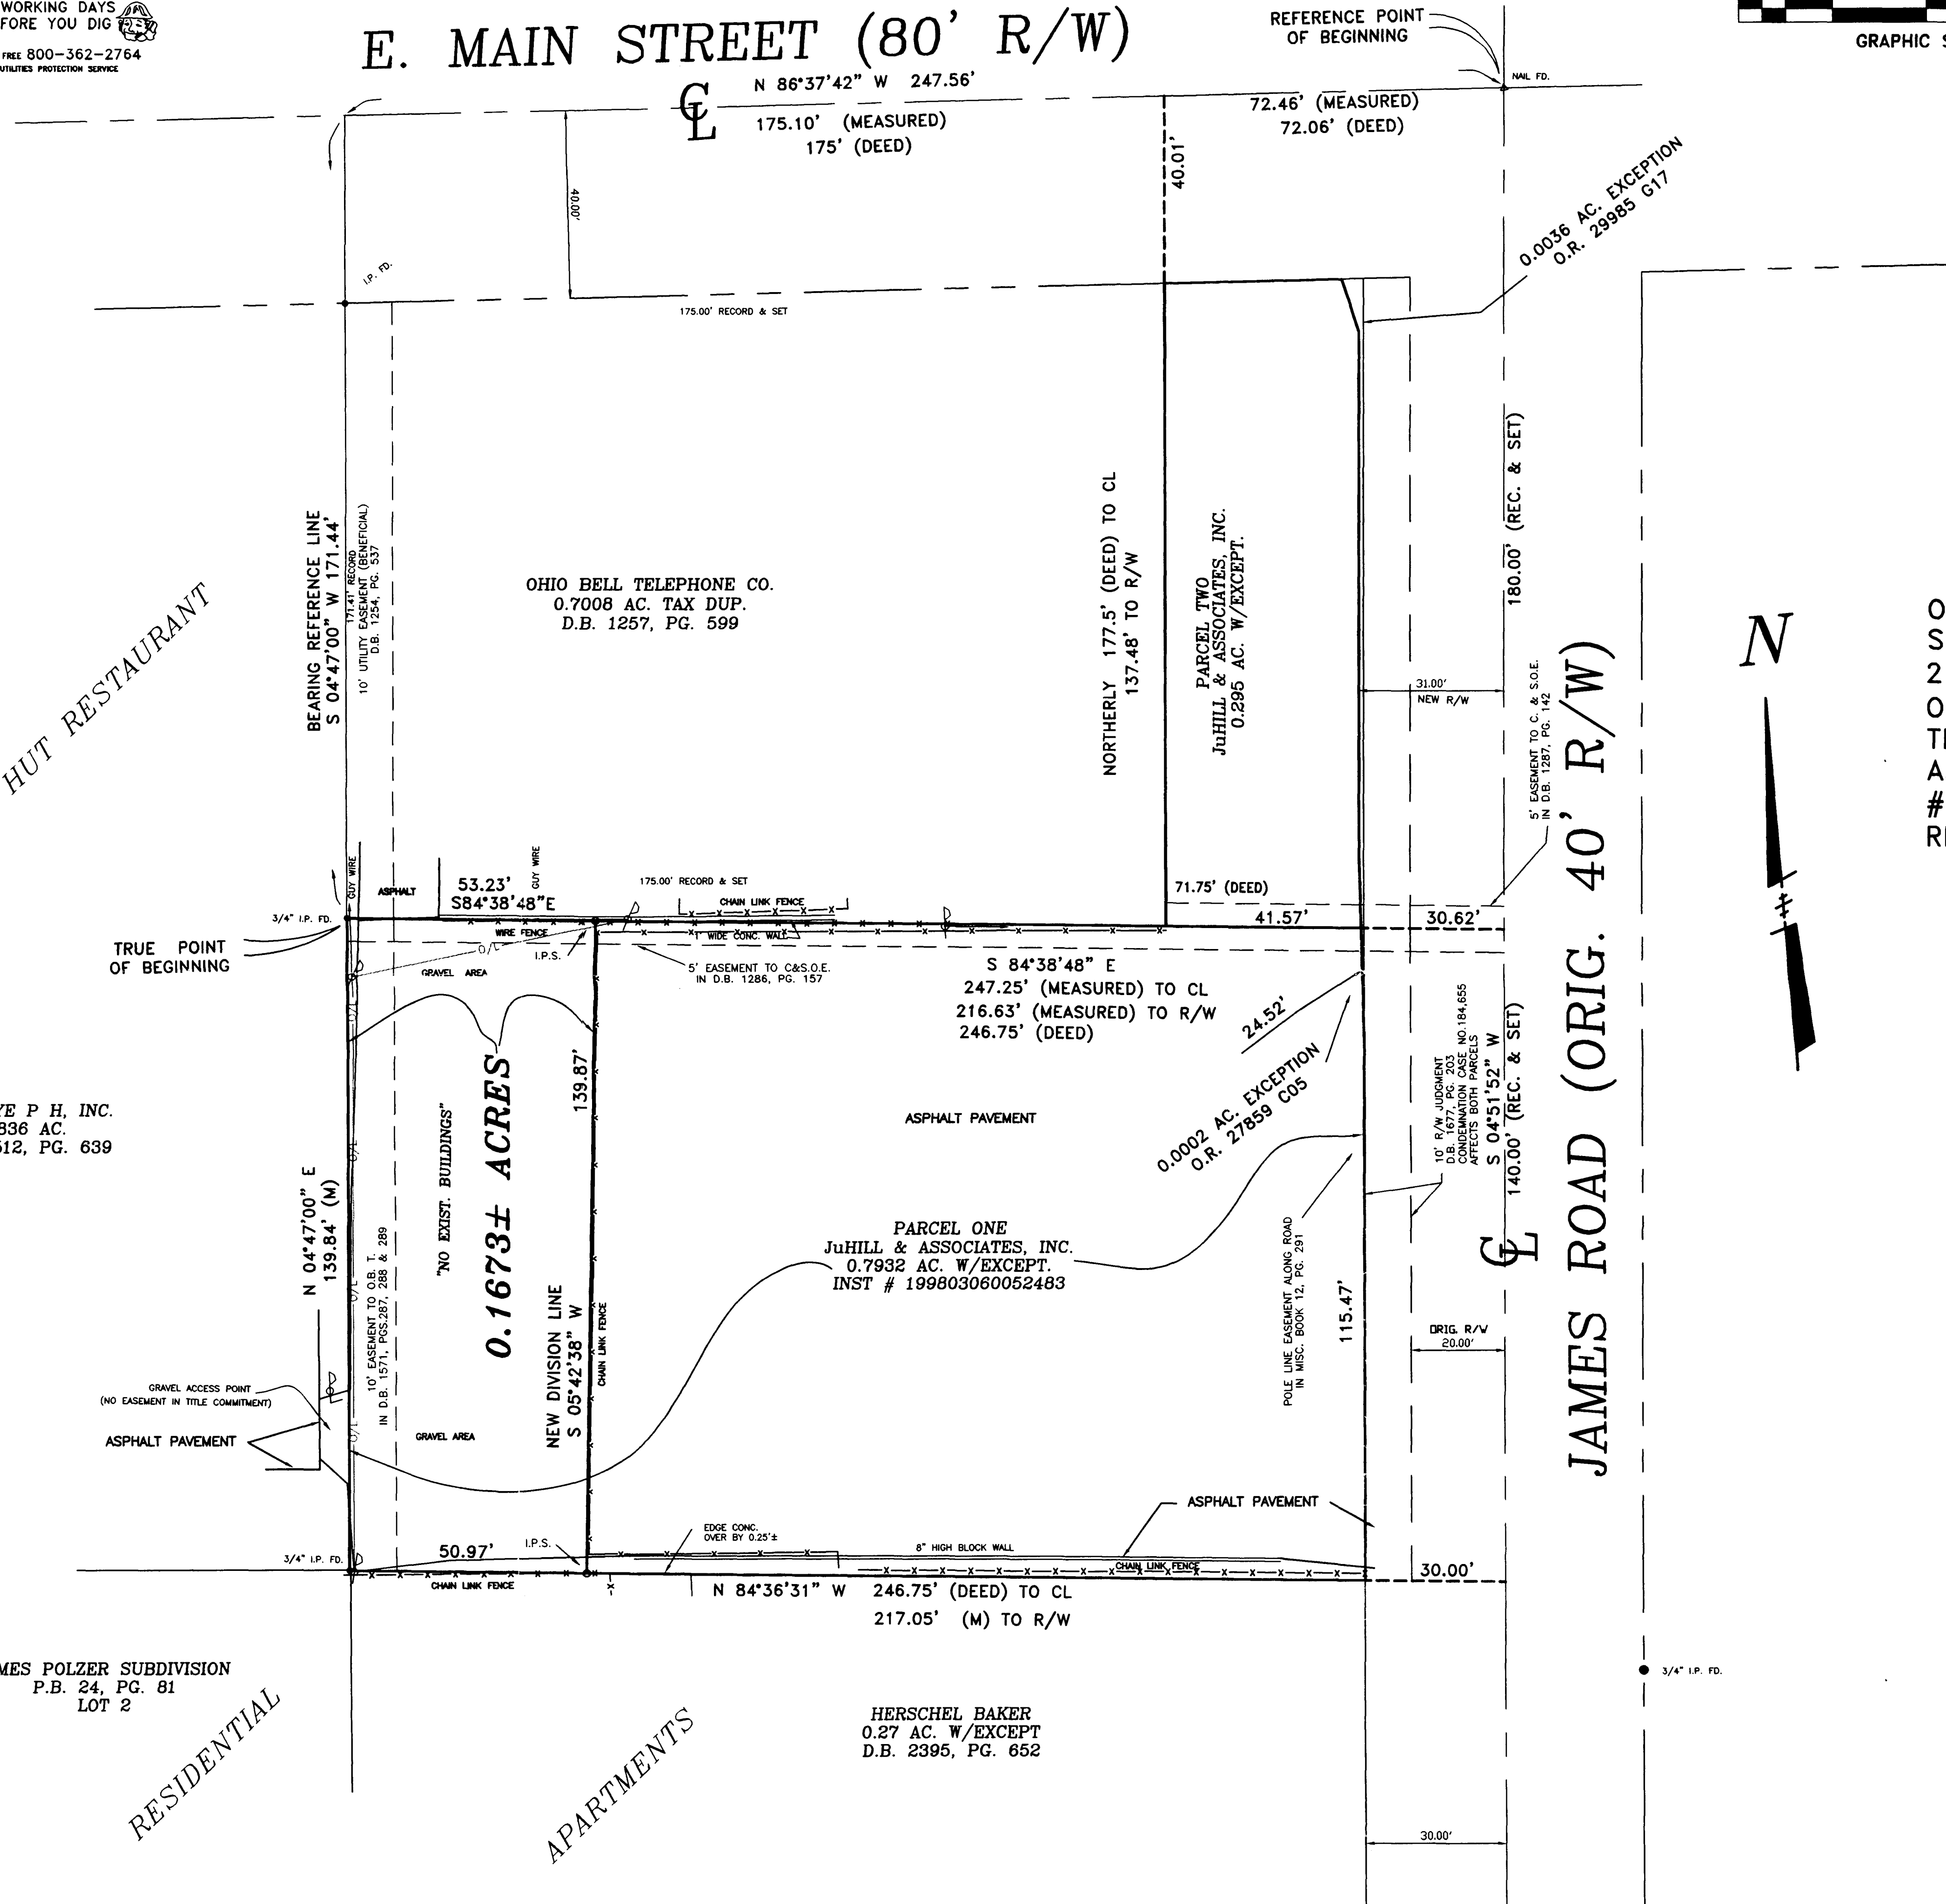

SITE ENGINEERING, INC.
CONSULTING ENGINEERS & SURVEYORS

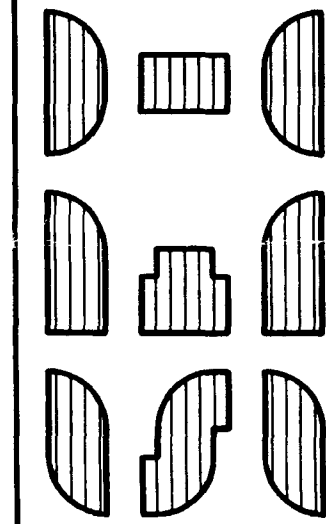


JuHILL & ASSOCIATES, INC.

3111 E. MAIN ST. COLUMBUS, OHIO
LOT SPLIT SURVEY

REVD:	REVD:
JAN. 99	
JULY 99	
DATE:	FEB. 98
SCALE:	1"=20'
DRAWN:	S.E.I.
CHECKED:	M.A.H.
FILE:	SHEET:
2656	1/1

SITE ENGINEERING, INC.
Mark A. Hazel, p.s.
 BY PROFESSIONAL SURVEYOR NO. 7039

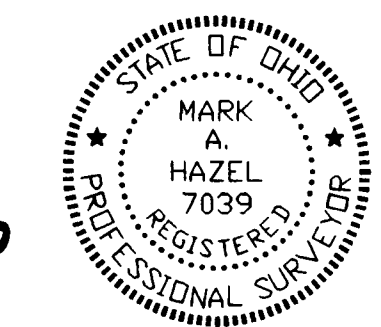

Any information or data on this drawing is not intended to be suitable for reuse by any person, firm or corporation or any others on extensions of this project or for any use on any other project. Any reuse without written verification and adaption by the Engineer, Architect or Surveyor for the specific purpose intended will be at the users sole risk and without liability or legal exposure to the Engineer, Architect or Surveyor.