


SURVEY OF ACREAGE PARCEL
LOCATED IN NORTHEAST QUARTER SECTION 17, TOWNSHIP 12, RANGE 21,
REFUGEE LANDS
CITY OF WHITEHALL, FRANKLIN COUNTY, OHIO

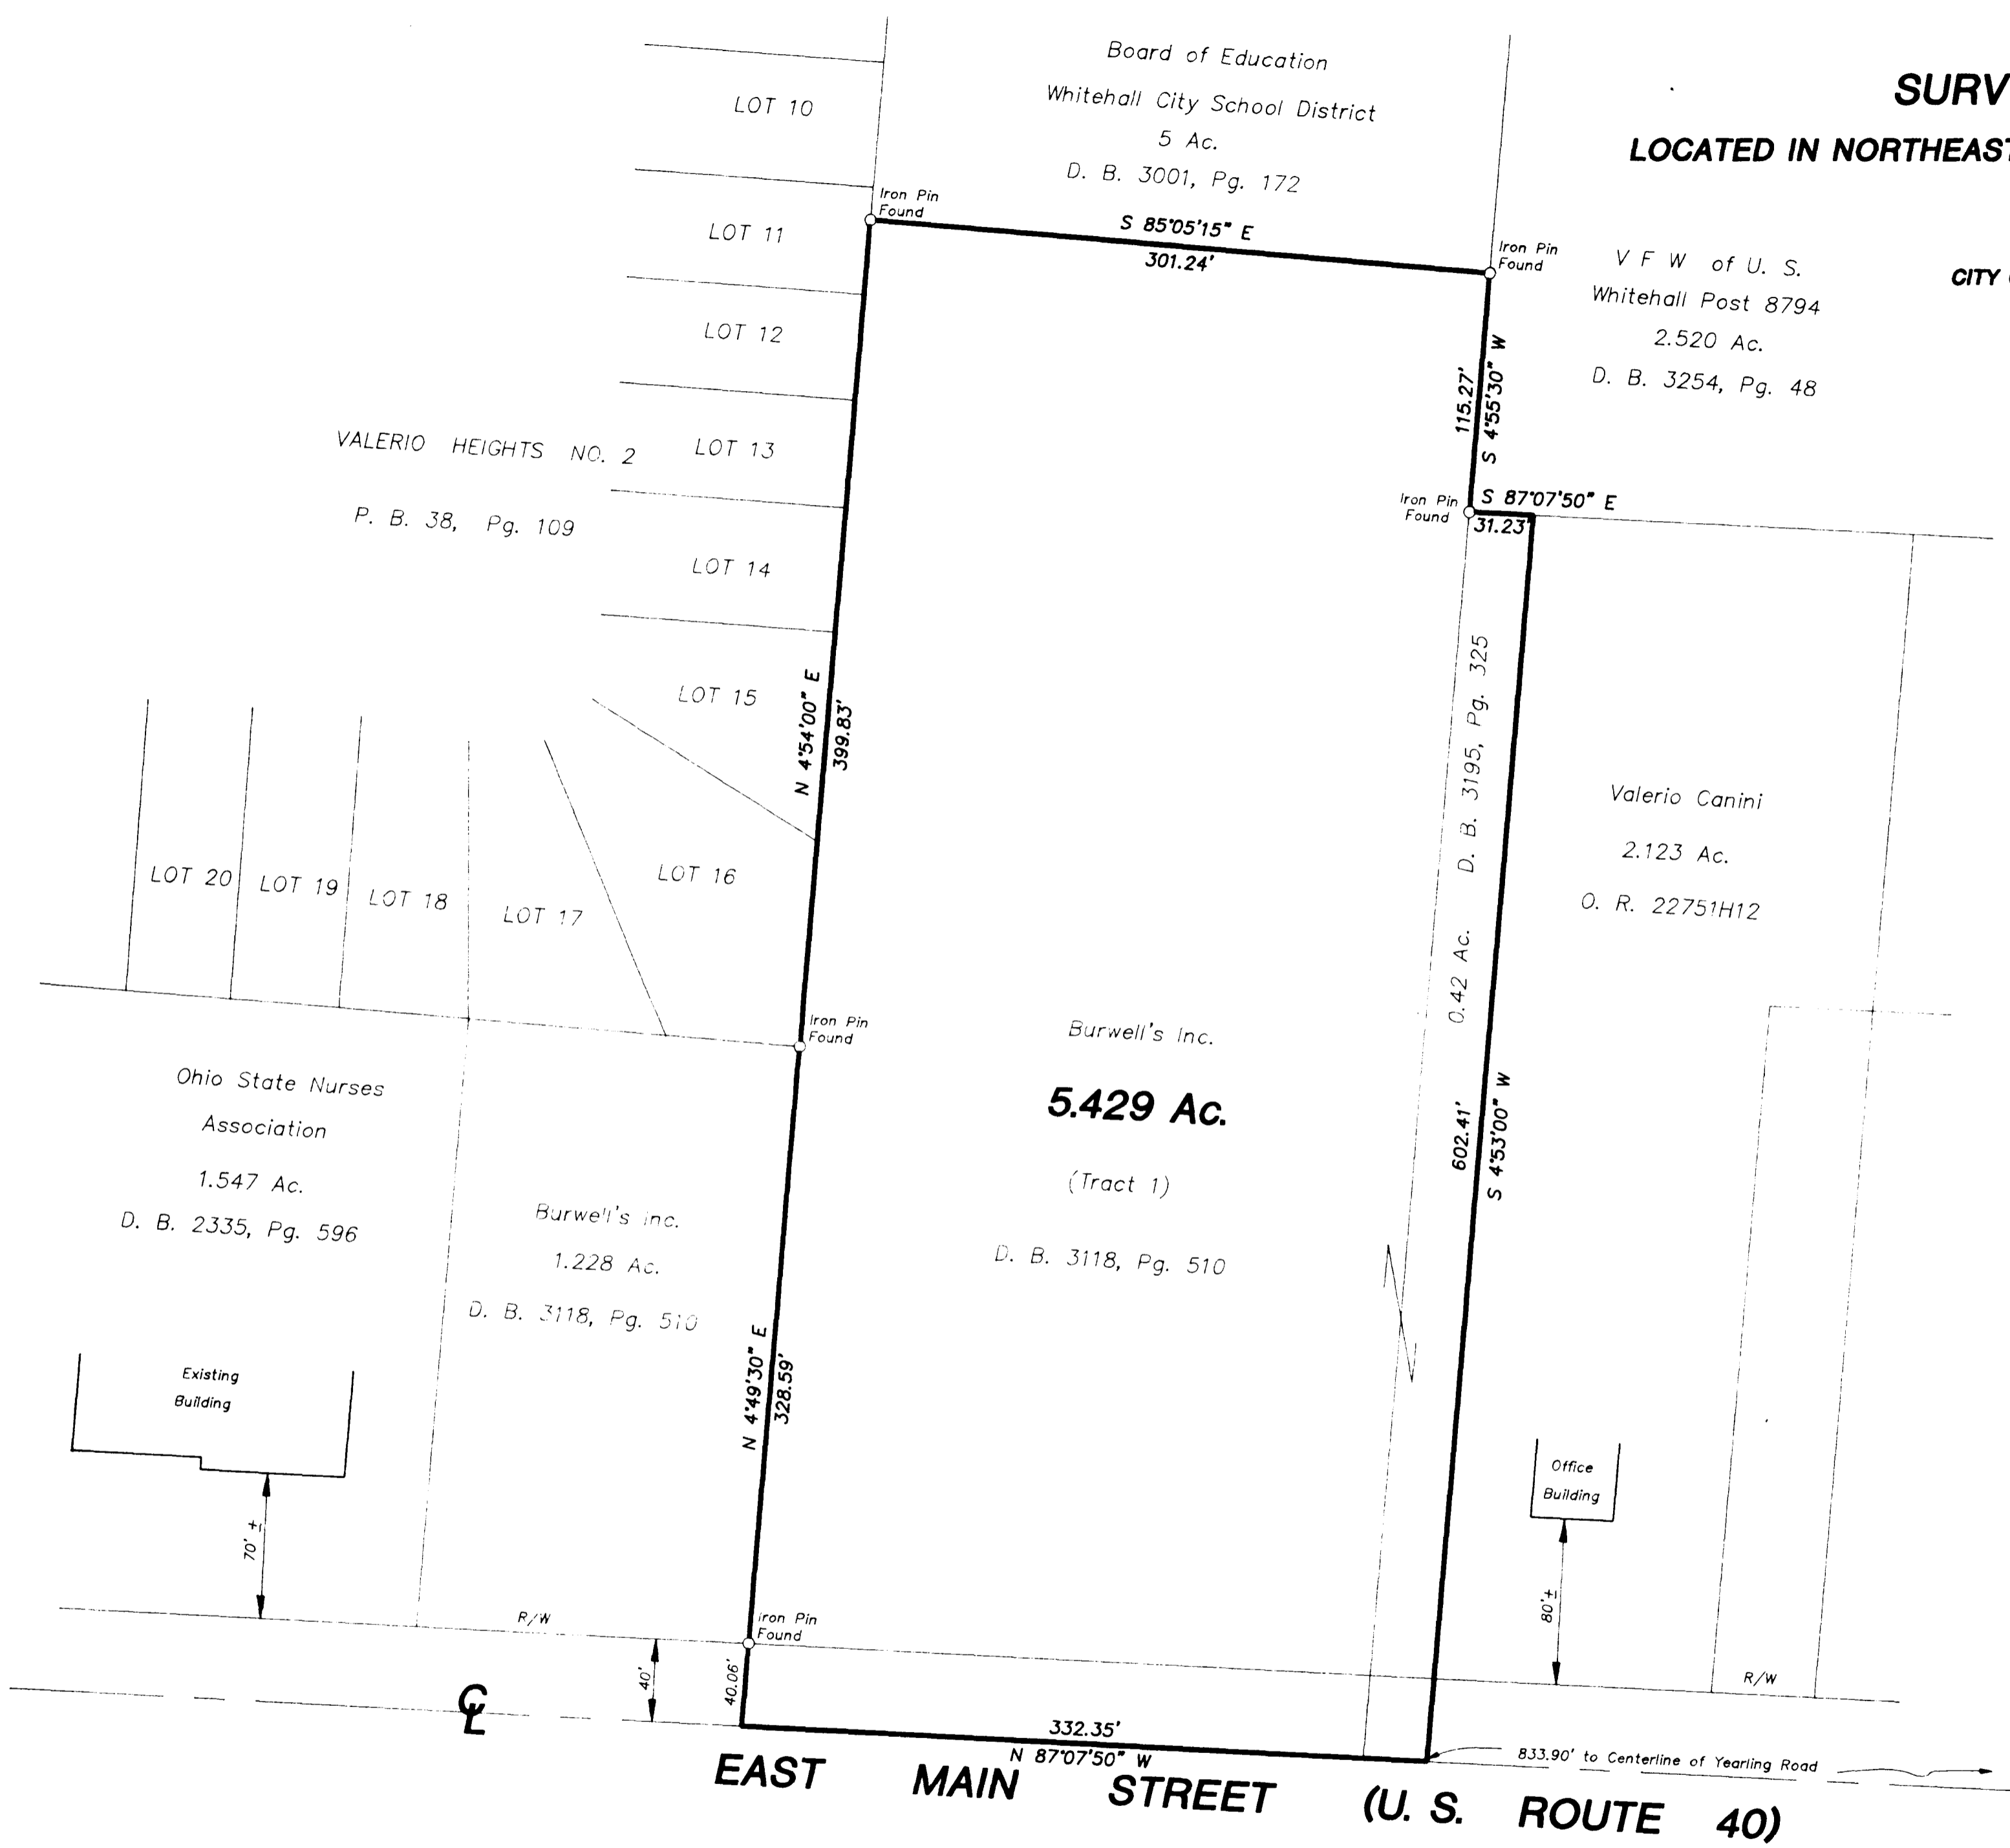

Surveyed & Platted
 By
EVANS, MECHWART, HAMBLETON, & TILTON INC.
 CONSULTING ENGINEERS AND SURVEYORS
 170 MILL STREET
 GAHANNA, OHIO 43230
 614/471-5150

By *Thomas D. Sibbalds*
 Thomas D. Sibbalds
 Registered Surveyor No. 5908
 SCALE 1" = 60' AUGUST 12, 1994

GRAPHIC SCALE 1" = 60'

NOTE:
 The bearings shown hereon are based on the same meridian as the centerline of East Main Street (N 87° 07' 50" W) of record in Deed Book 3118, Pg. 510.