


N-82-D

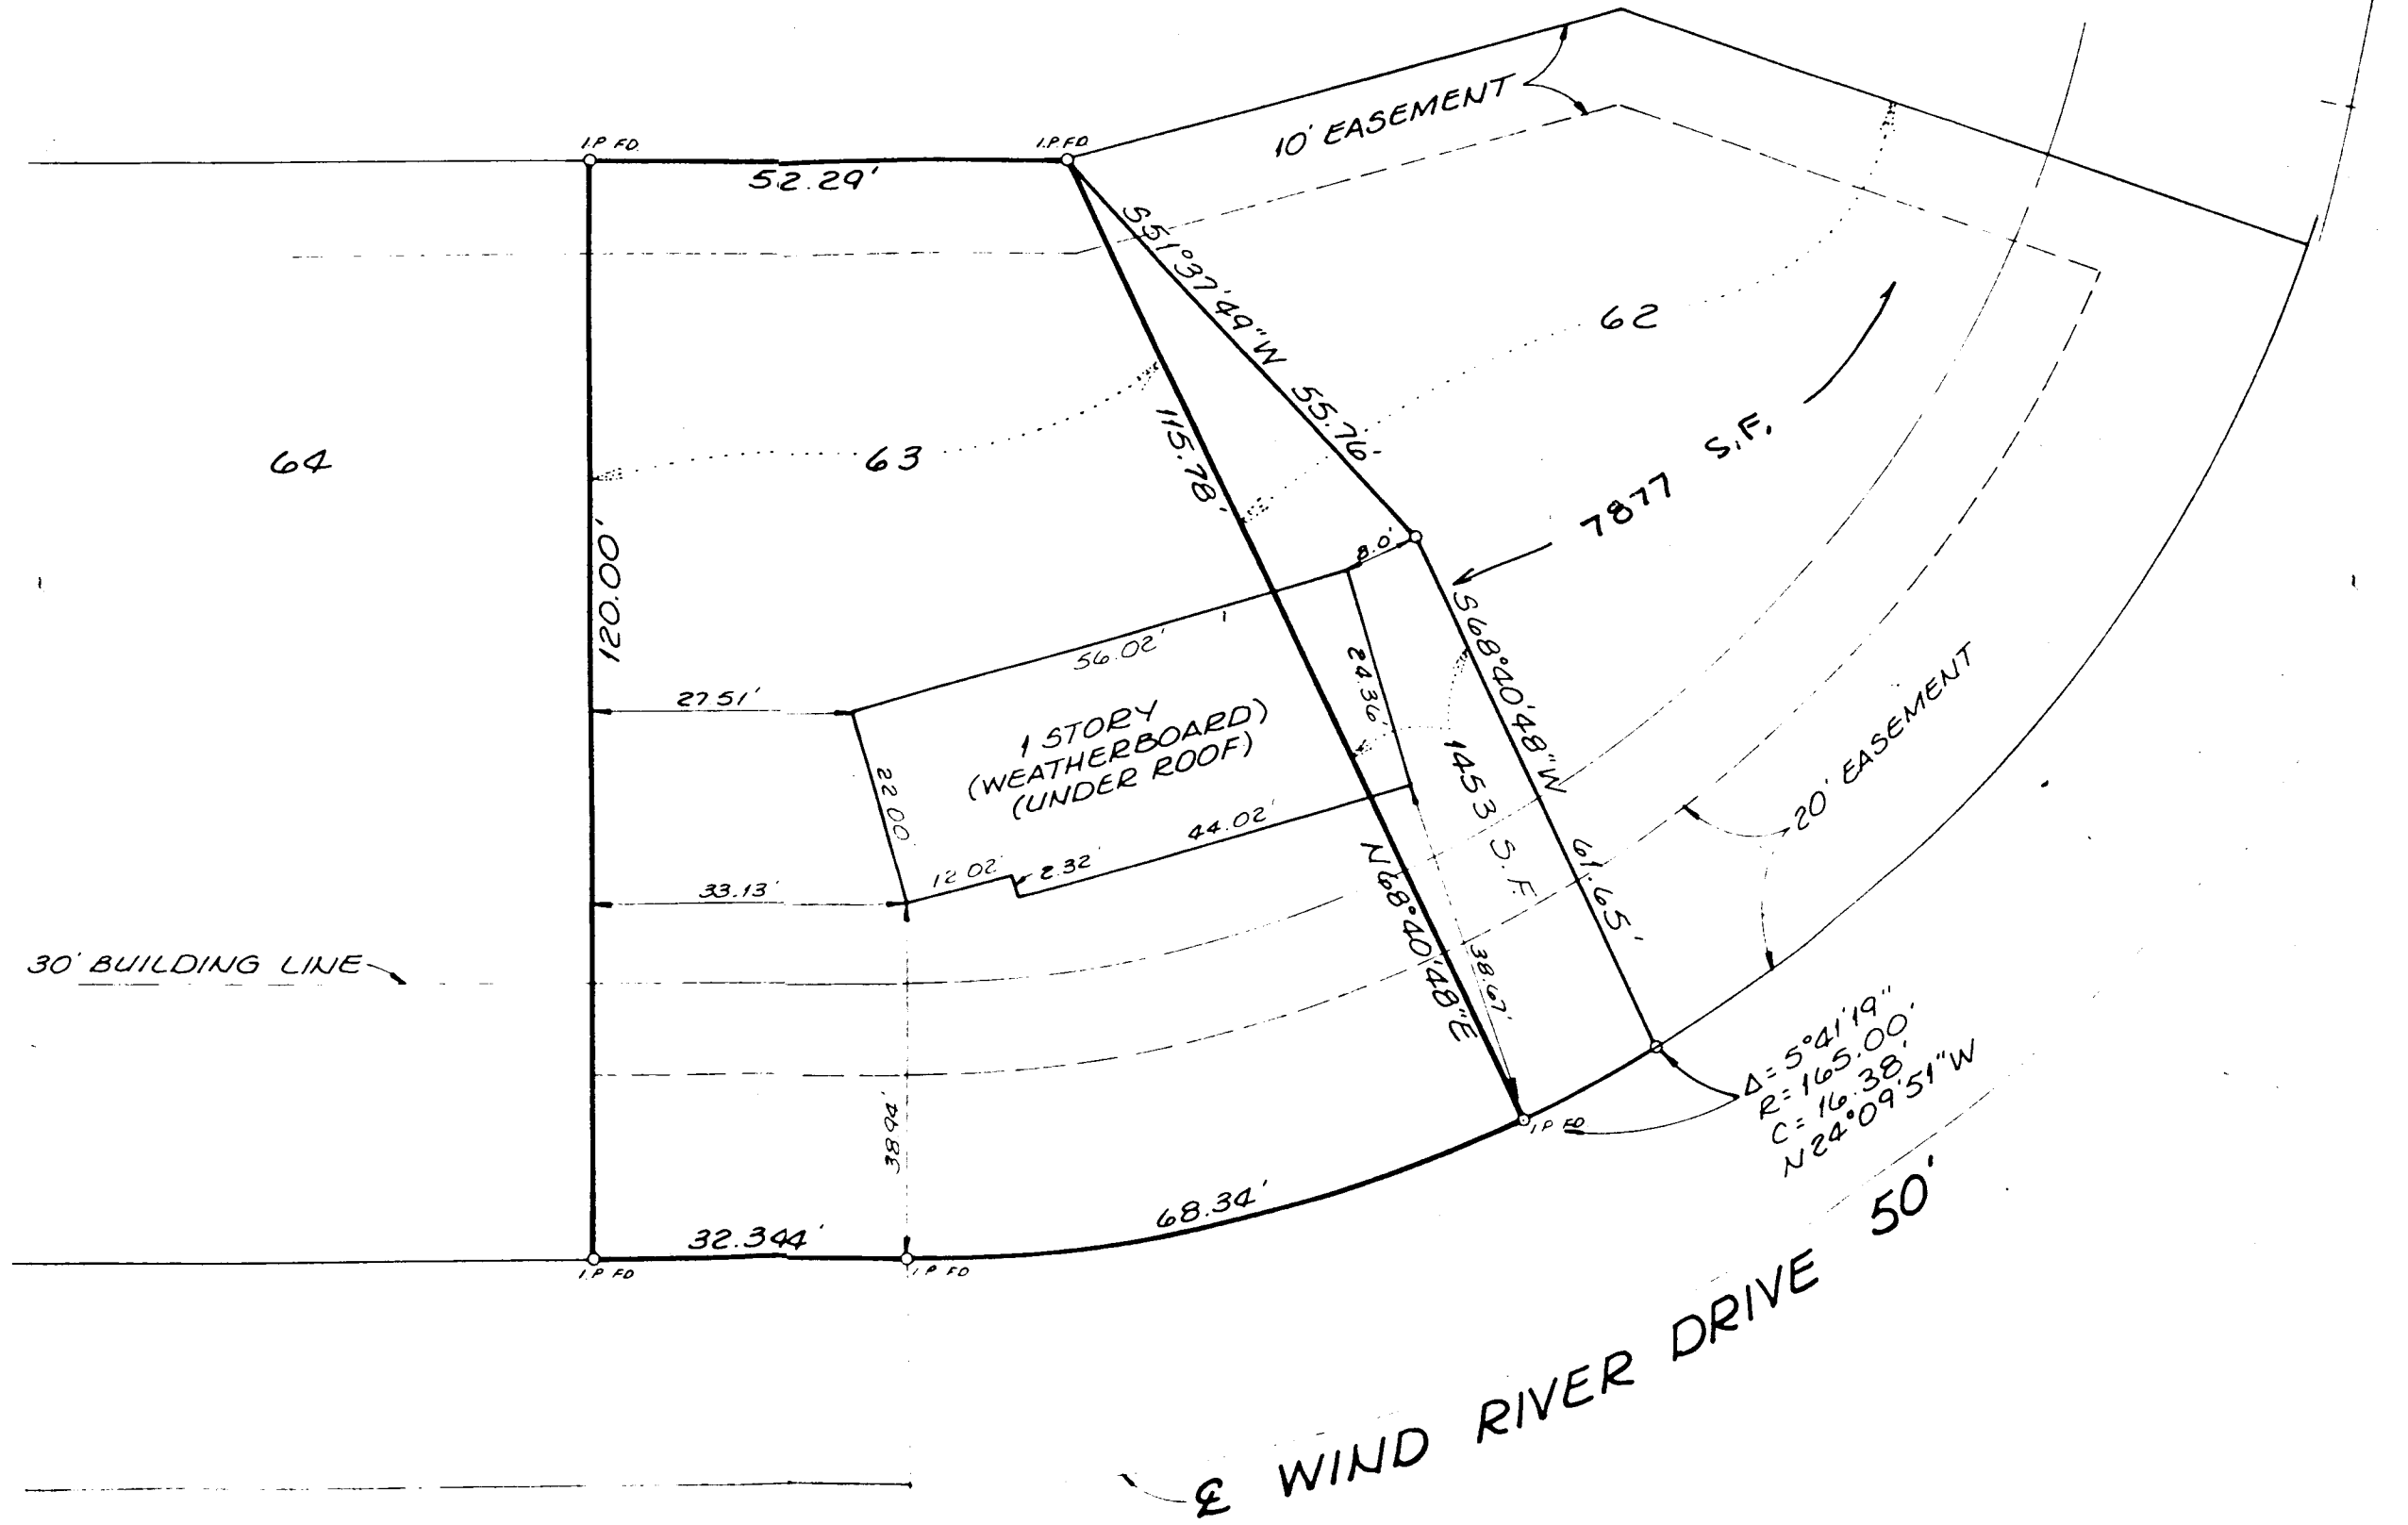

**HOUSE LOCATION SURVEY**

LOT NO. 63  
 TREEBOURNE VILLAGE  
 P.B. 51 PGS. 78 & 79

ROBT SPANIER # 4106