RESURVEY PLAT

OF PROPERTY OWNED BY WAYNE WILSON AND EVELYN R. WILSON

HERBERT C. HUBER SUBDIVISION
(HUBER HEIGHTS)
LOT NO. 781
PLAT 36 - SECTION 4
DB. 2946 - PG. 222

NOTE: For information on Parcels adjacent to Lot 781, refer to instruments of record. Plat 36-Sec. 4 Huber Sub.

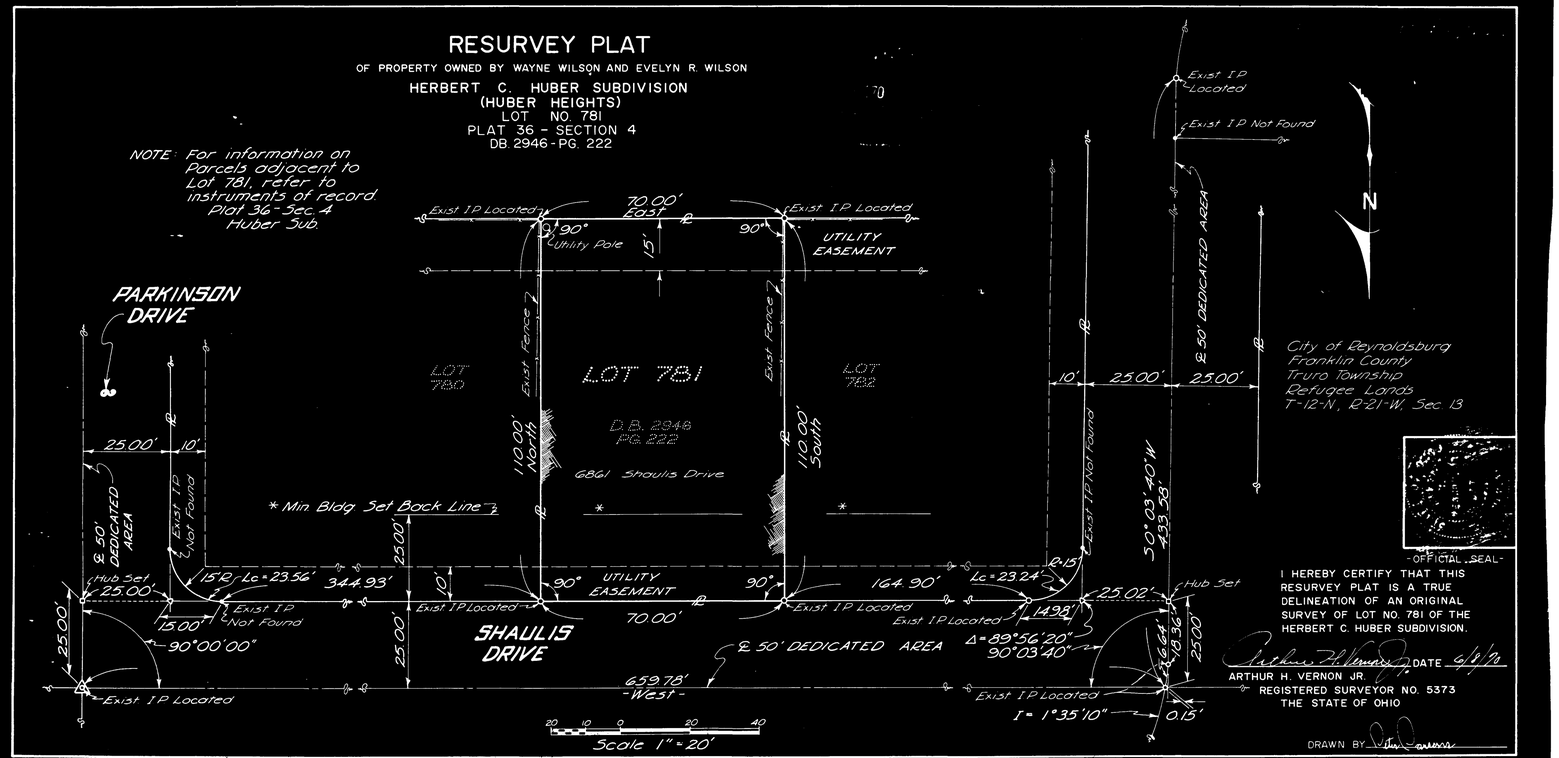

-OFFICIAL SEAL-

I HEREBY CERTIFY THAT THIS RESURVEY PLAT IS A TRUE DELINEATION OF AN ORIGINAL SURVEY OF LOT NO. 781 OF THE HERBERT C. HUBER SUBDIVISION.

DATE 6/8/70

ARTHUR H. VERNON JR.
REGISTERED SURVEYOR NO. 5373
THE STATE OF OHIO

DRAWN BY