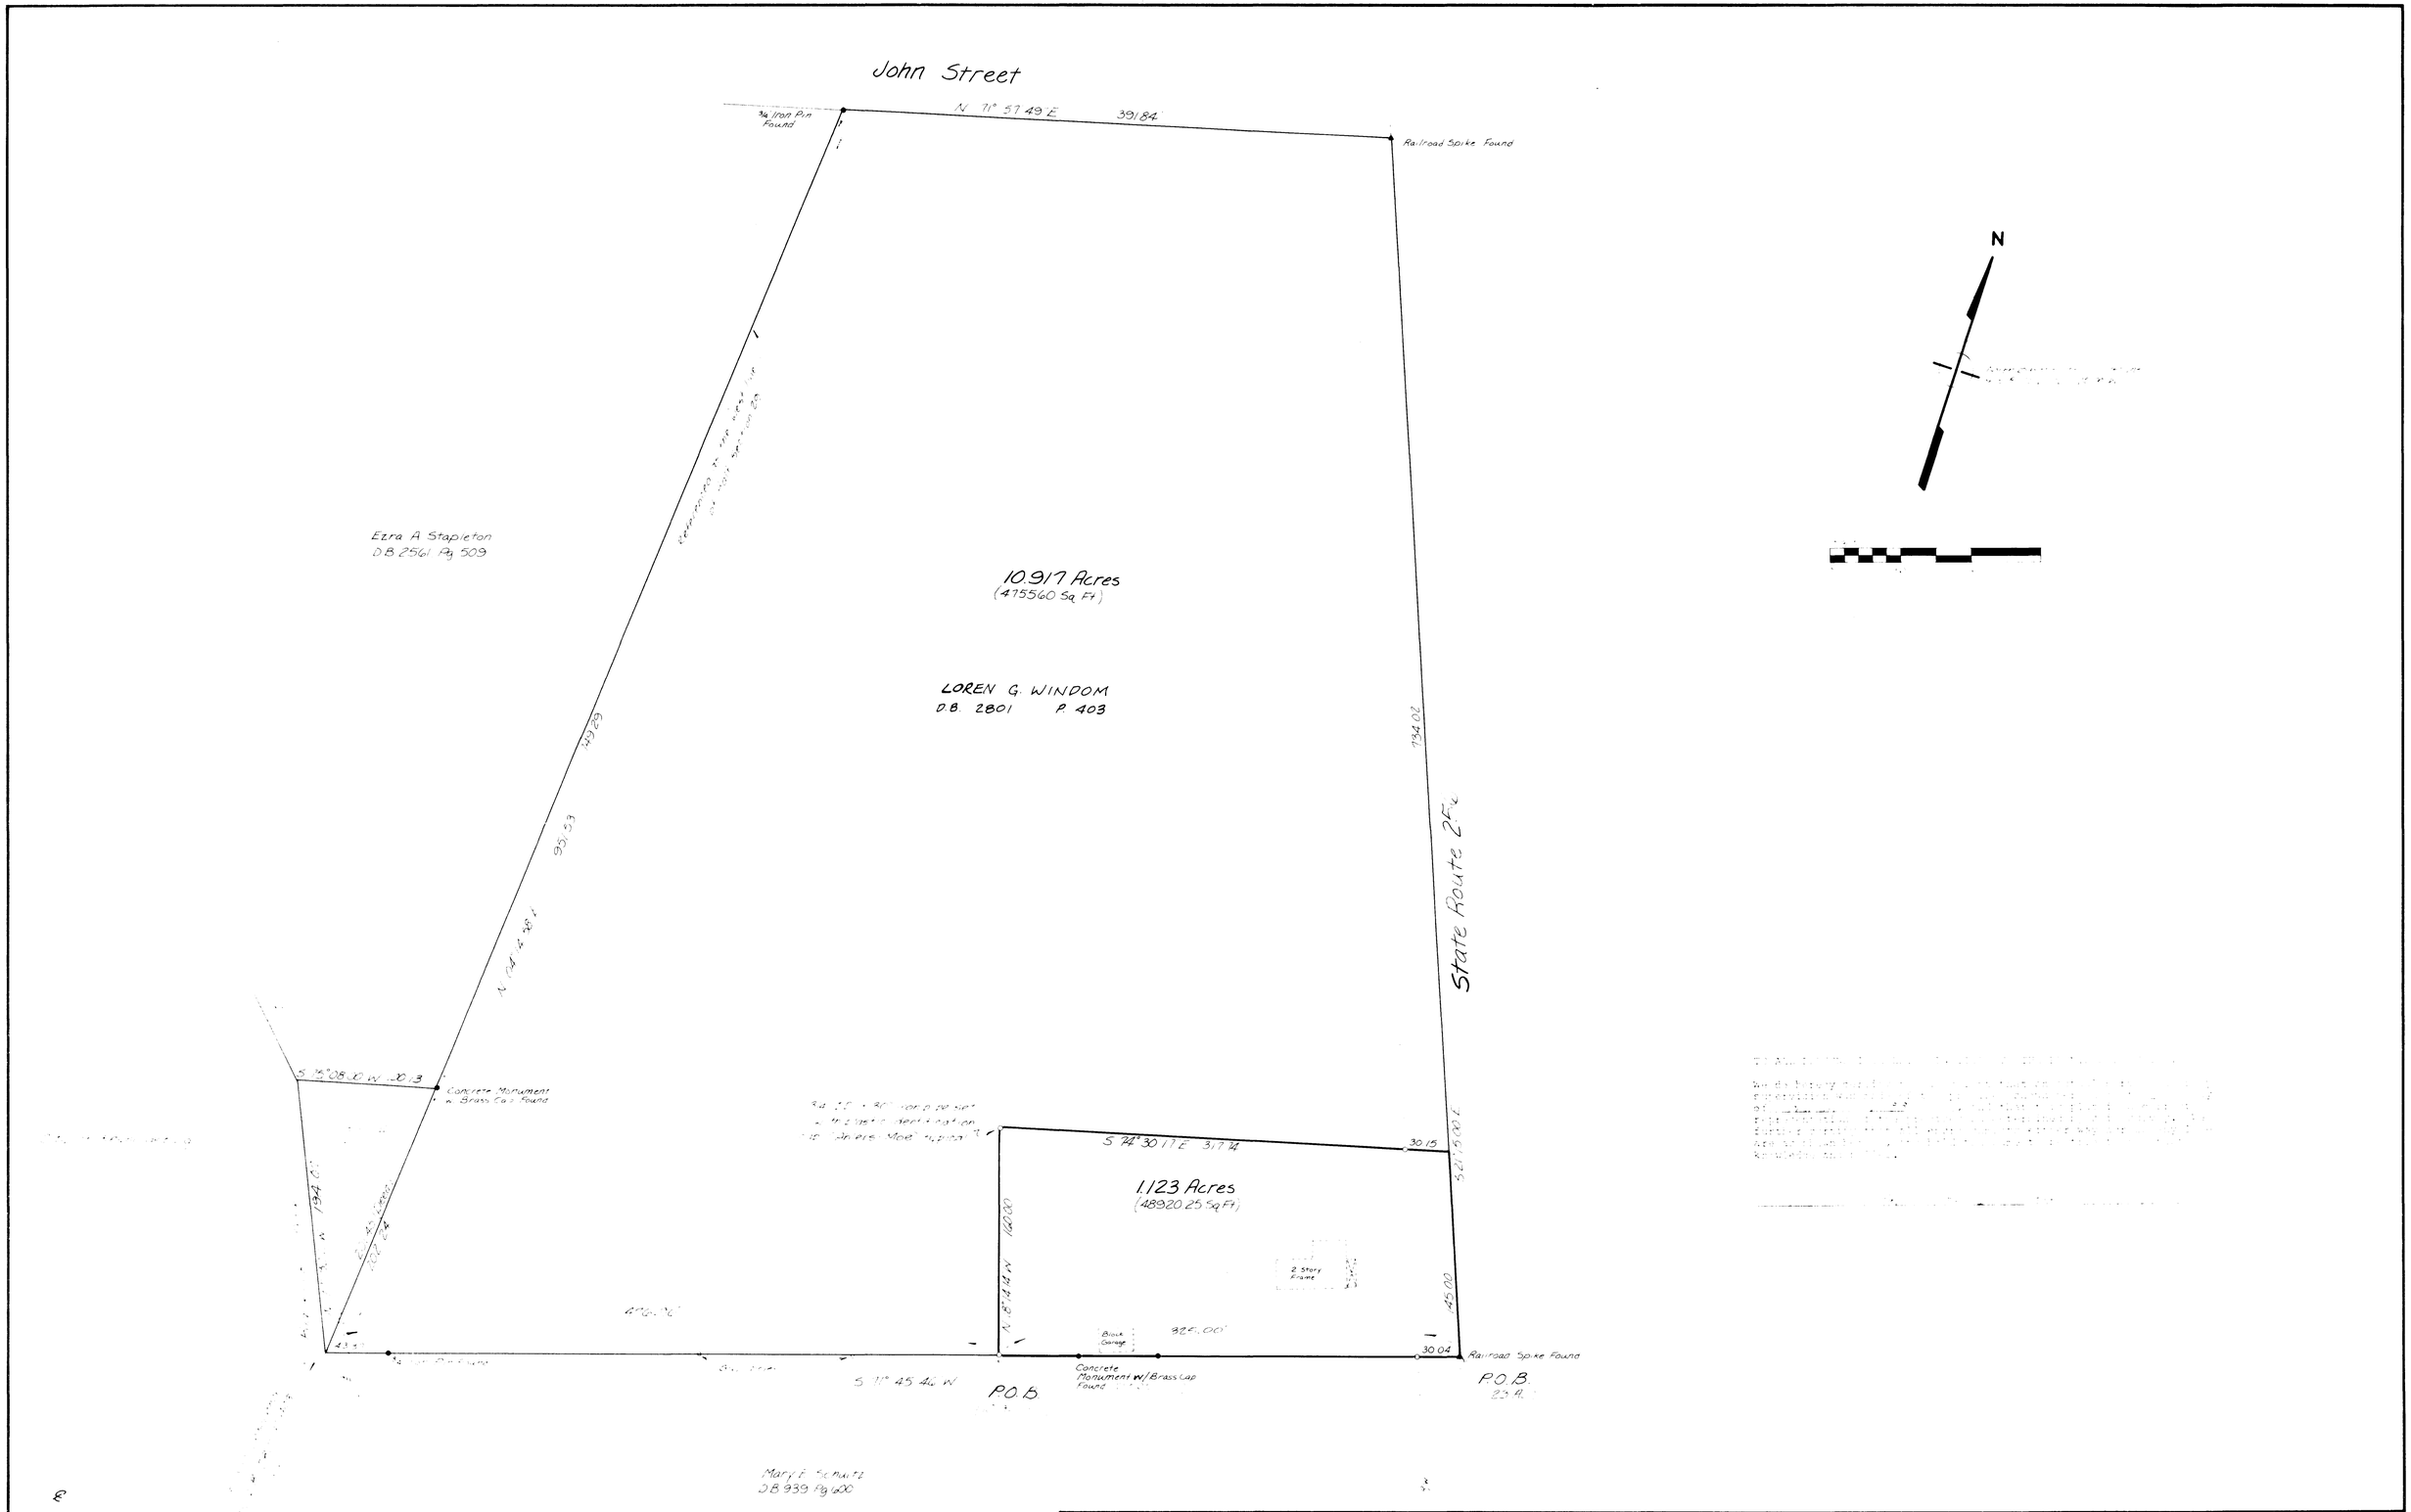

DATE	BY	DESCRIPTION

REVISION

DRAWN BY: RGR
CHECKED BY:
DATE: 4 . 88
JOB NO: 88-0410

AHLERS, MOE AND ASSOC., INC.
ENGINEERING & SURVEYING
P.O. BOX 2; 360 W. WATERLOO ST.
CANAL WINCHESTER, OHIO 837-1178

1.123 Acre Cut-out
L. Windom Propert.
Half [illegible] N. Range 20 W. Refugee Lands
[illegible] Township [illegible] Franklin [illegible]

SCALE:

SHEET ____ OF ____