



SURVEY OF ACREAGE PARCELS
 Located In Half Section 28, Section 17, Township 16, Range 20
 Refugee Lands
 City Of Reynoldsburg, Franklin County, Ohio

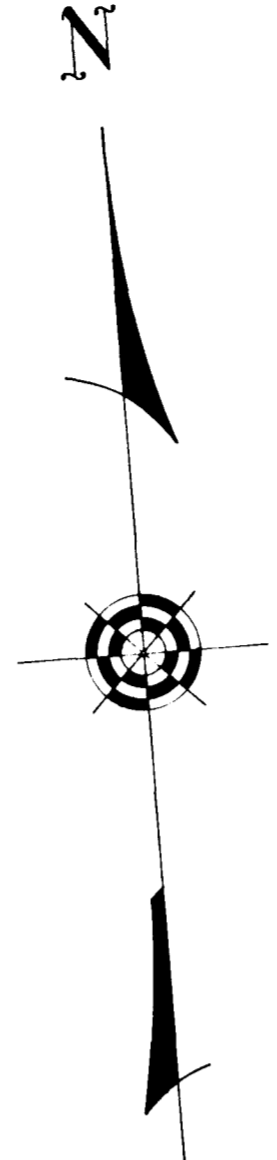

SURVEYED & PLATTED
 BY
EVANS, MECHWART, HAMBLETON & TILTON, INC.
 CONSULTING ENGINEERS AND SURVEYORS
 GAHANNA, OHIO
 By Thomas D. Sittald
 Registered Surveyor No. 5908
 SCALE: 1"=50' ○= IRON PIN
 SEPTEMBER 3, 1976

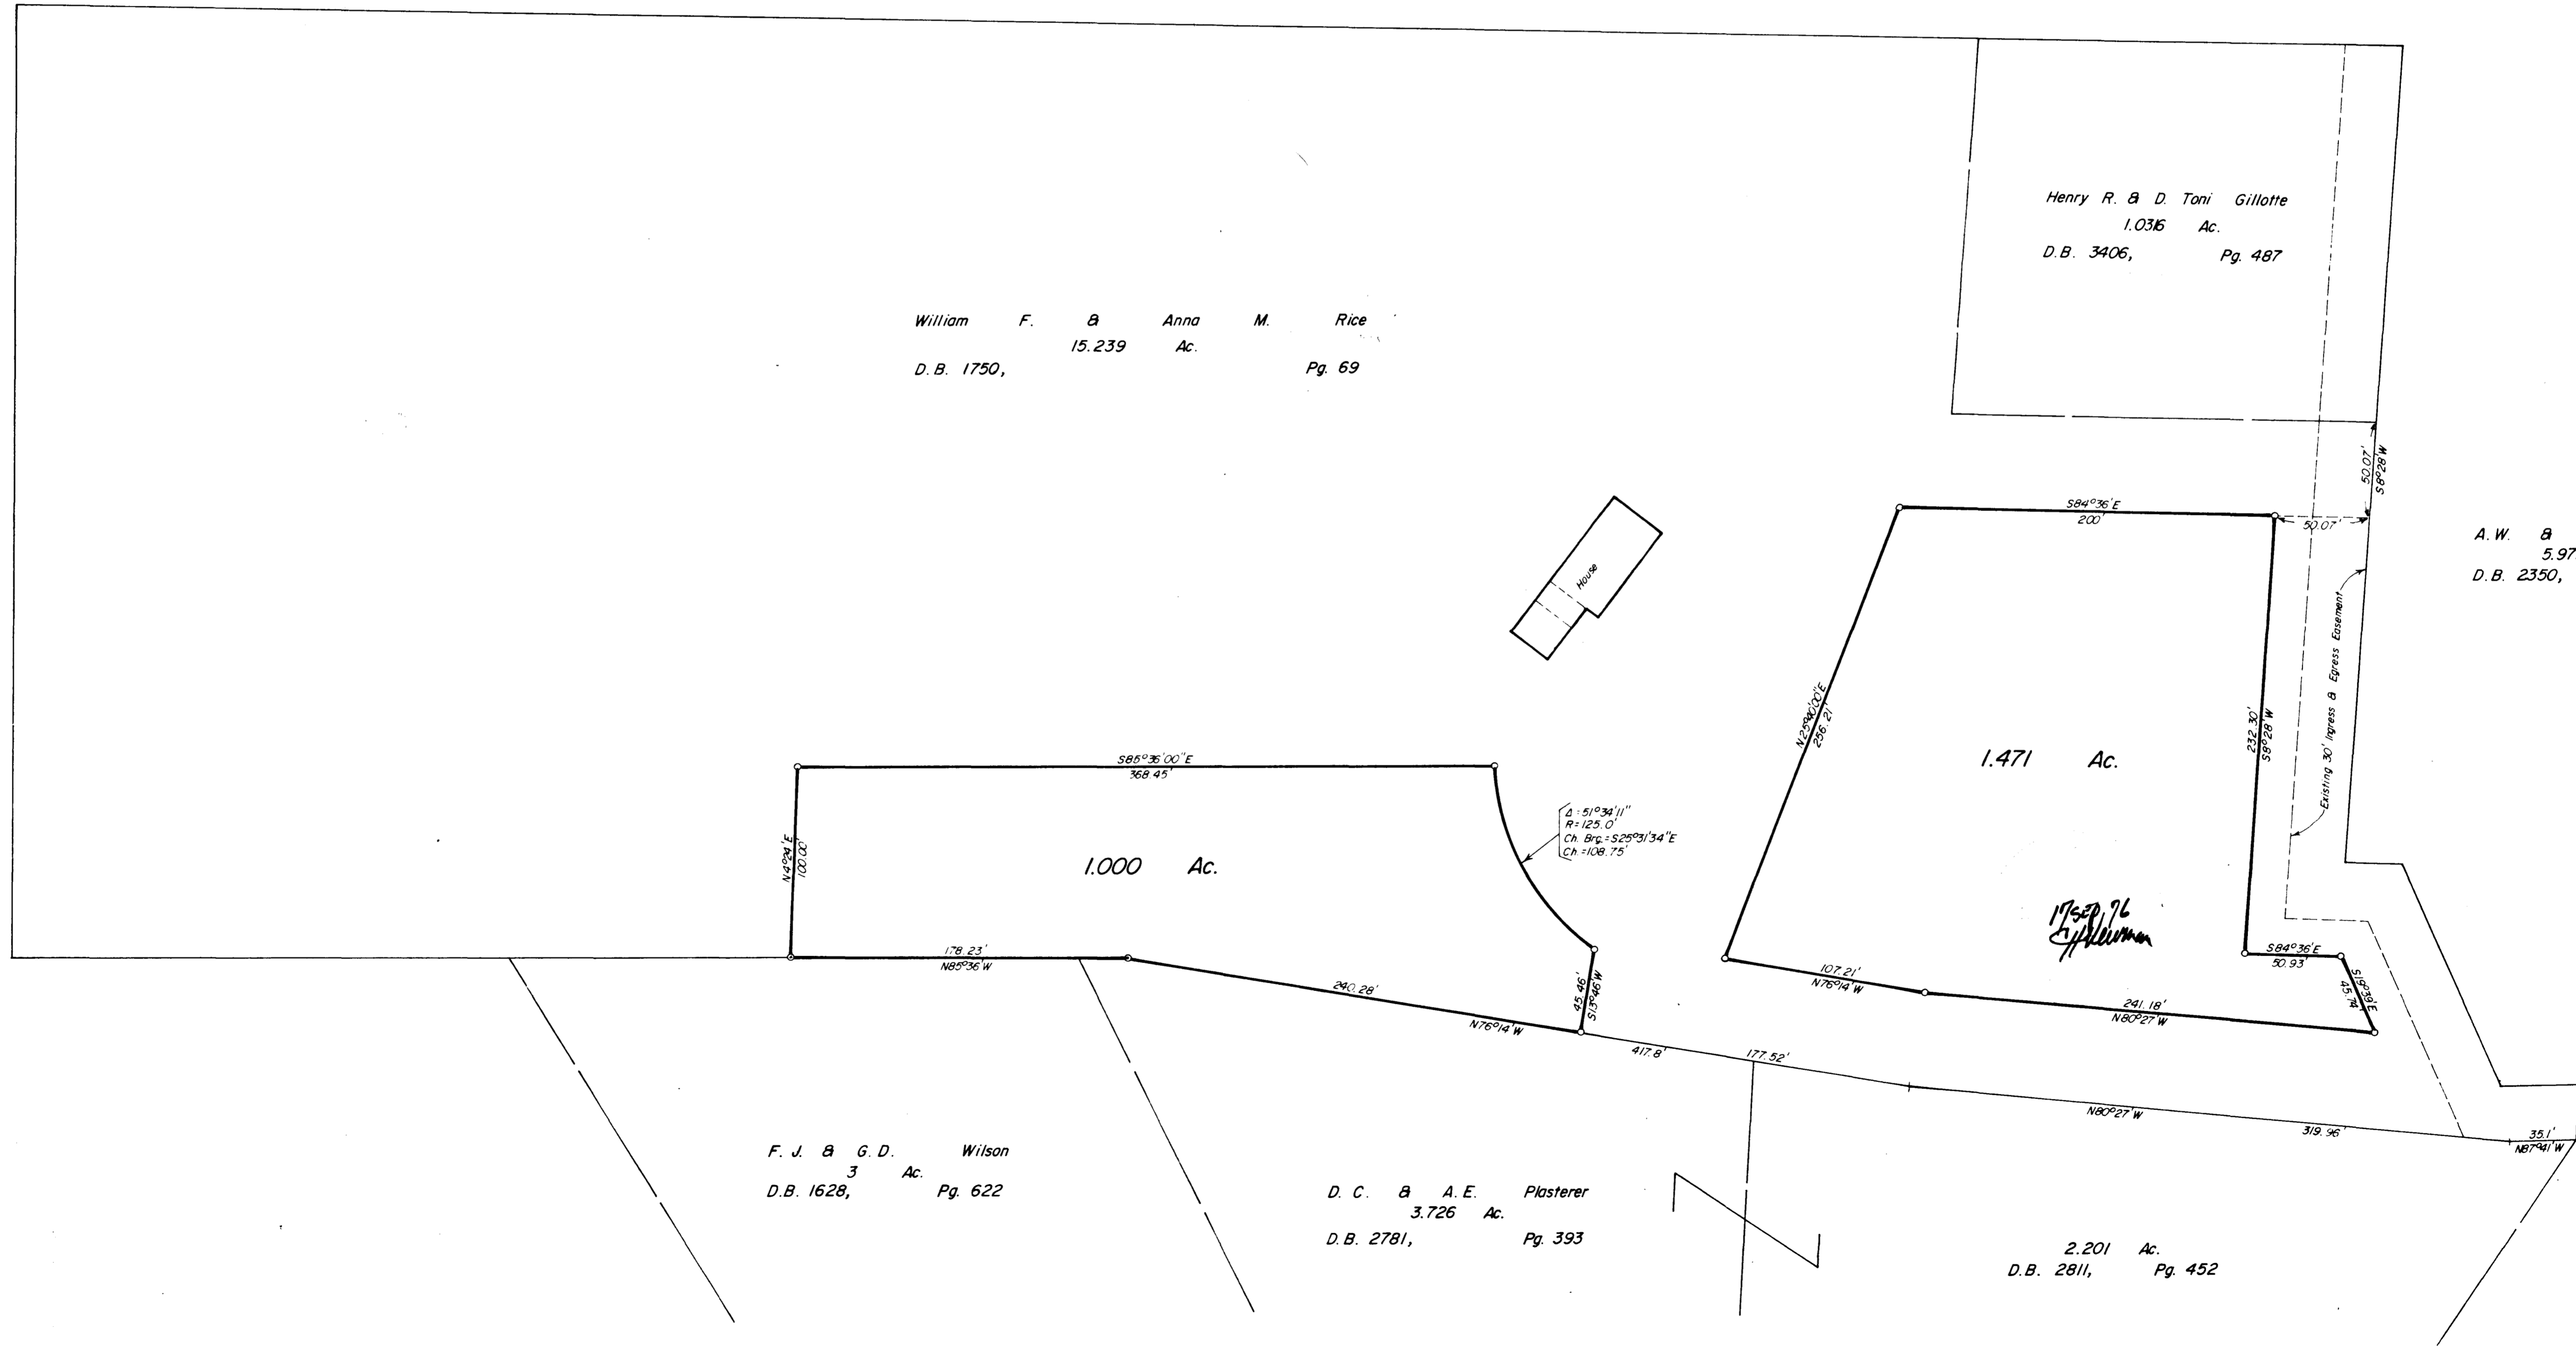

William F. & Anna M. Rice
 15.239 Ac.
 D.B. 1750, Pg. 69

Henry R. & D. Toni Gilotte
 1.036 Ac.
 D.B. 3406, Pg. 487

A.W. & B.M. Jacob
 5.979 Ac.
 D.B. 2350, Pg. 116

F. J. & G. D. Wilson
 3 Ac.
 D.B. 1628, Pg. 622

D. C. & A. E. Plasterer
 3.726 Ac.
 D.B. 2781, Pg. 393

2.201 Ac.
 D.B. 2811, Pg. 452