

SURVEY OF ACREAGE PARCELS
LOCATED IN HALF SECTION 28, SECTION 17, TOWNSHIP 16, RANGE 20
REFUGEE LANDS
 CITY OF REYNOLDSBURG, FRANKLIN COUNTY, OHIO

Dorothy A. Bates
 14.717 Ac.
 D.B. 3159 Pg. 527

J. A. & M. P. Hubbard
 1.00 Ac.
 D.B. 3570, Pg. 535

O. D. Wheeler
 8.0 Ac.
 D.B. 3722, Pg. 472


Rose Oravec
 2.65 Ac.
 D.B. 3269, Pg. 472

R. S. & L. L. Schilling
 4.033 Ac.
 D.B. 3611, Pg. 225

G. D. Wilson
 3.0 Ac.
 D.B. 1563, Pg. 31
 O.R. 01744 F08

E. L. & A. J. Goble
 2.5 Ac.
 D.B. 3625, Pg. 878

1.0 Ac
 D.B. 3654, Pg. 460

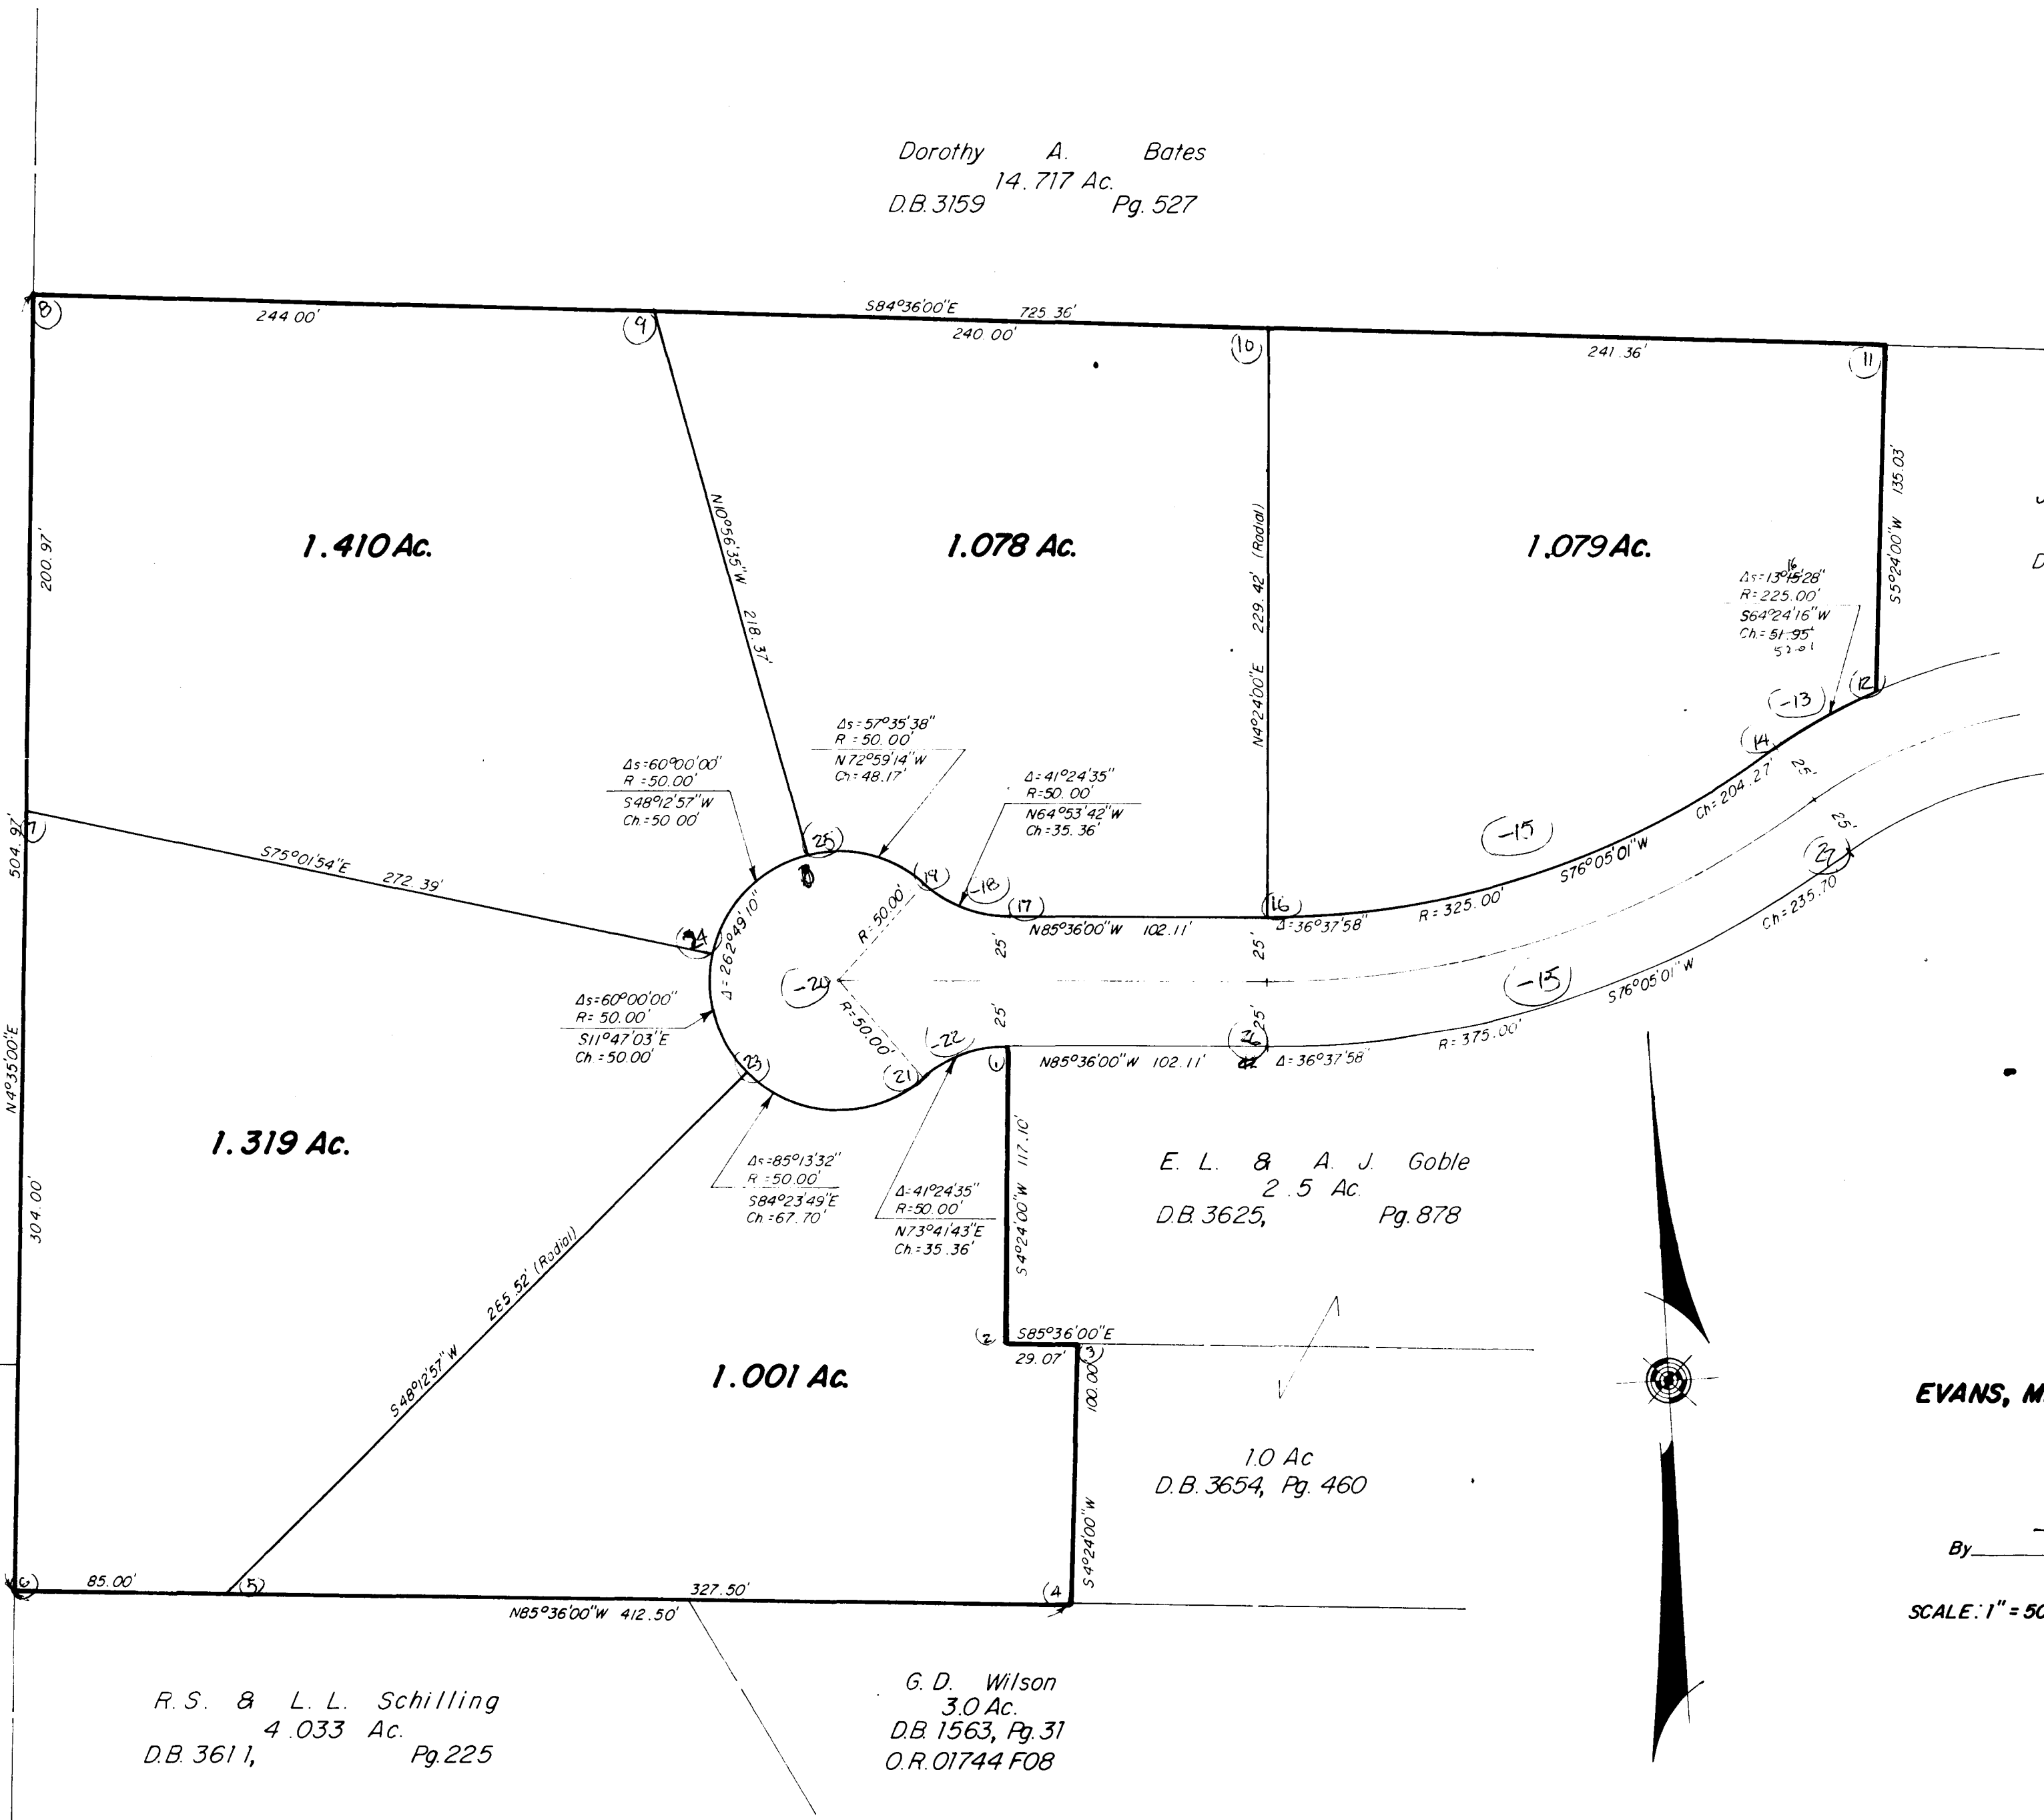

SURVEYED & PLATTED
 BY
EVANS, MECHWART, HAMBLETON & TILTON, INC.
 CONSULTING ENGINEERS & SURVEYORS
 GAHANNA, OHIO

By T. Thomas D. Sill
 Registered Surveyor No. 5908

SCALE: 1" = 50'

OCTOBER 25, 1985
 REVISED: JANUARY 10, 1986