

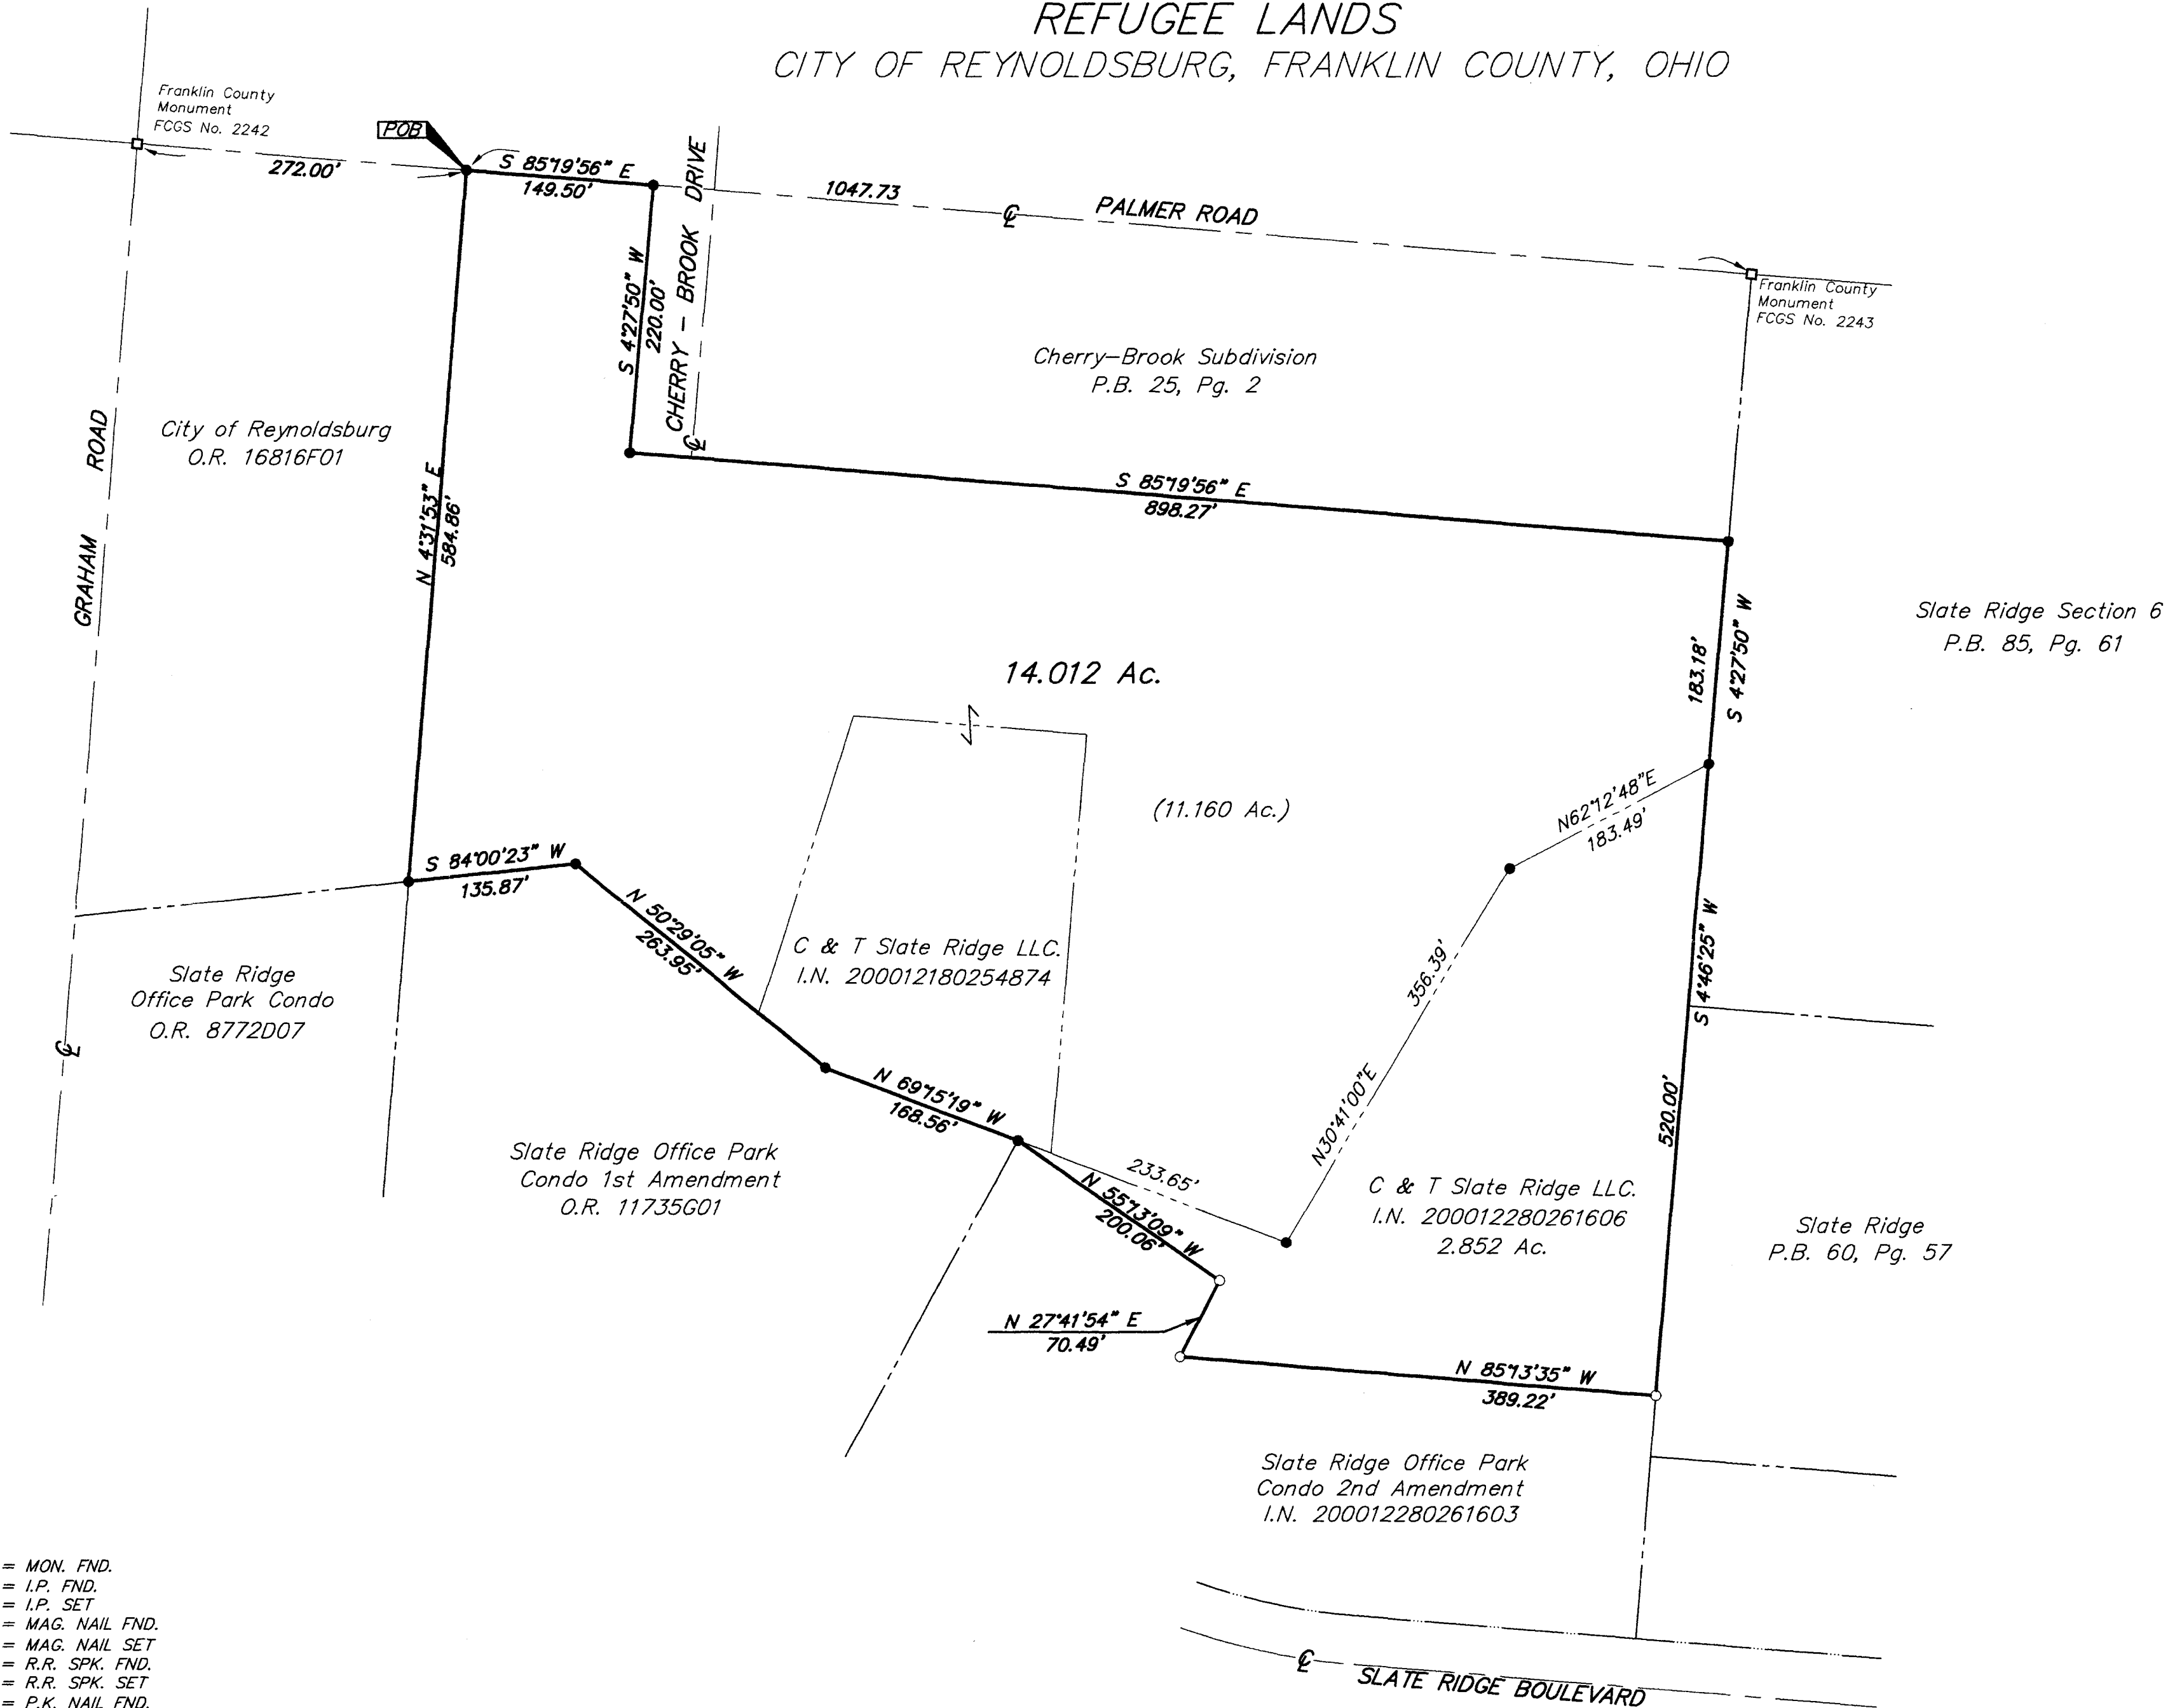



SURVEY OF ACREAGE PARCEL
 LOCATED IN HALF SECTION 29, TOWNSHIP 16, RANGE 20
 REFUGEE LANDS
 CITY OF REYNOLDSBURG, FRANKLIN COUNTY, OHIO

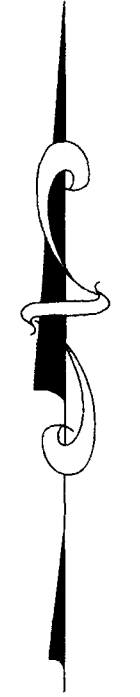

- = MON. FND.
 - = I.P. FND.
 - = I.P. SET
 - = MAG. NAIL FND.
 - = MAG. NAIL SET
 - ▲ = R.R. SPK. FND.
 - △ = R.R. SPK. SET
 - ◆ = P.K. NAIL FND.
- I.P.S Set are 13/16" I.D. Iron pipe w/ cap inscribed EMH&T.

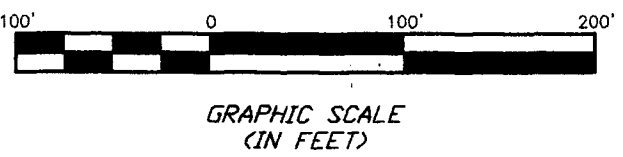

NOTE:
 The bearings shown hereon are based on the same meridian as the bearings on the recorded plat of "SLATE RIDGE", as shown of record in Plat Book 60, Page 57.

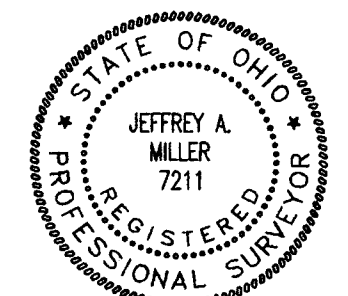

SURVEYED & PREPARED BY
EMT
 CONSULTING ENGINEERS & SURVEYORS
 170 MILL STREET
 GAHANNA, OHIO 43230
 (614) 471-5150

By *Jeffrey A. Miller* 3-26-01
 Professional Surveyor No. 7211