



**SURVEY OF ACREAGE PARCELS**  
 LOCATED IN HALF SECTION 29, TOWNSHIP 16, RANGE 20,  
 REFUGEE LANDS  
 CITY OF REYNOLDSBURG, FRANKLIN COUNTY, OHIO

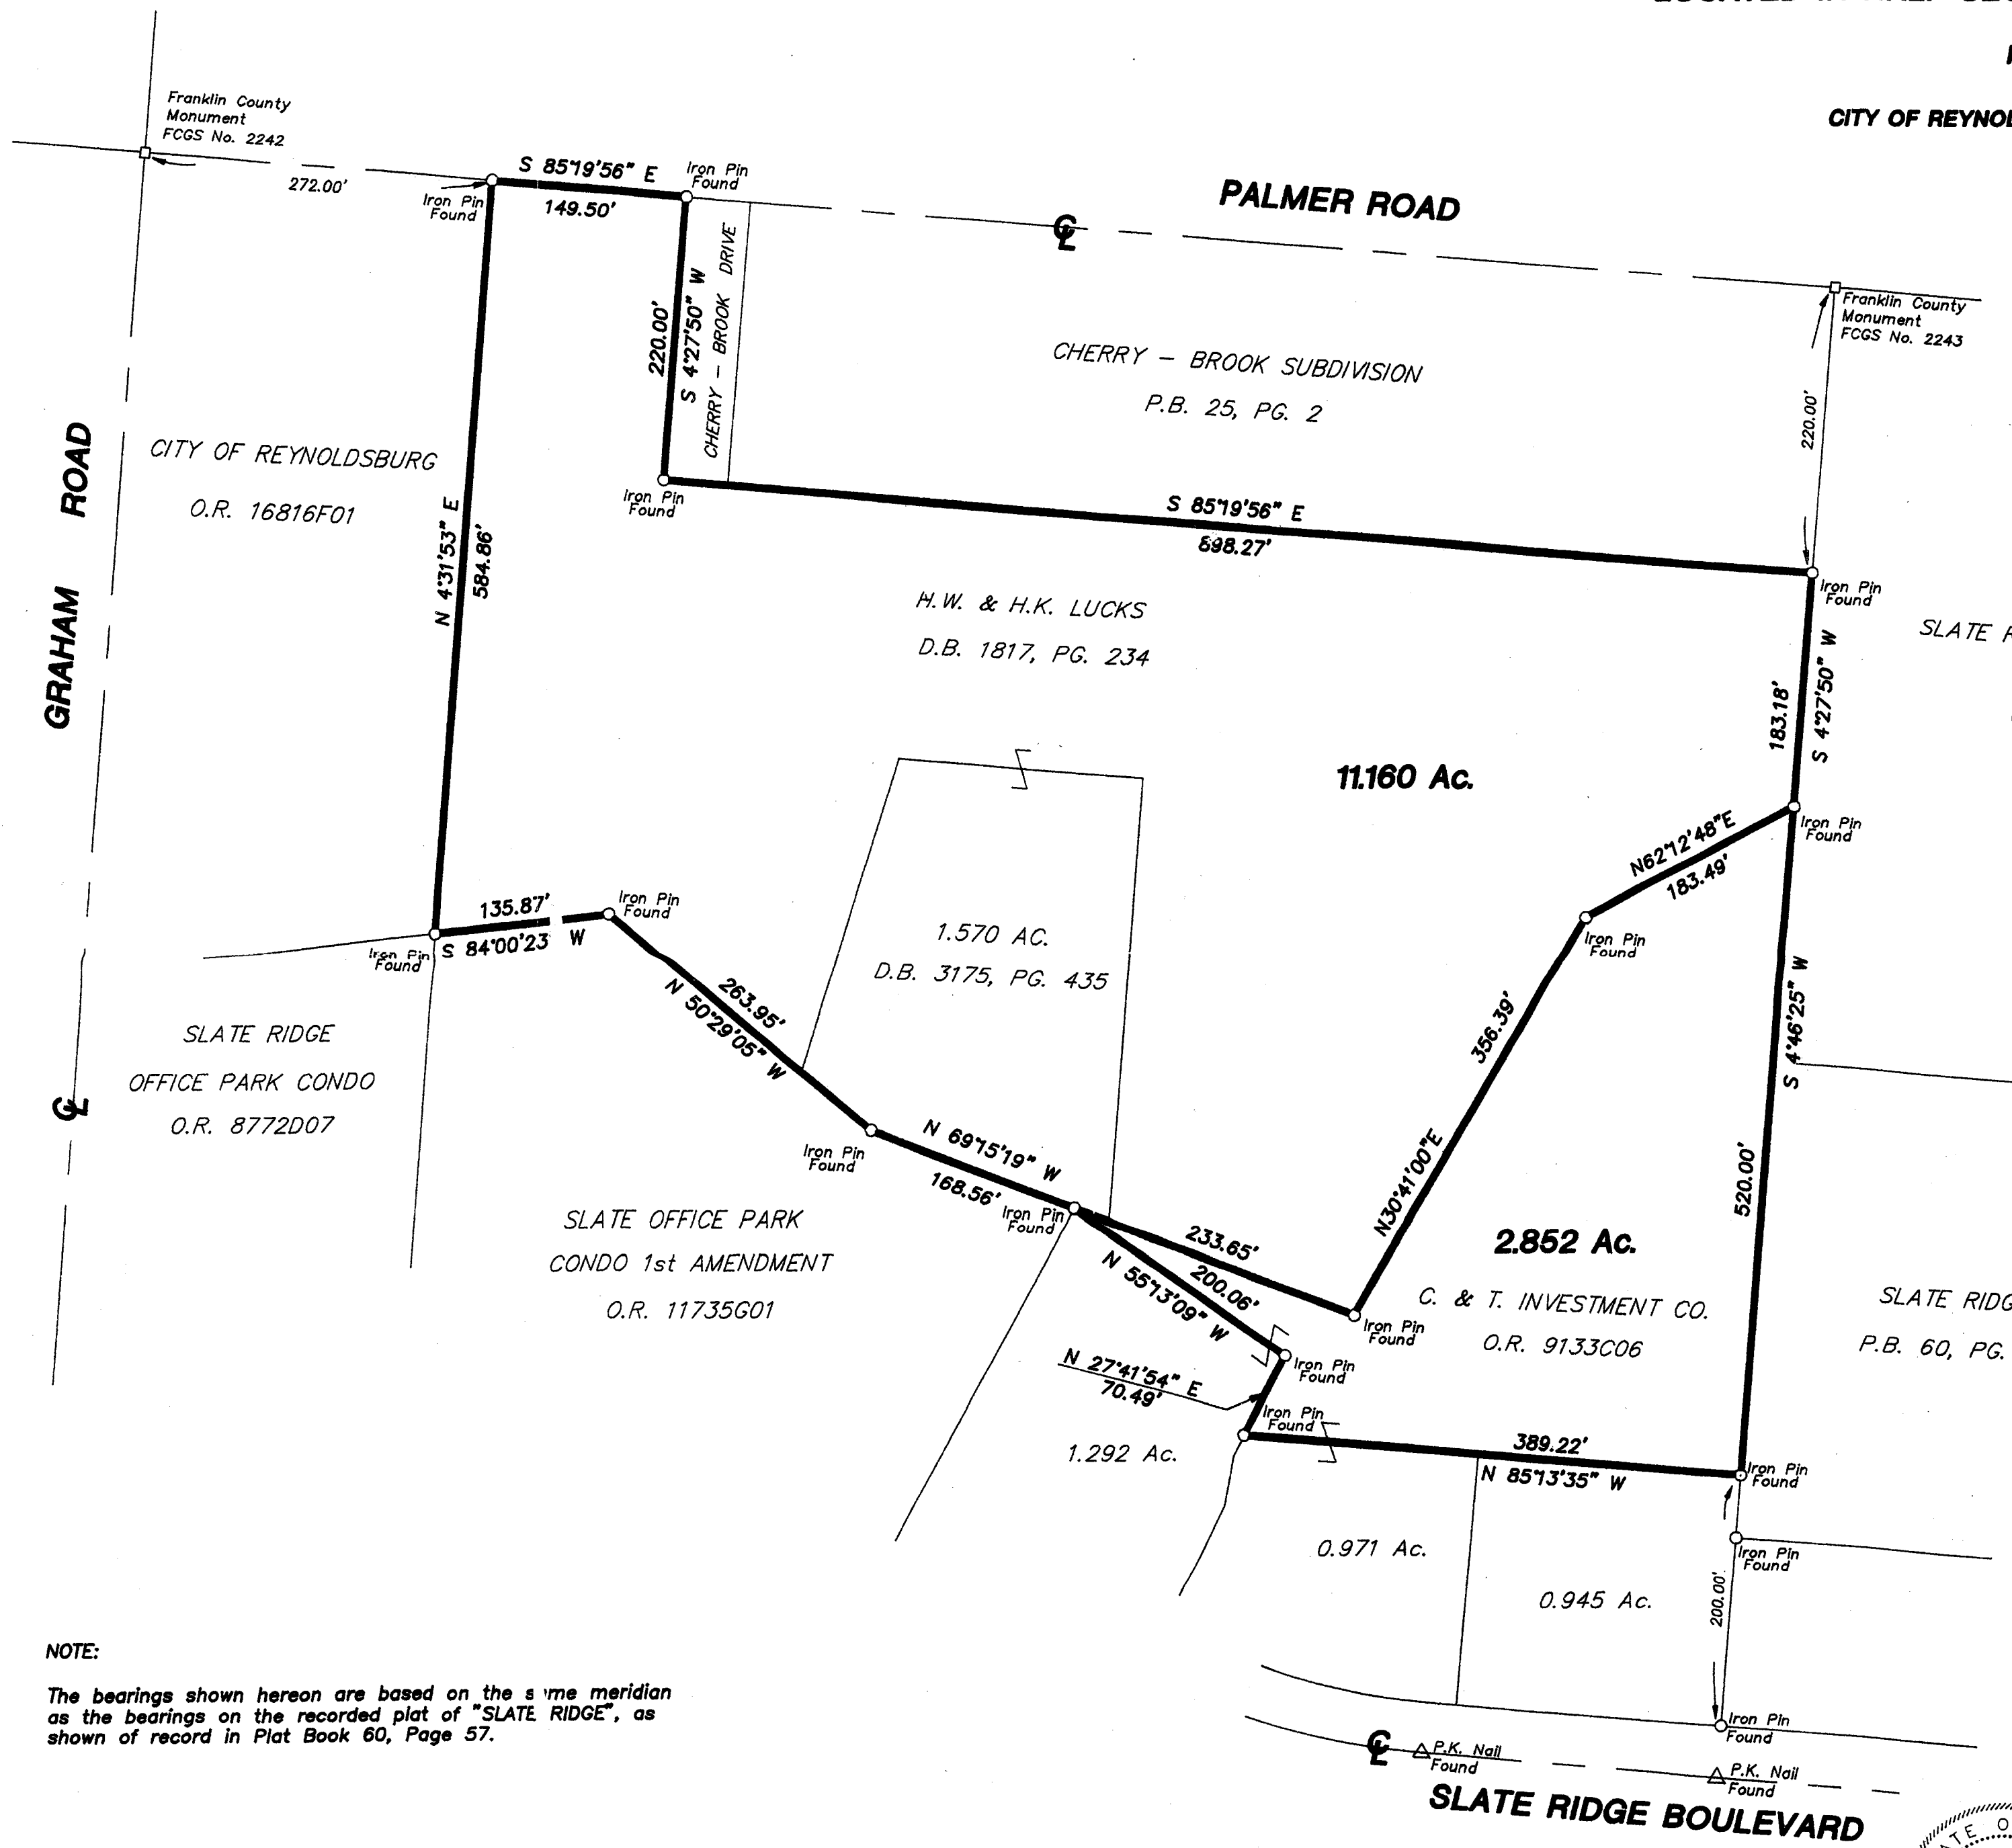

NOTE:  
 The bearings shown hereon are based on the same meridian as the bearings on the recorded plat of "SLATE RIDGE", as shown of record in Plat Book 60, Page 57.

Surveyed & Platted  
 By  
**EVANS, MECHWART, HAMBLETON, & TILTON INC.**  
 CONSULTING ENGINEERS AND SURVEYORS  
 170 MILL STREET  
 GAHANNA, OHIO 43230  
 614/471-5150

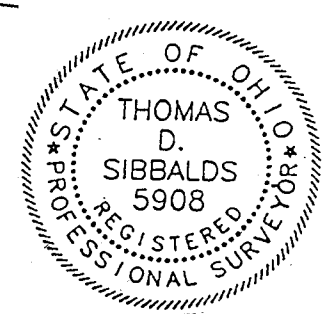

By Thomas D. Sibbalds  
 Registered Surveyor No. 5908  
 SCALE 1" = 100' December 26, 2000  
 100' 80' 60' 40' 20' 0' 100' 200'  
 GRAPHIC SCALE 1" = 100'