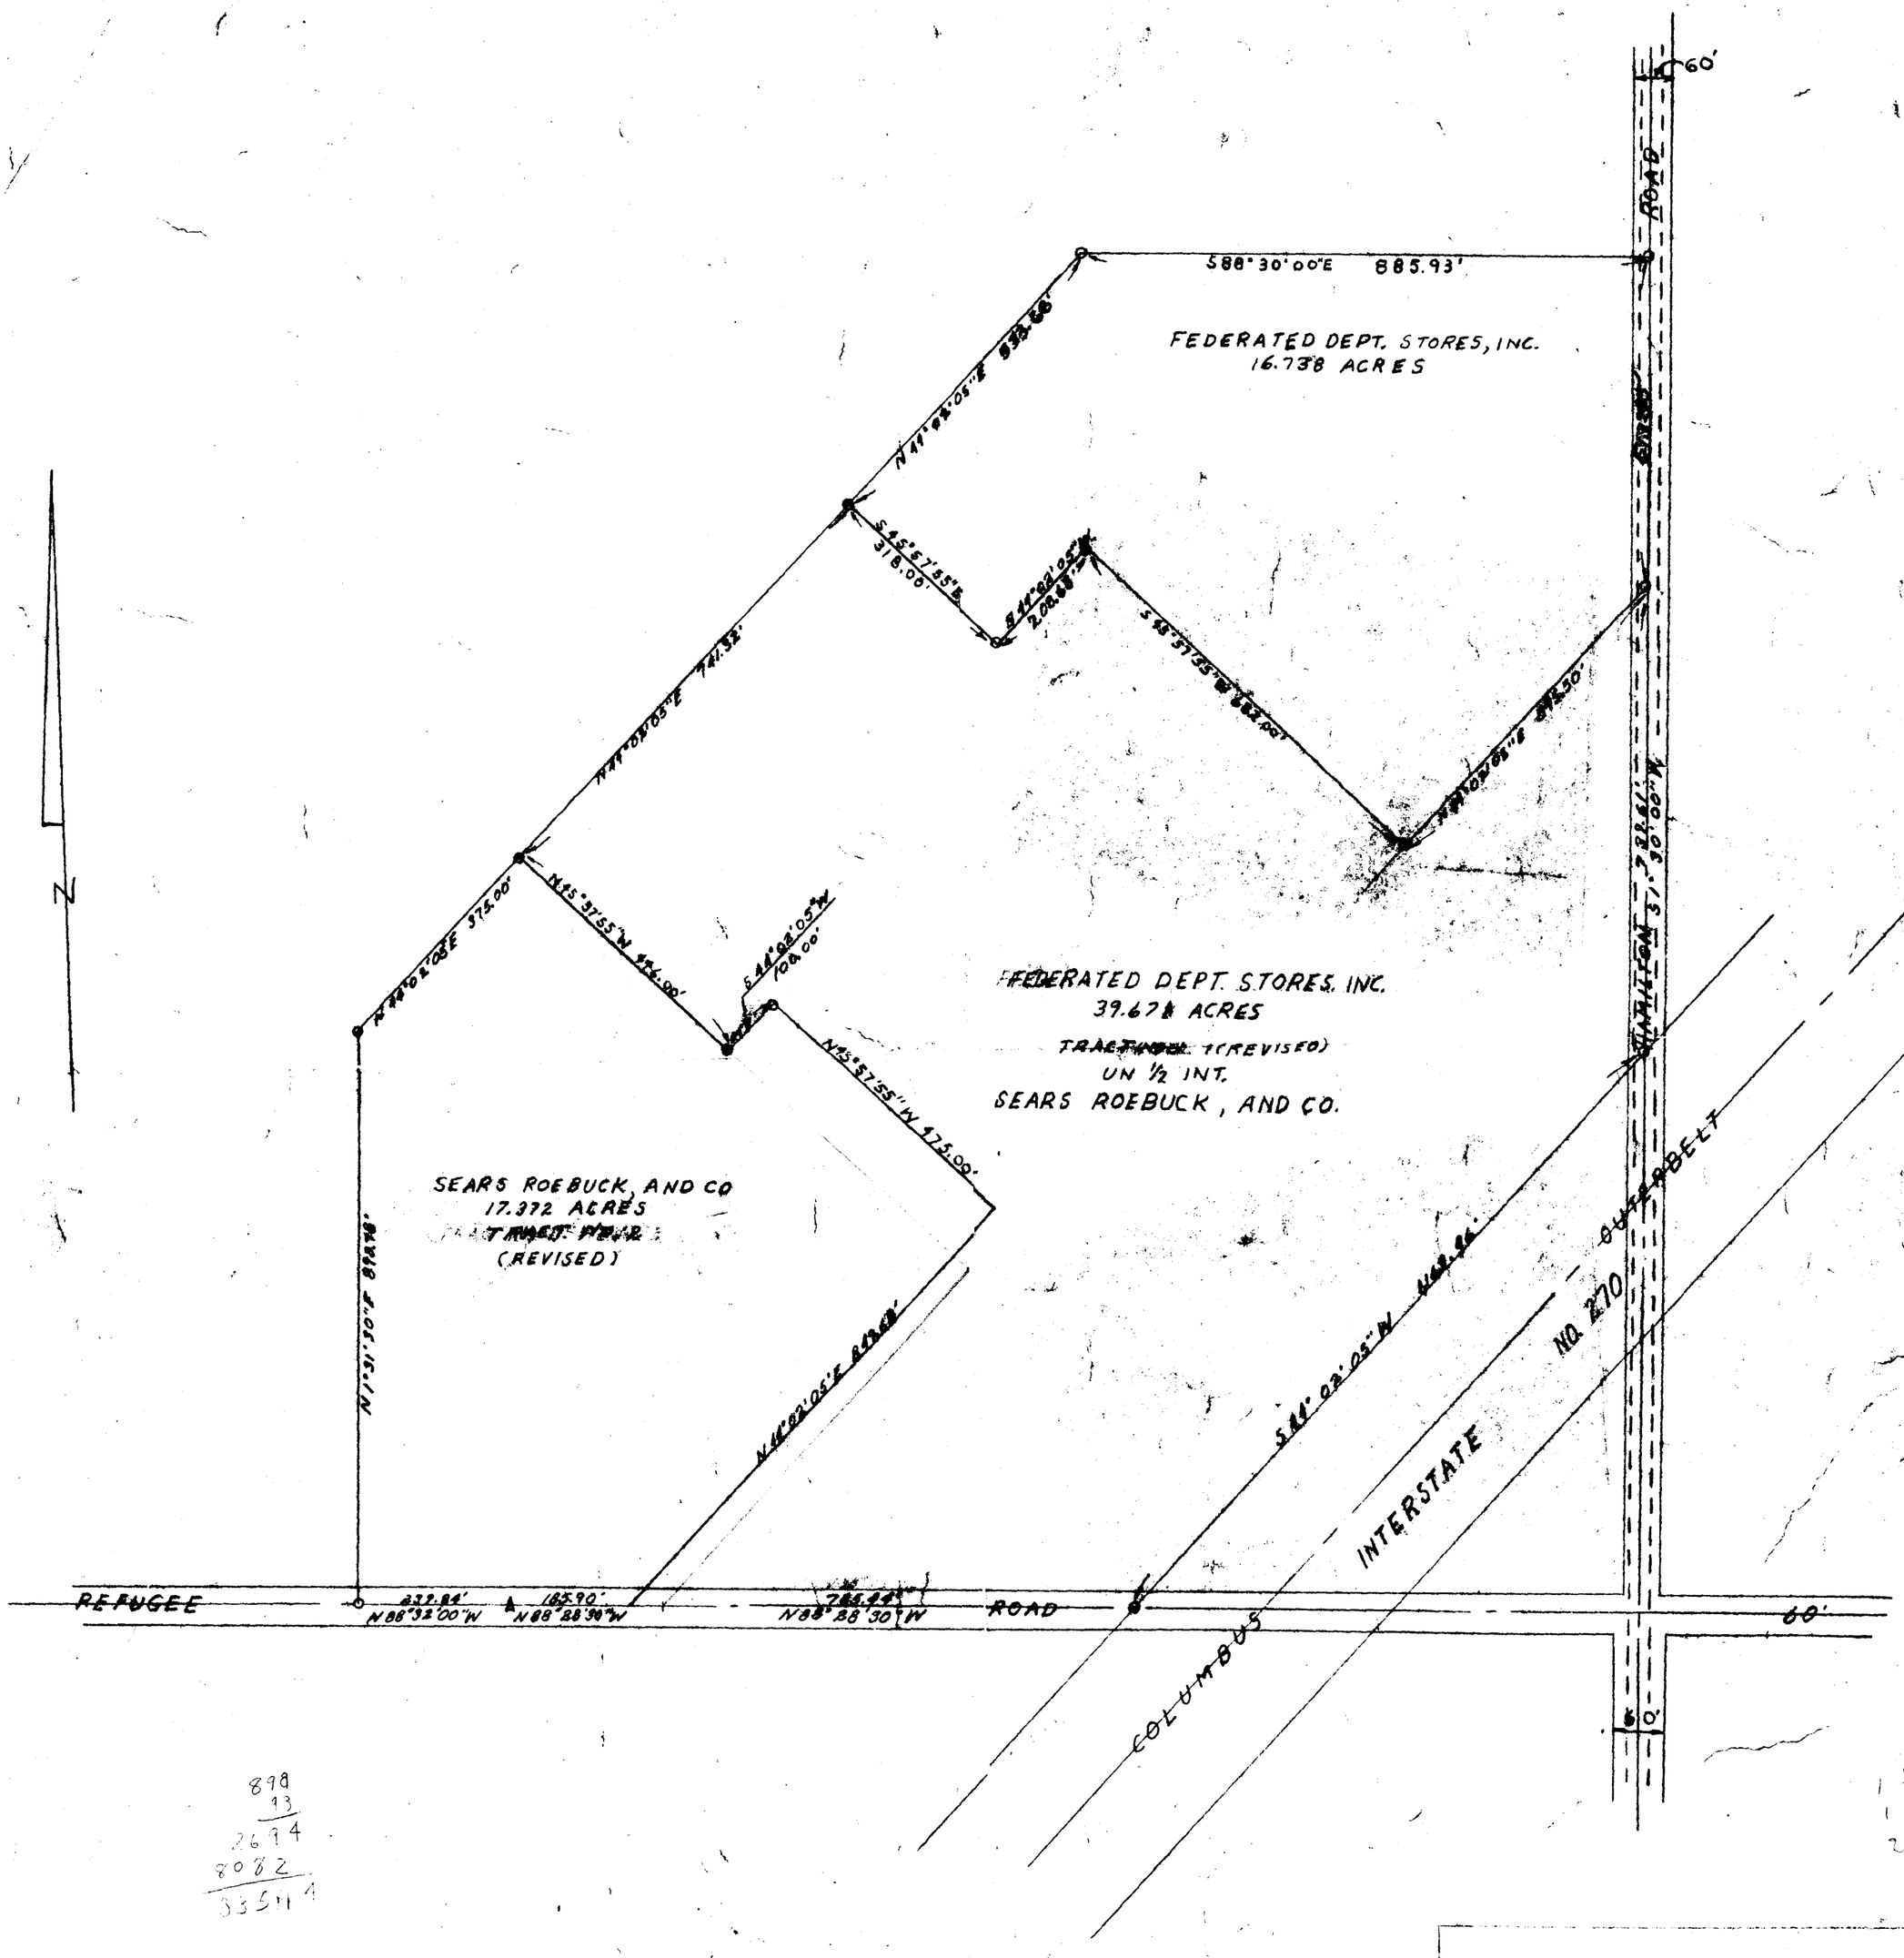

3700 120 04/ 004 N REFUGEE W HAMILTON 1966 1034 003

PLAT SHOWING REVISED PARTITION OF THREE (3) TRACTS @ HAMILTON AND REFUGEE ROADS

SCALE: 1" = 200'	FOR: FEDERATED DEPT. STORES, INC.	SHEET 1 of 1
DRAWN: BEW 2-8-66	MOCKADEM-LIPES-ROUSCULP, INC.	
CHECKED: LAH - 2-17-66	CONSULTING ENGINEERS	
REVISED: LAH - 2-17-66		DRAWING NO. P-143