NOTE:
The following easements conveyed to The City of Columbus, do not apply to the parcels shown hereon;
D.B. 2092, Pg. 590
D.B. 2757, Pg. 564
D.B. 2799, Pg. 591
D.B. 2824, Pg. 593

# PLAT OF ACREAGE PARCELS

Located in Section 28, Township 12, Range 21

Refugee Lands

Being 4.311 Acres of the Freight Terminals, Inc. 28.478 Ac. tract, of record in D.B. 2883, Pg. 86

City of Columbus, Franklin County, Ohio

The undersigned hereby certifies that this is a plat of an actual survey of the property and shows the improvements as presently constructed. Said improvements are located entirely within the lot lines.

Thomas D. Sibbalds
Registered Surveyor No. 5908

Revised May 8, 1973
Revised July 2, 1973
Revised March 28, 1974
Revised April 23, 1974
Revised February 28, 1975
Revised November 5, 1975

Surveyed and Platted By
EVANS, MECHWART, HAMBLETON & TILTON, INC.
Consulting Engineers & Surveyors
Gahanna, Ohio
By Thomas D. Sibbalds
Registered Surveyor No. 5908

Scale: 1" = 50'
October 25, 1971
Revised December 13, 1972
Revised Sept 25, 1972

Prepared for and at the instance of: VINCE K. OLIVER, MELLON NATIONAL MORTGAGE COMPANY OF OHIO, NEW ENGLAND MUTUAL LIFE INSURANCE COMPANY and BERKS TITLE INSURANCE COMPANY.

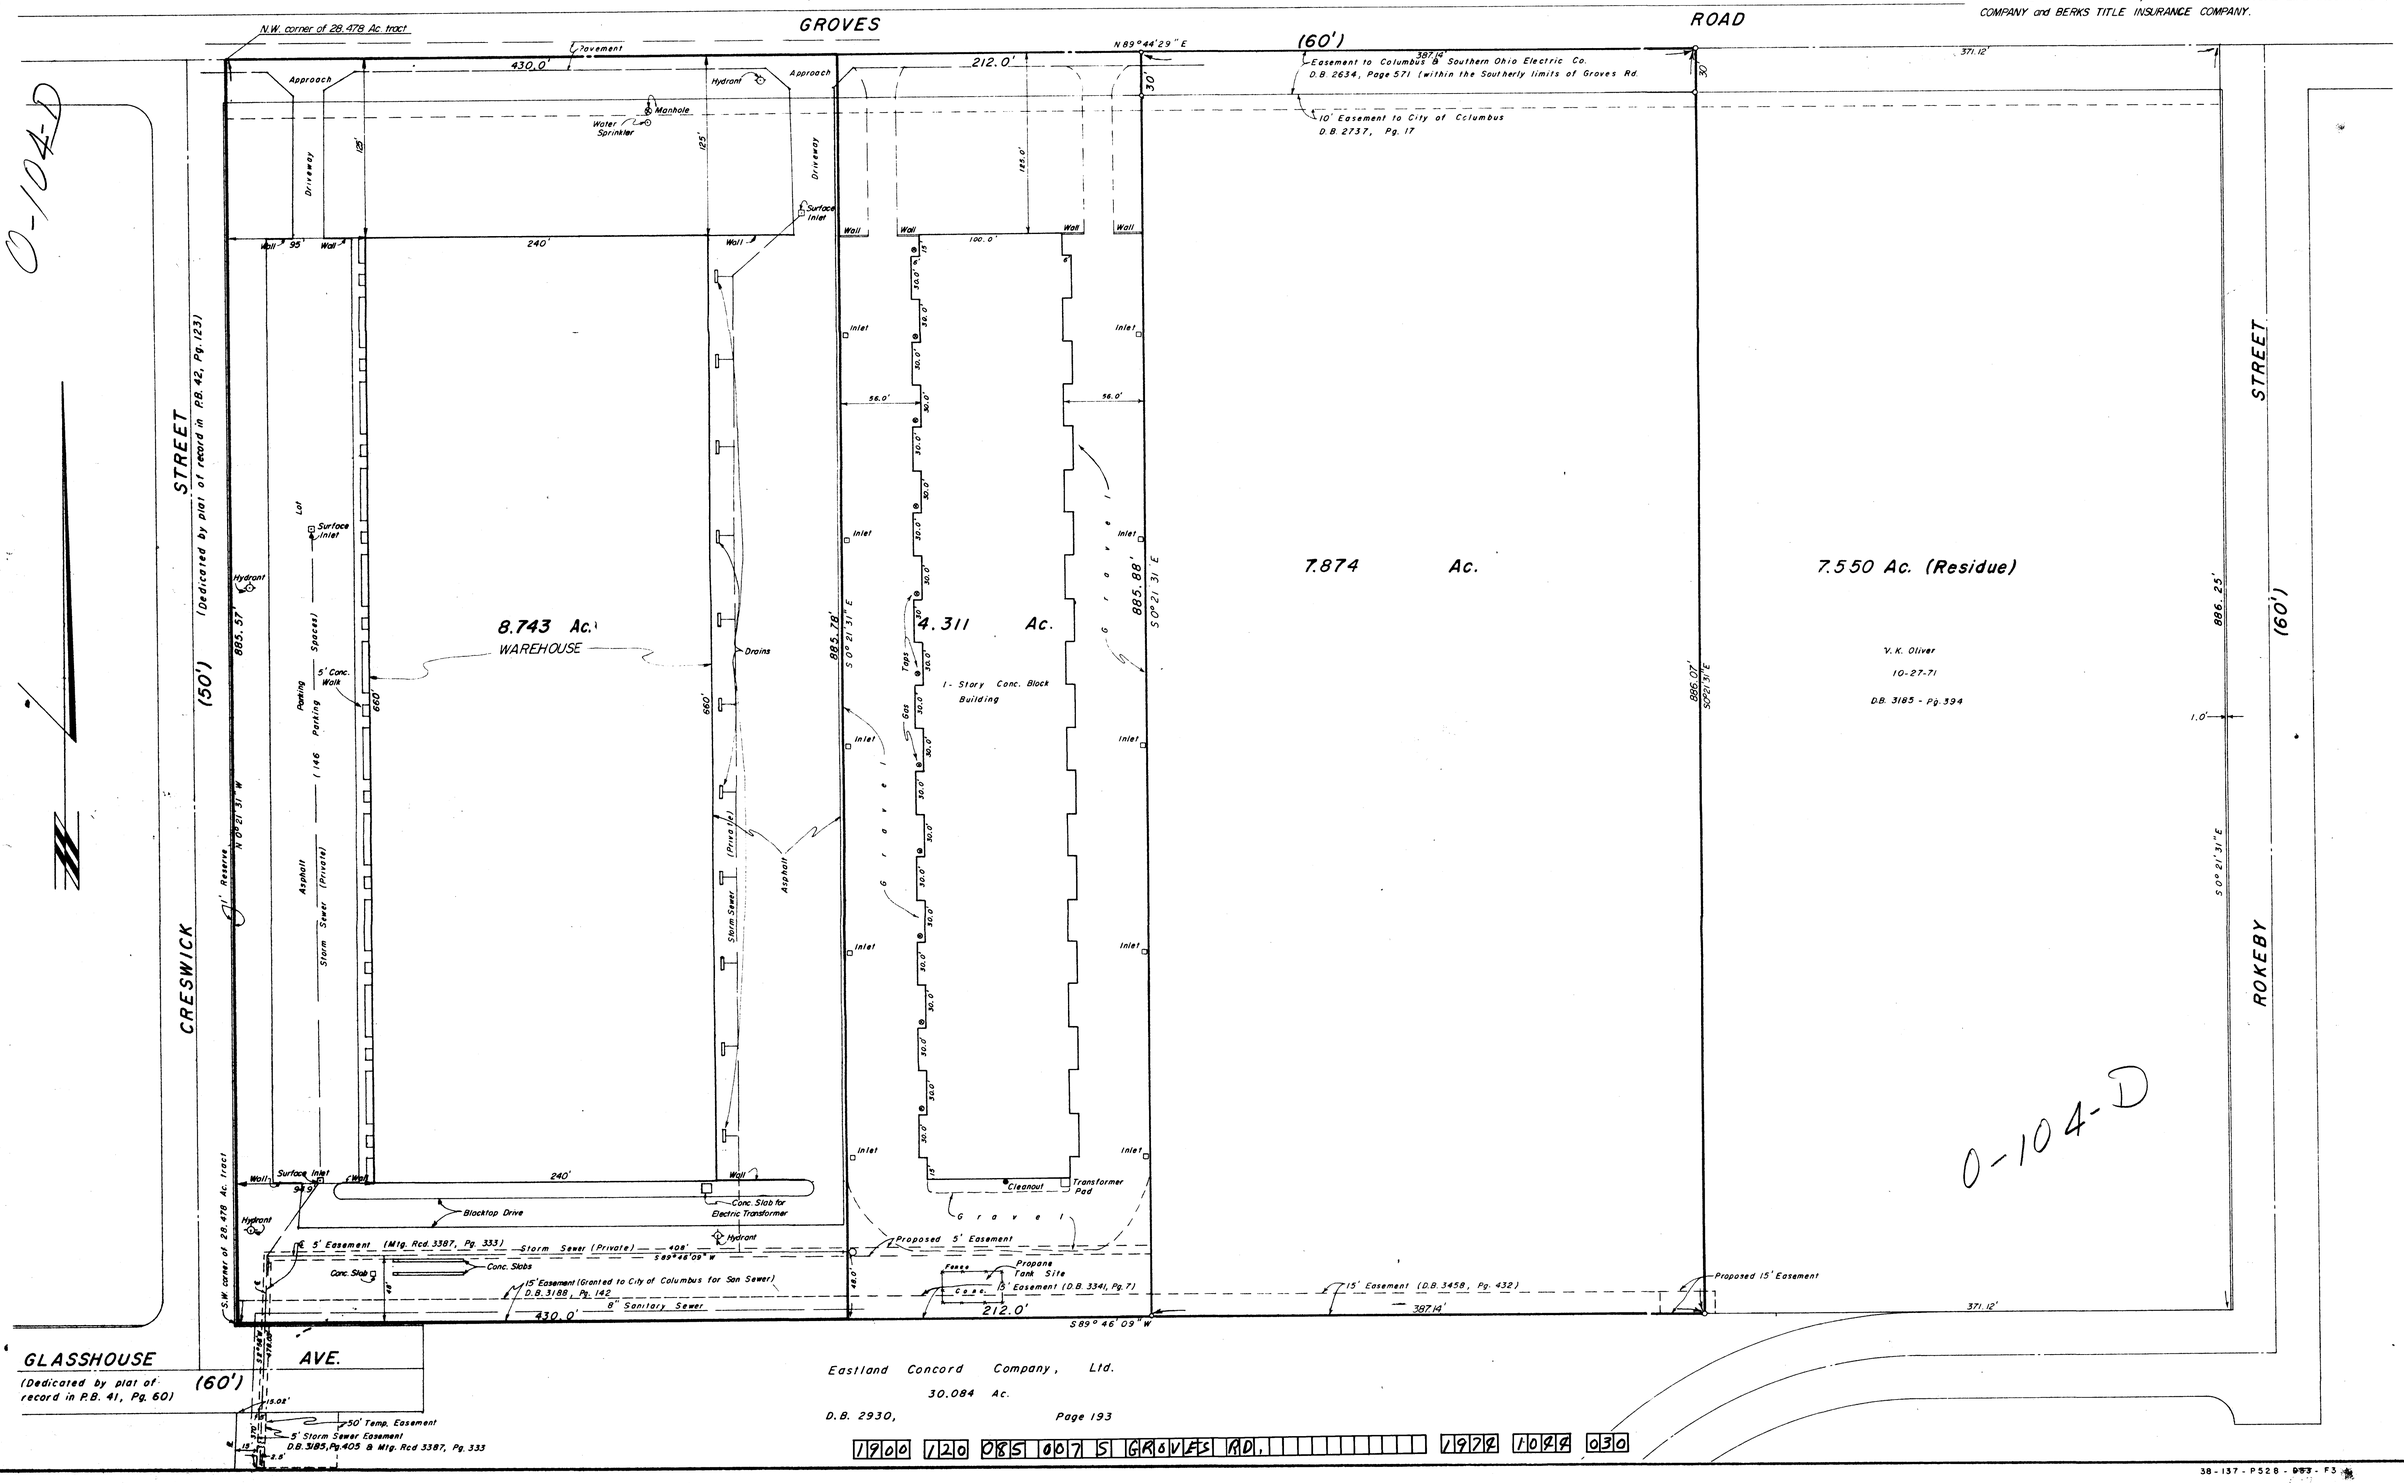


1900 120 085 007 5 GROVES RD. 1978 1088 030

38-137-P528-993-F3