


0-103 A

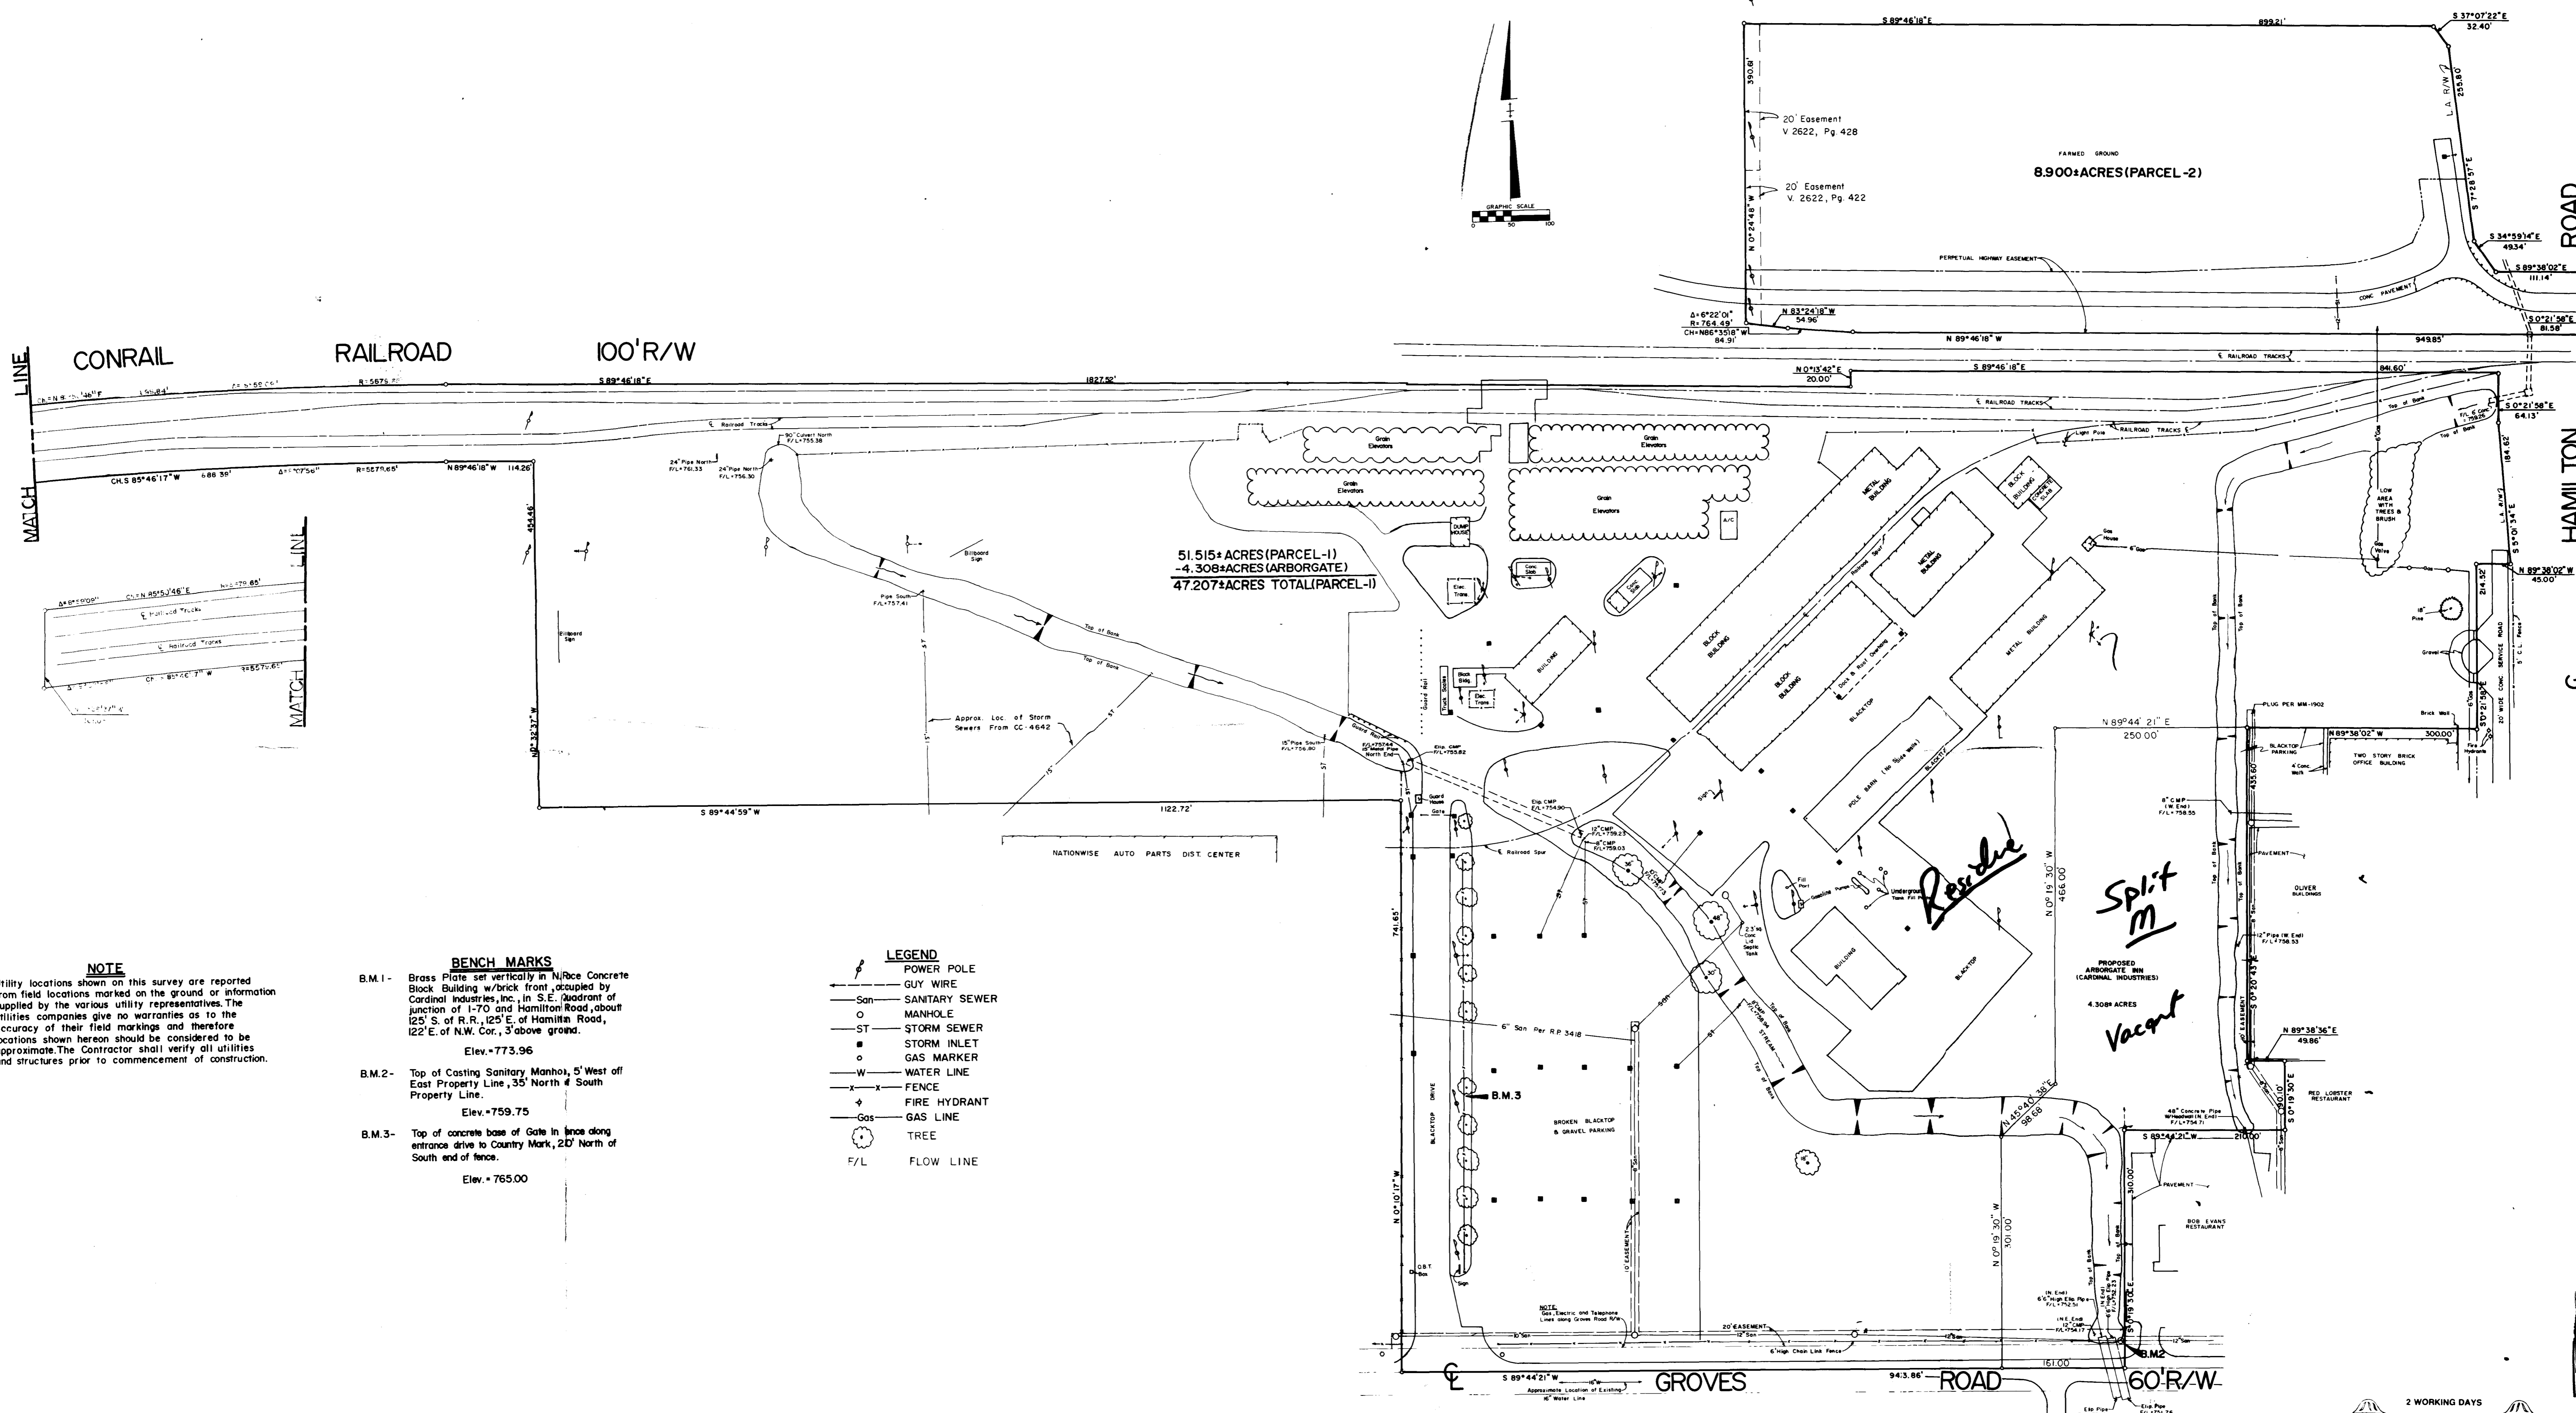

NOTE
 1) Utility locations shown on this survey are reported from field locations marked on the ground or information supplied by the various utility representatives. The utilities companies give no warranties as to the accuracy of their field markings and therefore locations shown hereon should be considered to be approximate. The Contractor shall verify all utilities and structures prior to commencement of construction.

- BENCH MARKS**
- B.M.1 - Brass Plate set vertically in Rice Concrete Block Building w/brick front, occupied by Cardinal Industries, Inc., in S.E. quadrant of junction of I-70 and Hamilton Road, about 125' S. of R.R., 125' E. of Hamilton Road, 122' E. of N.W. Cor., 3' above ground.
Elev. = 773.96
 - B.M.2 - Top of Casting Sanitary Manhole, 5' West of East Property Line, 35' North of South Property Line.
Elev. = 759.75
 - B.M.3 - Top of concrete base of Gate in fence along entrance drive to Country Mark, 20' North of South end of fence.
Elev. = 765.00

- LEGEND**
- POWER POLE
 - GUY WIRE
 - San — SANITARY SEWER
 - — MANHOLE
 - ST — STORM SEWER
 - — STORM INLET
 - — GAS MARKER
 - W — WATER LINE
 - X — FENCE
 - ◆ — FIRE HYDRANT
 - ◇ — GAS LINE
 - — TREE
 - F/L — FLOW LINE

Any information or data on this drawing is not intended to be suitable for reuse by any person, firm or corporation or any others on extensions of this project or for any use on any other project. Any reuse without written verification and admission by the Engineer, Architect or Surveyor for the specific purpose intended will be at the users sole risk and without liability or legal exposure to the Engineer, Architect or surveyor.

KA **KOSANCHICK & ASSOCIATES, INC.**
 CONSULTING ENGINEERS & SURVEYORS
 COLUMBUS, OHIO OFFICE:
 OLD COLUMBUS AIRPORT TERMINAL
 5000 EAST FIFTH AVENUE
 COLUMBUS, OHIO 43219
 PHONE: (614) 235-5550

COUNTRY MARK
 COLUMBUS, OHIO
 GROVES ROAD
SITE MAP

| | |
|-----------------------------------|------------------|
| 2 WORKING DAYS BEFORE YOU DIG | |
| CALL TOLL FREE 800-362-2764 | |
| OHIO UTILITIES PROTECTION SERVICE | |
| REV'D.: | DATE: APR 1997 |
| | SCALE: 1" = 100' |
| | DRAWN: D.A.S. |
| | CHECKED: M.A.H. |
| FILE: | SHEET: |
| 1850 | 2 |