

KEAN ROAD
TWP RD. 37

DEL. WOODS T.E. & F.W.							GATCHEL S.W. & S.E.			MARY P. JIMACKIN & FREDERICK LANZIG D.V. 369 R. 127			DAVID J. GENASKIE D.V. 465 R. 116				
LOT 202	LOT 201	LOT 200	LOT 199	LOT 198	LOT 197	LOT 196	LOT 195	LOT 194	LOT 193	LOT 192	LOT 191	LOT 190	LOT 189	LOT 188	LOT 187	LOT 186	LOT 185

HARLEM TOWNSHIP
DELAWARE COUNTY

FRANKLIN COUNTY

BEVELHEIMER ROAD
TOWNSHIP ROAD 92

15.048 ACRES

44.363 ACRES

37.221 ACRES

96.632 ACRES - TOTAL

SURVEY FOR
APOLON BARNHARD
PLAIN TOWNSHIP, FRANKLIN COUNTY, OHIO
RANGE 16 WEST TOWNSHIP 2 NORTH, SECTION 2
UNITED STATES MILITARY LANDS

HERSCHEL H. DENNER &
KENNETH J. DENNER
D.V. 3415 R. 423

RANDALL E. MARTIN &
JOHN E. MARTIN
D.V. 3523 R. 116

JAMES J. LYON III &
BERNICE B. LYON
D.V. 3629 R. 430

D.V. 1463 R. 401

JANE F. SCHALLE &
SRENDIA E. SCHALLE
D.V. 3413 R. 242

JOHN R. MOORE &
IRMA L. MOORE
D.V. 3410 R. 412

D.V. 3466 R. 518

MARK P. DARLING &
MARY L. DARLING
D.V. 3512 R. 128

STANYS R. BARNHARD
D.V. 3009 R. 115


I HEREBY CERTIFY THAT THE FOREGOING
DRAWING WAS PREPARED FROM AN
ACTUAL SURVEY OF THE PREMISES.

Charles J. Destefani
CHARLES J. DESTEFANI
PROFESSIONAL SURVEYOR NO. 5666



PREPARED BY
CHARLES J. DESTEFANI P.S.
811 N. HAMILTON ROAD
GAHANNA, OHIO 43230

KENNETH M. BEVELHYMER &
FLORENCE BEVELHYMER
D.V. 2038 R. 1-03

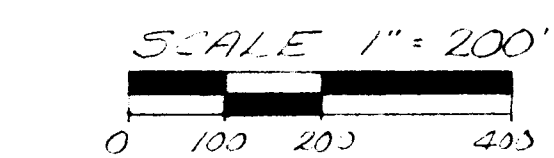

- LEGEND
- IRON PIN SET
 - IRON PIN FOUND
 - ▼ RAILROAD SPIKE

DRAWN BY: CJD
DATE: APRIL 20, 1987