

EVANS MECHWART HAMBLETON & TILTON

CIVIL ENGINEERS — SURVEYORS  
GAHANNA, OHIO

075

4500  
120  
033  
044  
S  
740  
M  
P  
S  
0  
W  
E  
H  
A  
M  
L  
T  
O  
N  
0757  
003

**SURVEY OF 25.039 ACRE TRACTS (2)**  
Located in Qtr. Tp. 3, Tp. 2, Range 16, U.S. Military Lands,  
Plain Township, Franklin County, Ohio.


SCALE 1" = 200'

o = Iron Pin  
July 16-17, 1959

DEED BOOK 1435, PAGE 210  
PLAT BOOK \_\_\_\_\_, PAGE \_\_\_\_\_

Revised April 18, 1961, to show 2 Ac. Tract  
Revised June 24, 1970

252 poles, 15 links  
to west line Plain Twp.

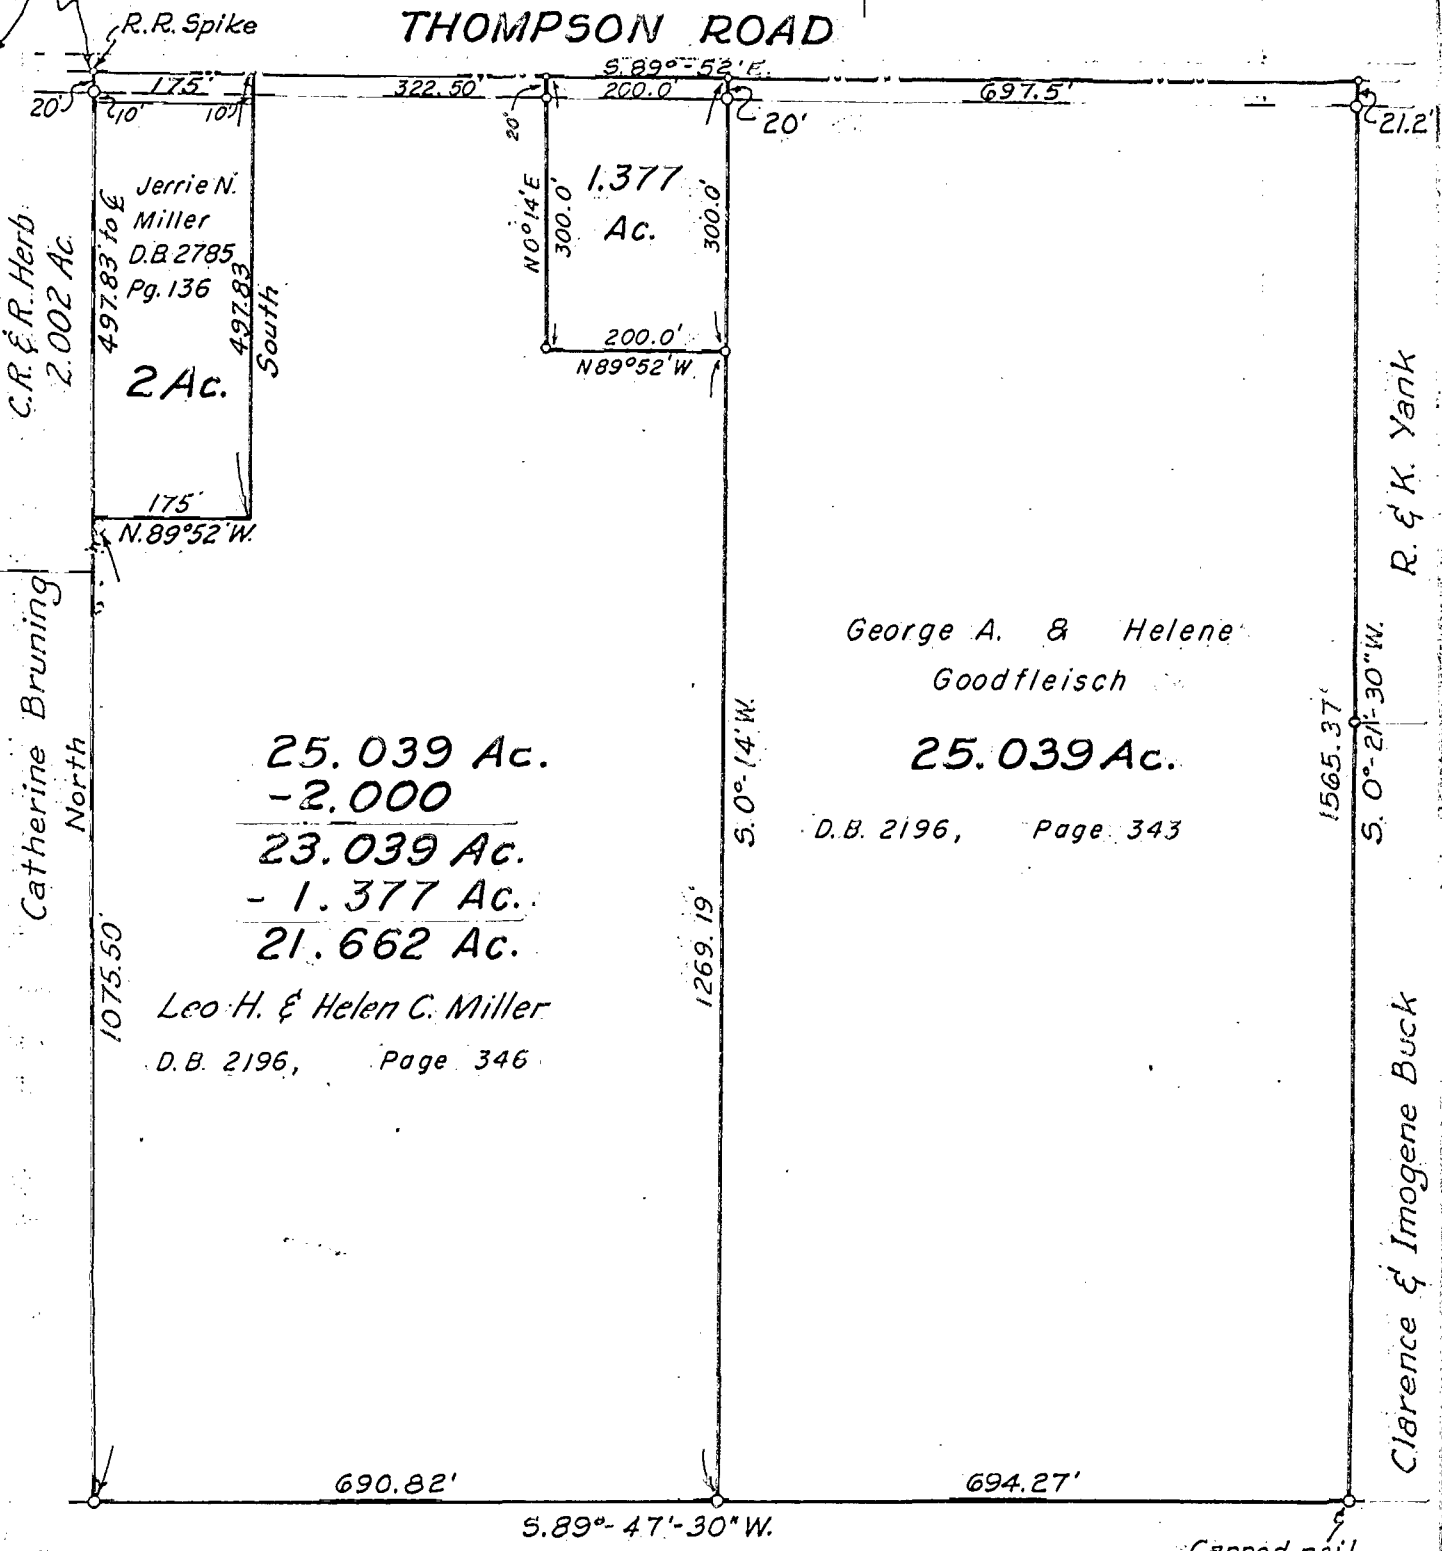

Marie L. Trenor

Capped nail  
on top of  
locust post.

We hereby certify that the foregoing plat was prepared from an actual survey of the premises and shows the location of the boundaries.

EVANS MECHWART HAMBLETON & TILTON

BY \_\_\_\_\_  
Registered Surveyor # 483

10398-59-407

187107500