

EVANS MECHWART HAMBLETON & TILTON

CIVIL ENGINEERS - SURVEYORS
GAHANNA, OHIO

187607500

075

SURVEY OF 1.496 ACRES & 10.006 ACRES

Being part of Lot 7, Reuben Baughman Subdivision
Located in the Third Quarter of Township 2, Range 16, U.S.M Lands
Plain Township, Franklin County, Ohio


SCALE 1" = 200'

o = Iron Pin
April 21, 1958

DEED BOOK 1776 PAGE
PLAT BOOK PAGE

SURVEY OF 5.084 Ac. & 5.10 Ac. Aug. 1959.

Sept. 10, 1959
DAD: 10.069 Acres
Par # 13 Plain Twp.

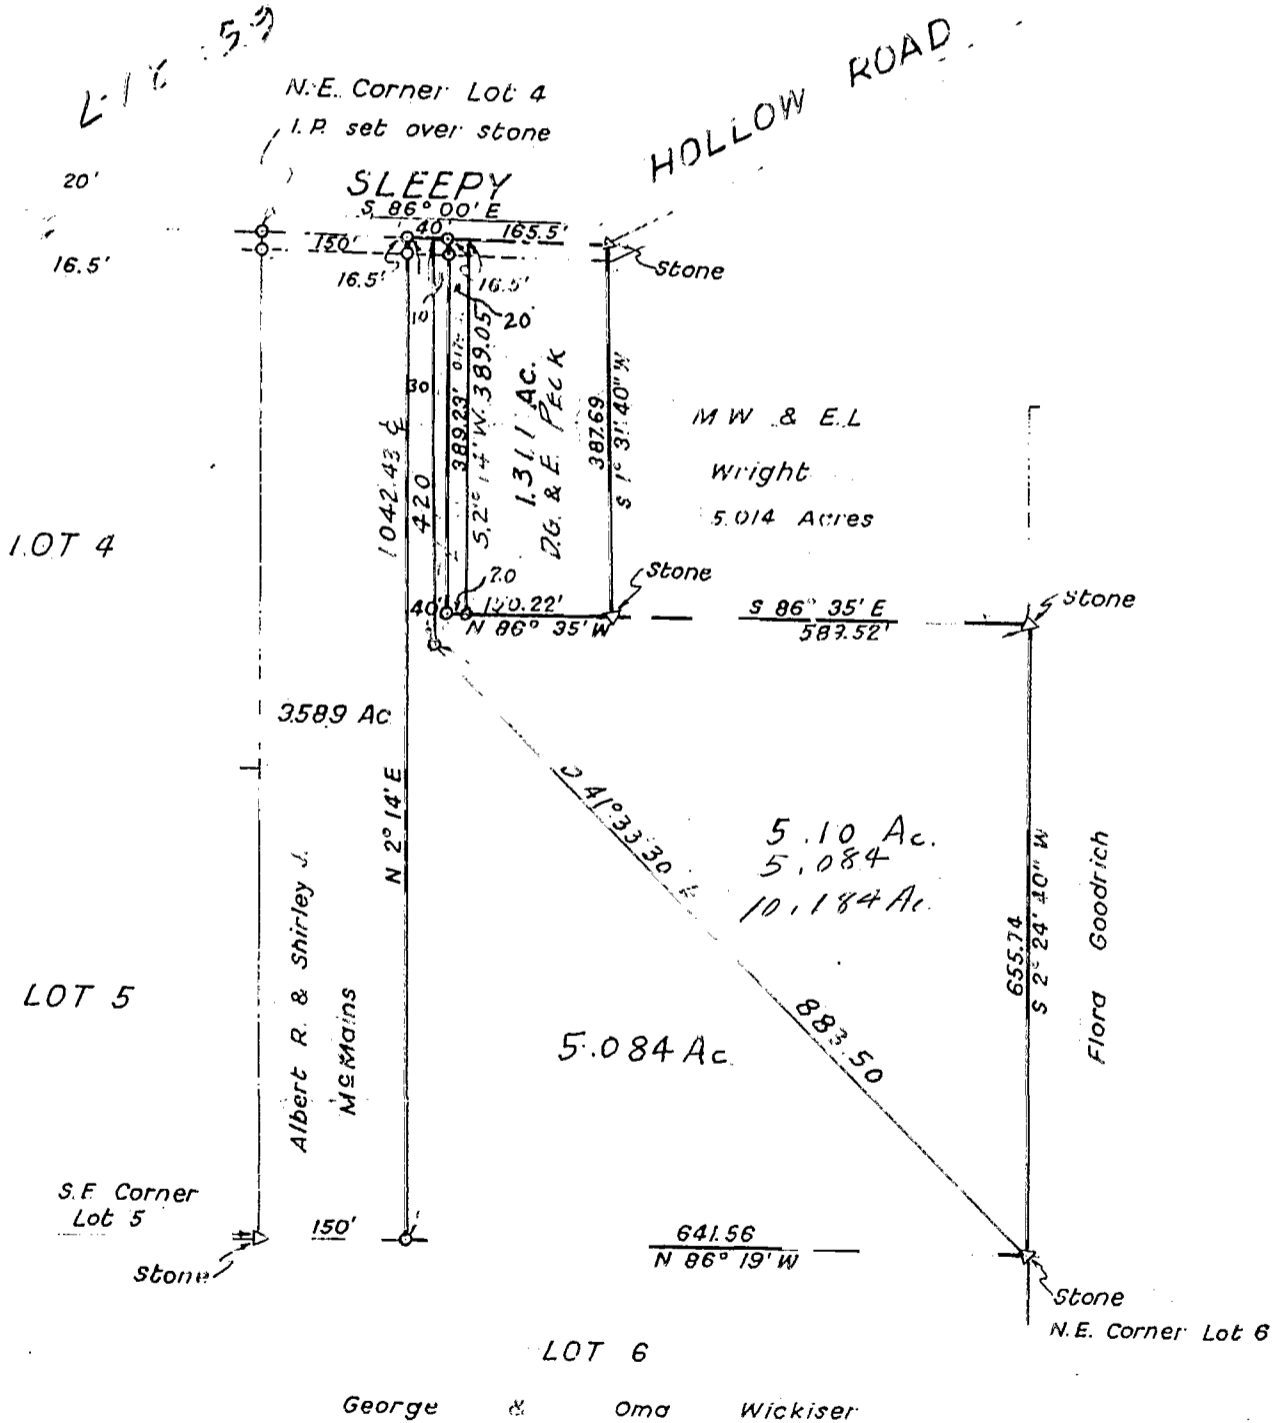

003
0759
1959
DR
SLEEPY
056
065
020
4176

We hereby certify that the foregoing plat was prepared from an actual survey of the premises and shows the location of the boundaries.

EVANS MECHWART HAMBLETON & TILTON
BY *[Signature]*
Registered Surveyor # 483

FOR JAMES H. & CHRISTINA A DIEHL