

# WANDA MECHWART HAMBLETON & TILTON, INC.

CONSULTING ENGINEERS - SURVEYORS  
GAHANNA, OHIO

8736 7600

0-75

## SURVEY OF 1.274 ACRE TRACT

Located in Section 3, Township 2, Range 16, U.S.M. Lands  
Plain Township, Franklin County, Ohio

003  
0758  
1969  
MORSE  
HORMAN  
CLARK  
051  
120  
1  
0750


SCALE 1" = 100'

May 13, 1968

DEED BOOK 1920, PAGE 287

DEED BOOK 2048, PAGE 162

0-75

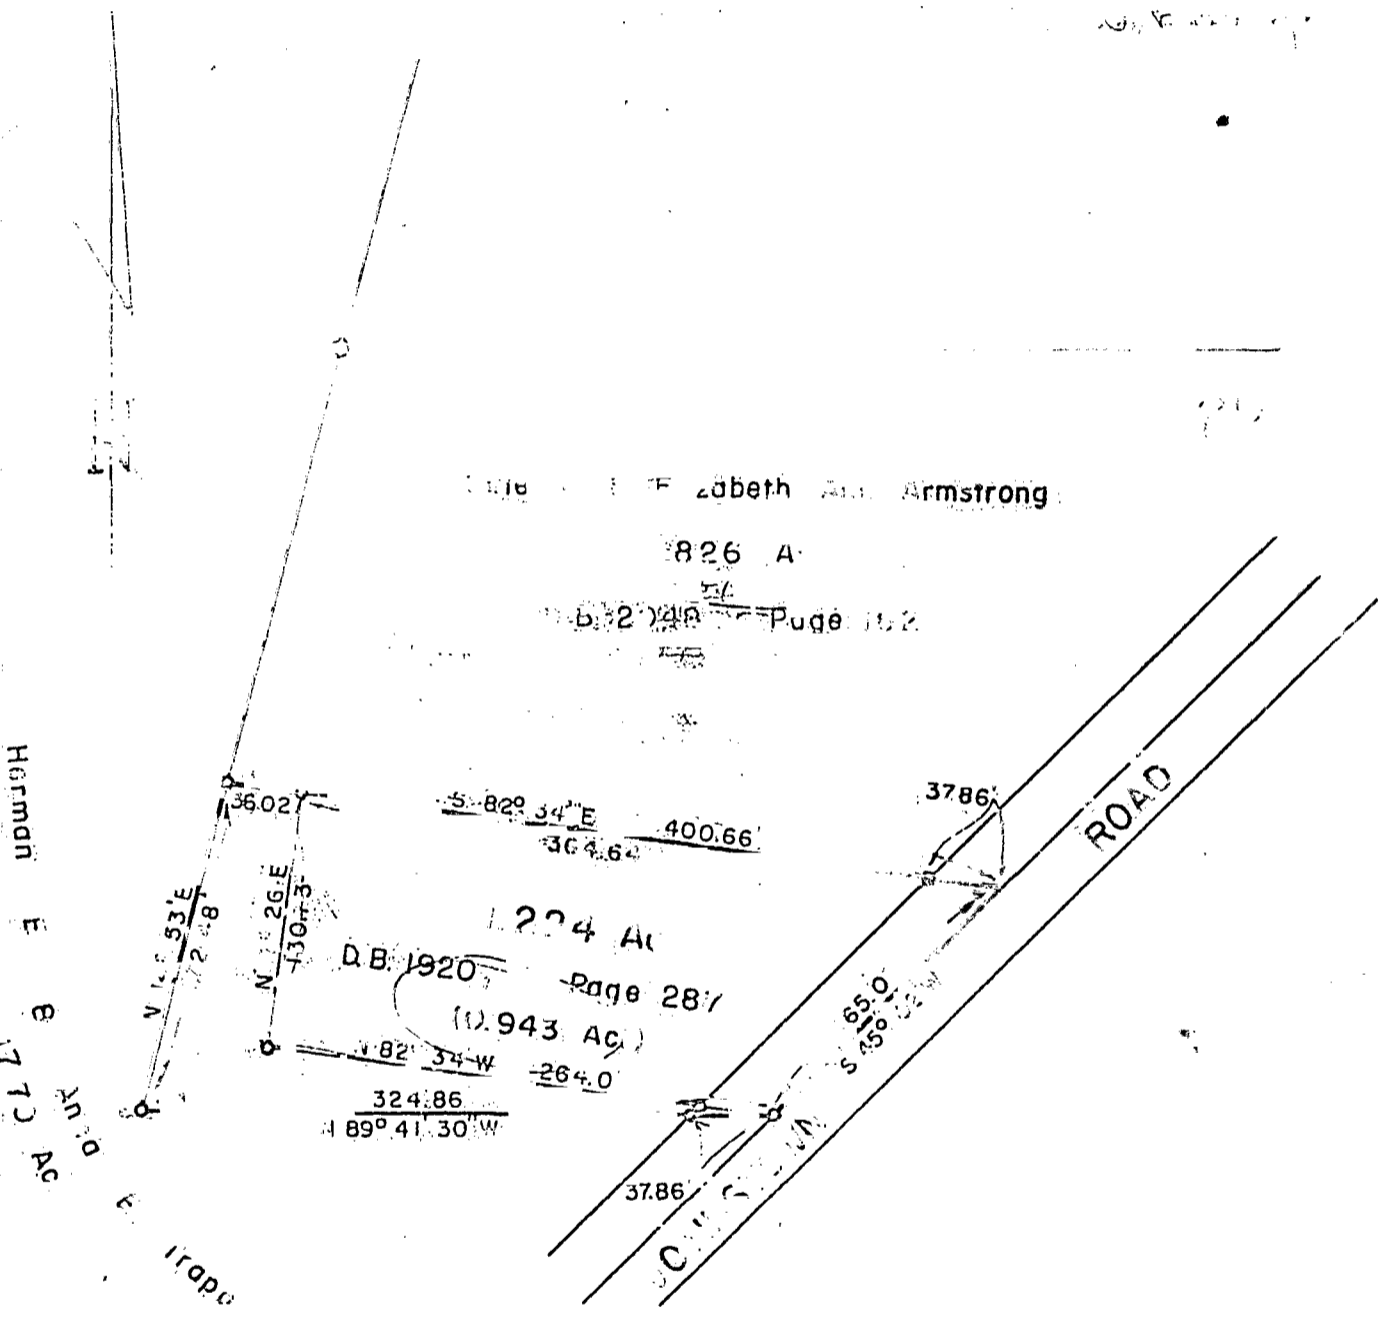

Deed of Elizabeth Ann Armstrong

826 A

b. 2048 Page 162

1.274 Ac

D.B. 1920, Page 287

(1.943 Ac.)

324.86  
N 89° 41' 30" W

37.86

ROAD

CLARK ROAD

182


WANDA MECHWART HAMBLETON & TILTON, INC.

*Wanda Mechwart*

REGISTERED SURVEYOR 1983