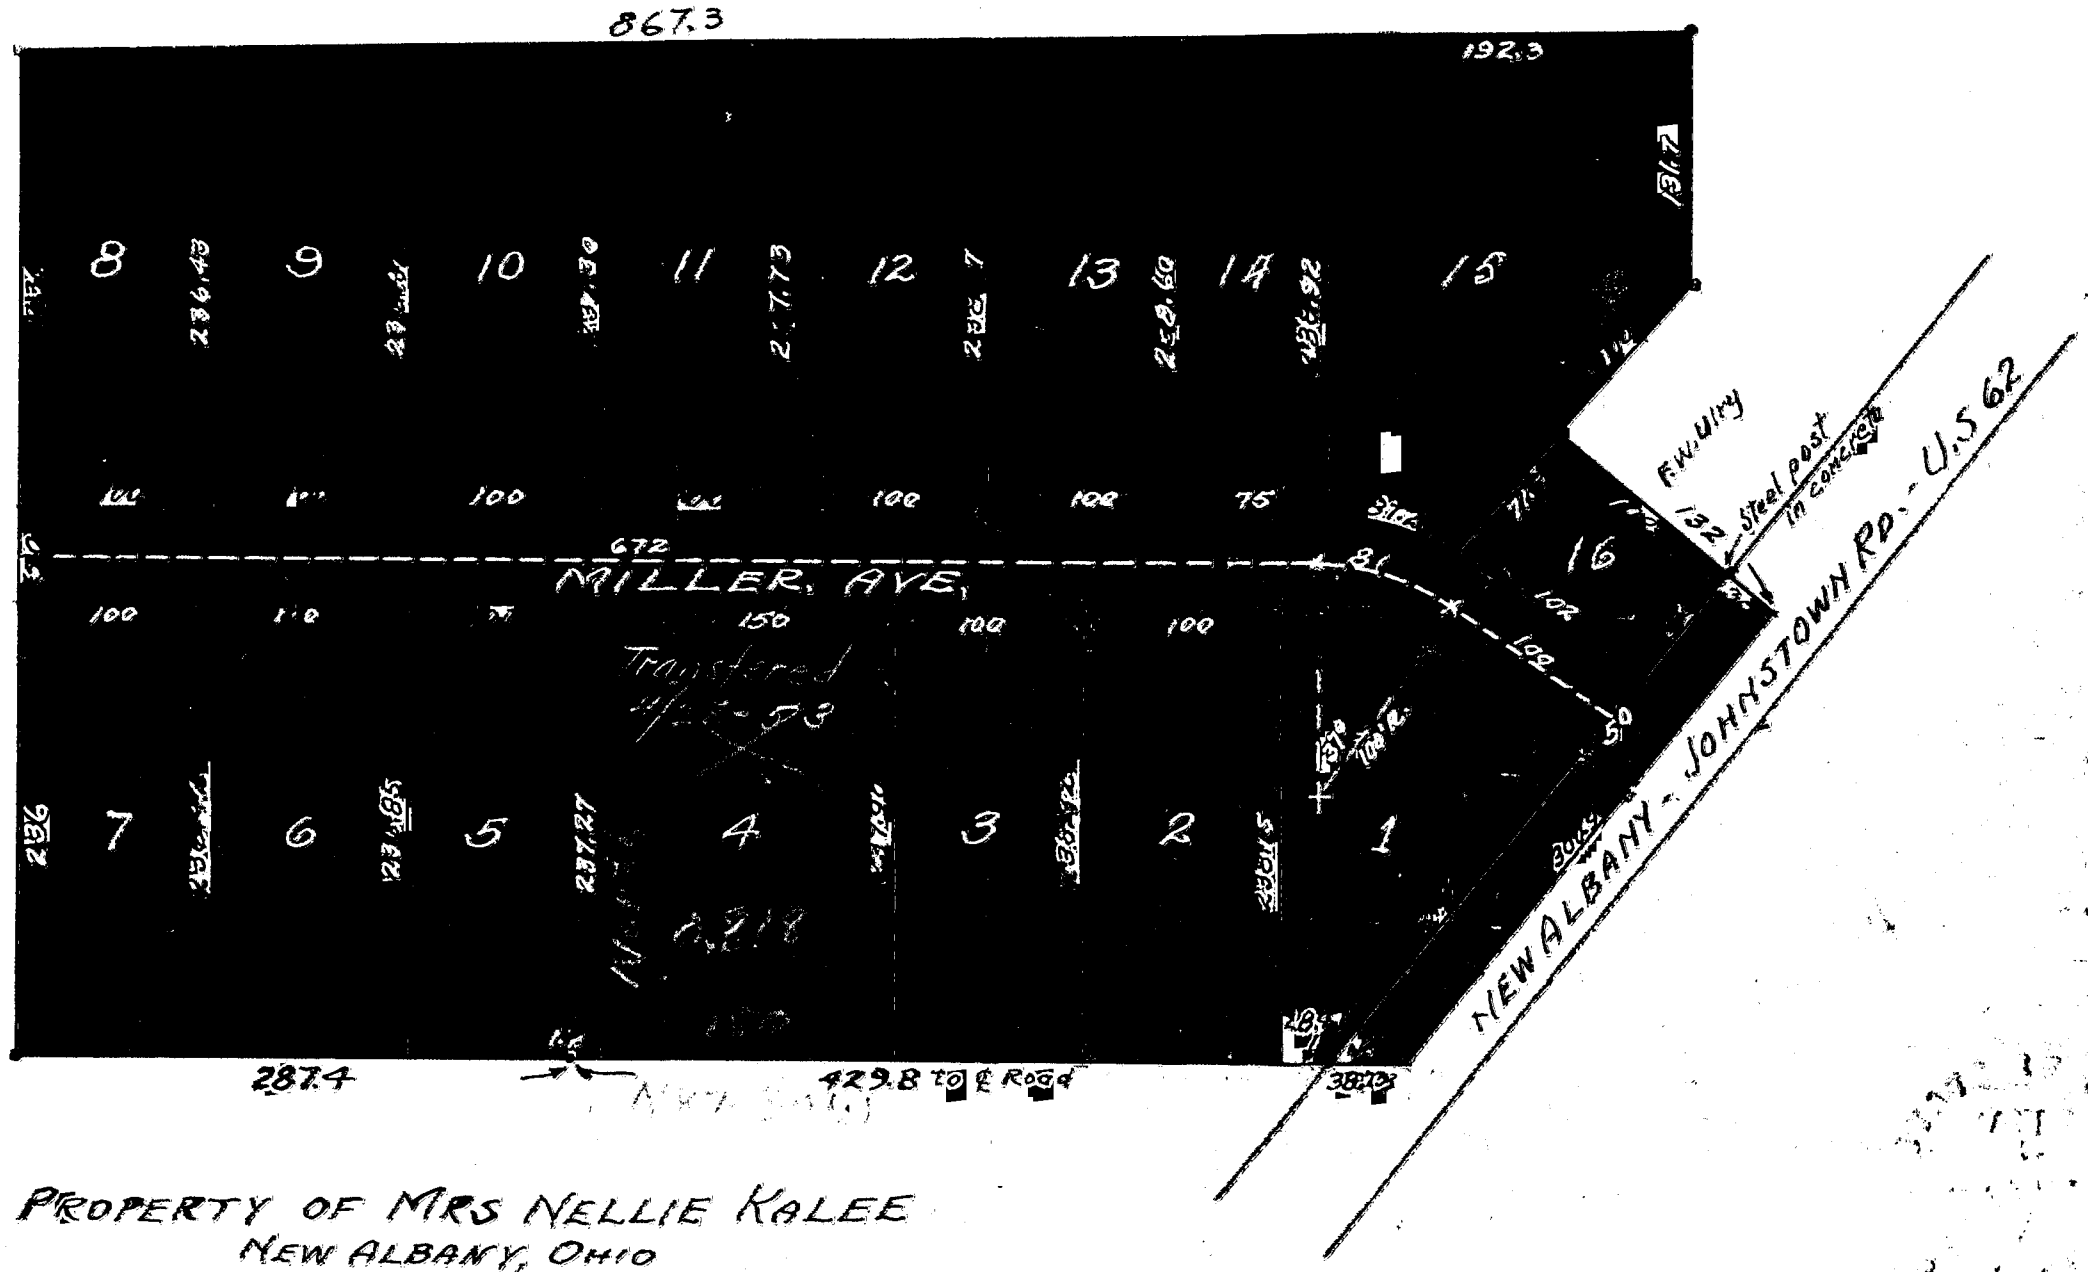

PROPERTY OF MRS NELLIE KALEE
NEW ALBANY, OHIO
PART OF LOT 39 - PLAIN TWP. - FRANKLIN CO. - OHIO - R16 - TP. 2.
Scale 1" = 100 ft.
NOV. 15, 1952
(Modified) MAR. 14, 1953

James A. McCloy
Surveyor 1202