

EVANS MECHWART HAMBLETON & TILTON, INC.

CONSULTING ENGINEERS - SURVEYORS
GAHANNA, OHIO

() 76 H

SURVEY OF ACREAGE PARCELS LOCATED IN

LOT NO. 18, QUARTER TOWNSHIP 4, TOWNSHIP 2, RANGE 16, U. S. M. LANDS
PLAIN TOWNSHIP, FRANKLIN COUNTY, OHIO

FEBRUARY 8, 1971

O = IRON PIN


DEED BOOK 1343 , PAGE 7

PLAT BOOK _____ , PAGE _____

SCALE 1" = 100'

003
078
197
15
E
W
069
100
120
0130

0-18-1/2

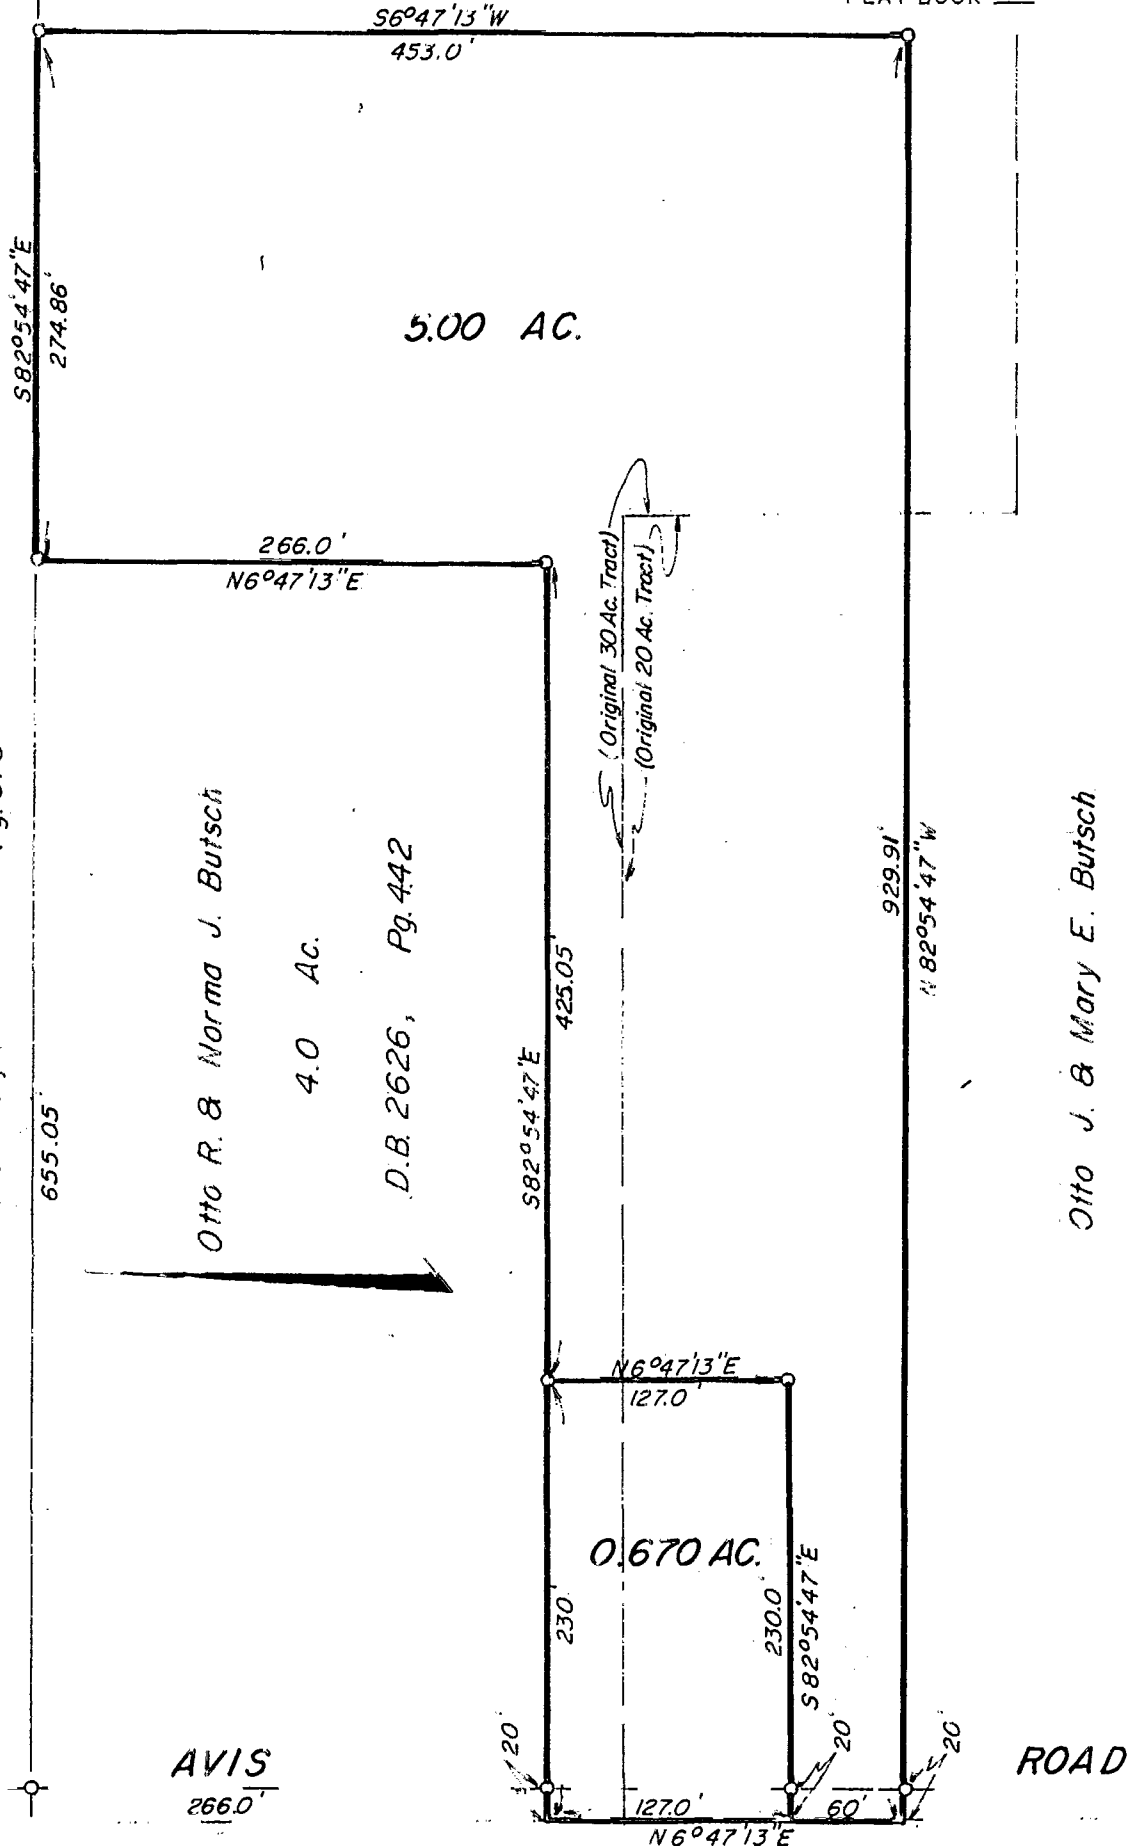

Frederick E. Jones
107.358 Ac.

Pg. 675

D.B. 2611,

655.05

Otto R. & Norma J. Butsch

4.0 Ac.

D.B. 2626, Pg. 442

425.05

(Original 30 Ac. Tract)
(Original 20 Ac. Tract)

Otto J. & Mary E. Butsch

AVIS
266.0'

ROAD

We hereby certify that the foregoing plat was prepared from an actual survey of the premises and shows the location of the boundaries

188607500

EVANS MECHWART HAMBLETON & TILTON, INC.

BY Otto J. Mechwart
Registered Surveyor No. 4072

~~188607500~~ 7/15