


Columbus, Ohio


N 134

Survey of Lot 19 of SUNBURY DOWNS No. 2, Plat book 27, page 59, Also a 0.250 acre tract adjoining lot 19. Located in the City of Columbus, Franklin County, Ohio.

for; William E. & Mary L. Gorth

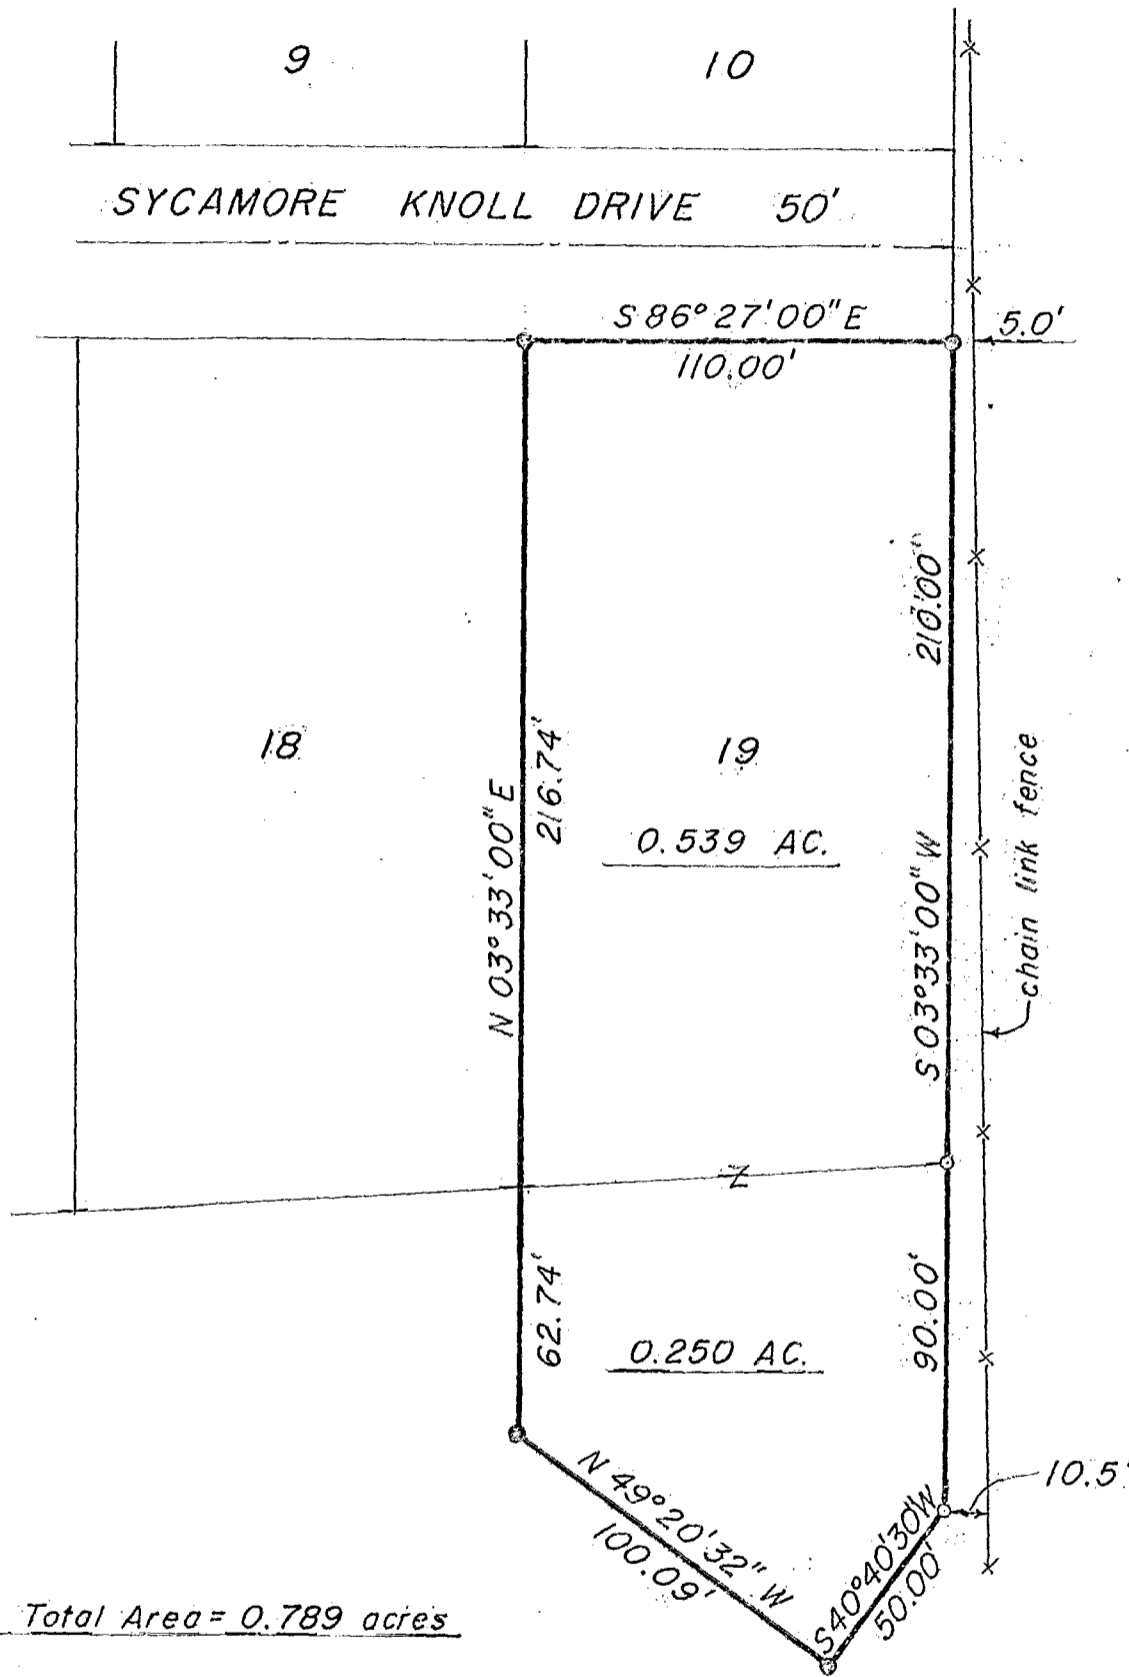


Mifflin High School

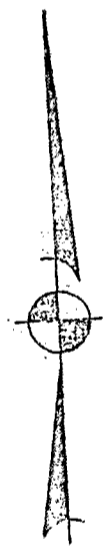

Total Area = 0.789 acres

- I.P. FOUND
- IRON PIN SET 3/4" X 30"

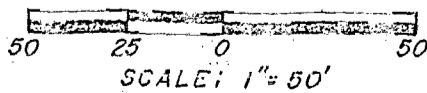

I DO HEREBY CERTIFY THAT THE FOREGOING PLAT WAS PREPARED FROM AN ACTUAL SURVEY OF THE PREMISES.

BY: *Walter C. Dawson* Apr 27, 1979