

NORTHLAND SURVEYING COMPANY

186857450
M 94-JW

4725-87


ORDER NO.

614-895-1522

CERTIFIED TO M. I. HOMES & ANY TITLE COMPANY COUNTY OF FRANKLIN
 LENDER CITIFED MORTGAGE P.B. _____ PG. _____ D.B. _____ PG. _____
 SCALE 1: 30' DATE 10-5-87 BUYER STAFFORD




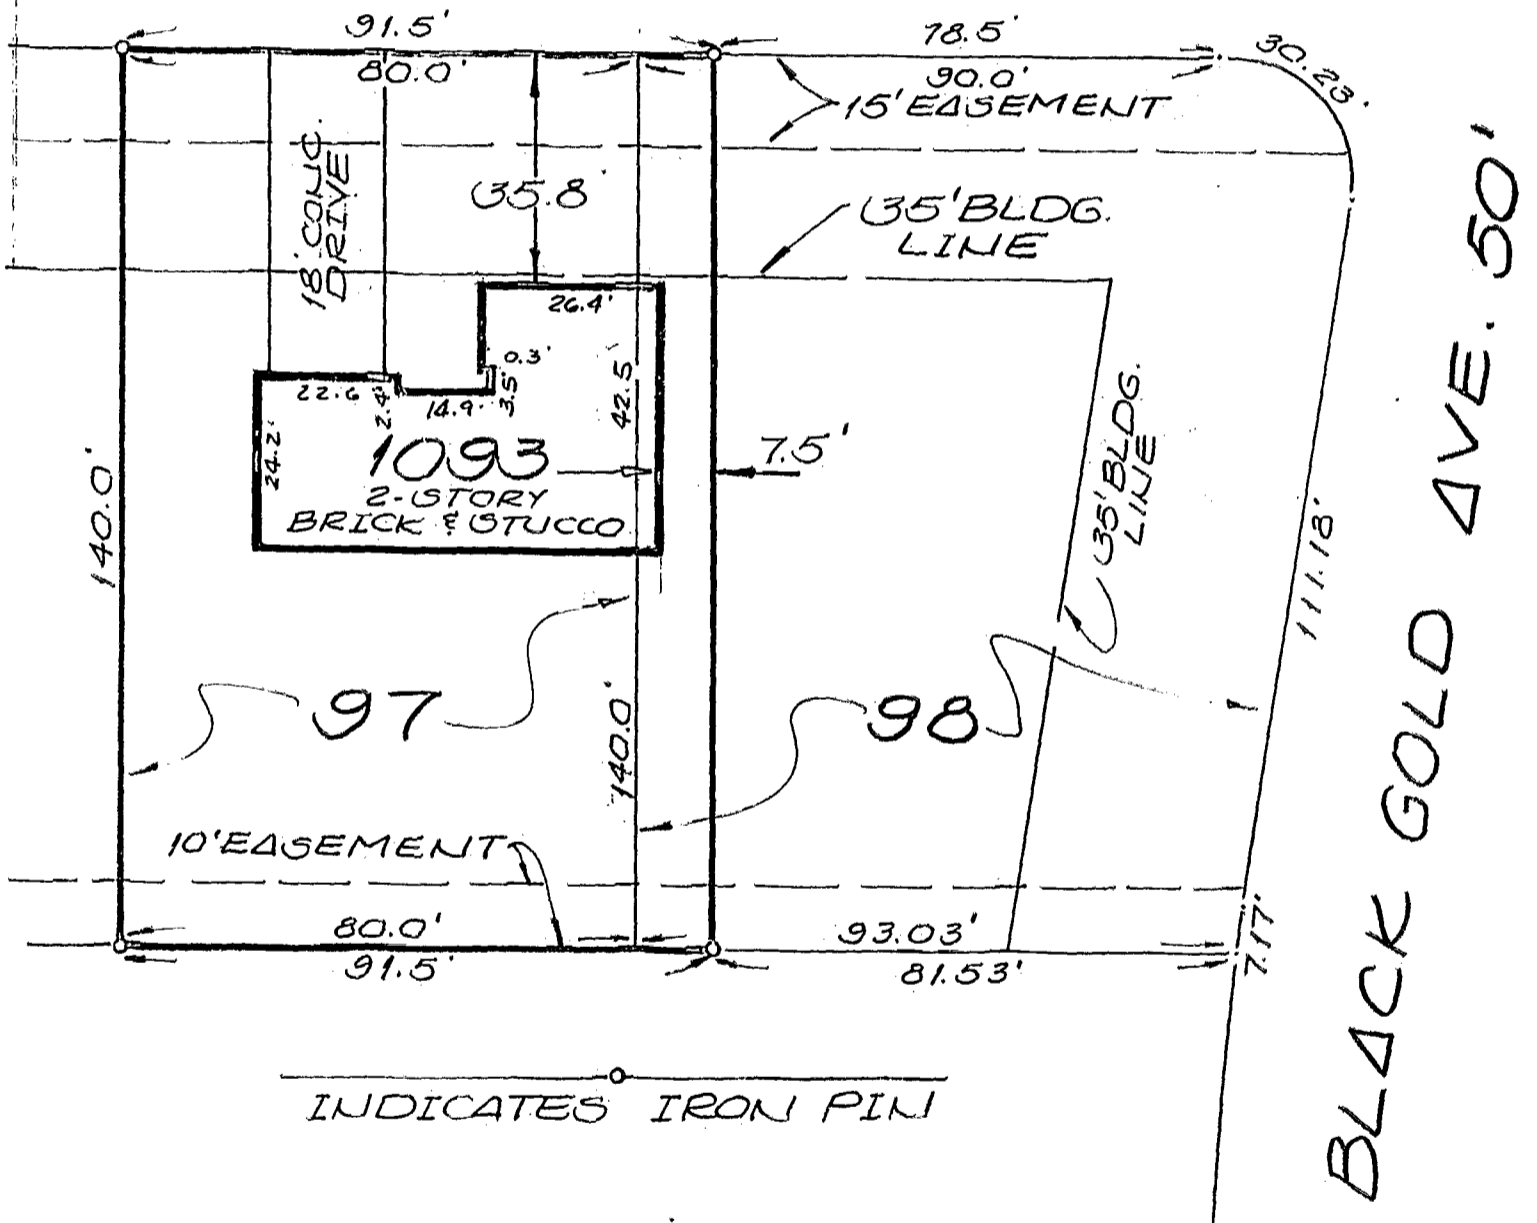


INDICATES IRON PIN

LOT NO. 97 & 11.5' OFF THE NORTH SIDE OF LOT NO. 98 BRYN MAWR SECTION NO. 1 GAHANNA, OHIO

We hereby certify that the foregoing plat was prepared from an actual survey of the premises and correctly shows the location of the building or buildings including any drives.

Northland Surveying Company

COLUMBUS, OHIO 43029

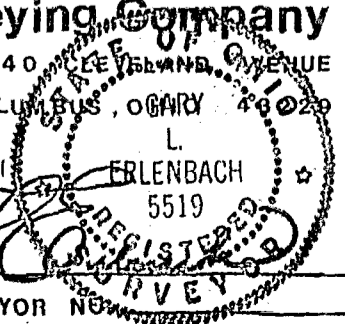

BY [Signature]
REGISTERED SURVEYOR NO. _____

Subject to all rights-of-way, easements and restrictions, if any, of previous record.