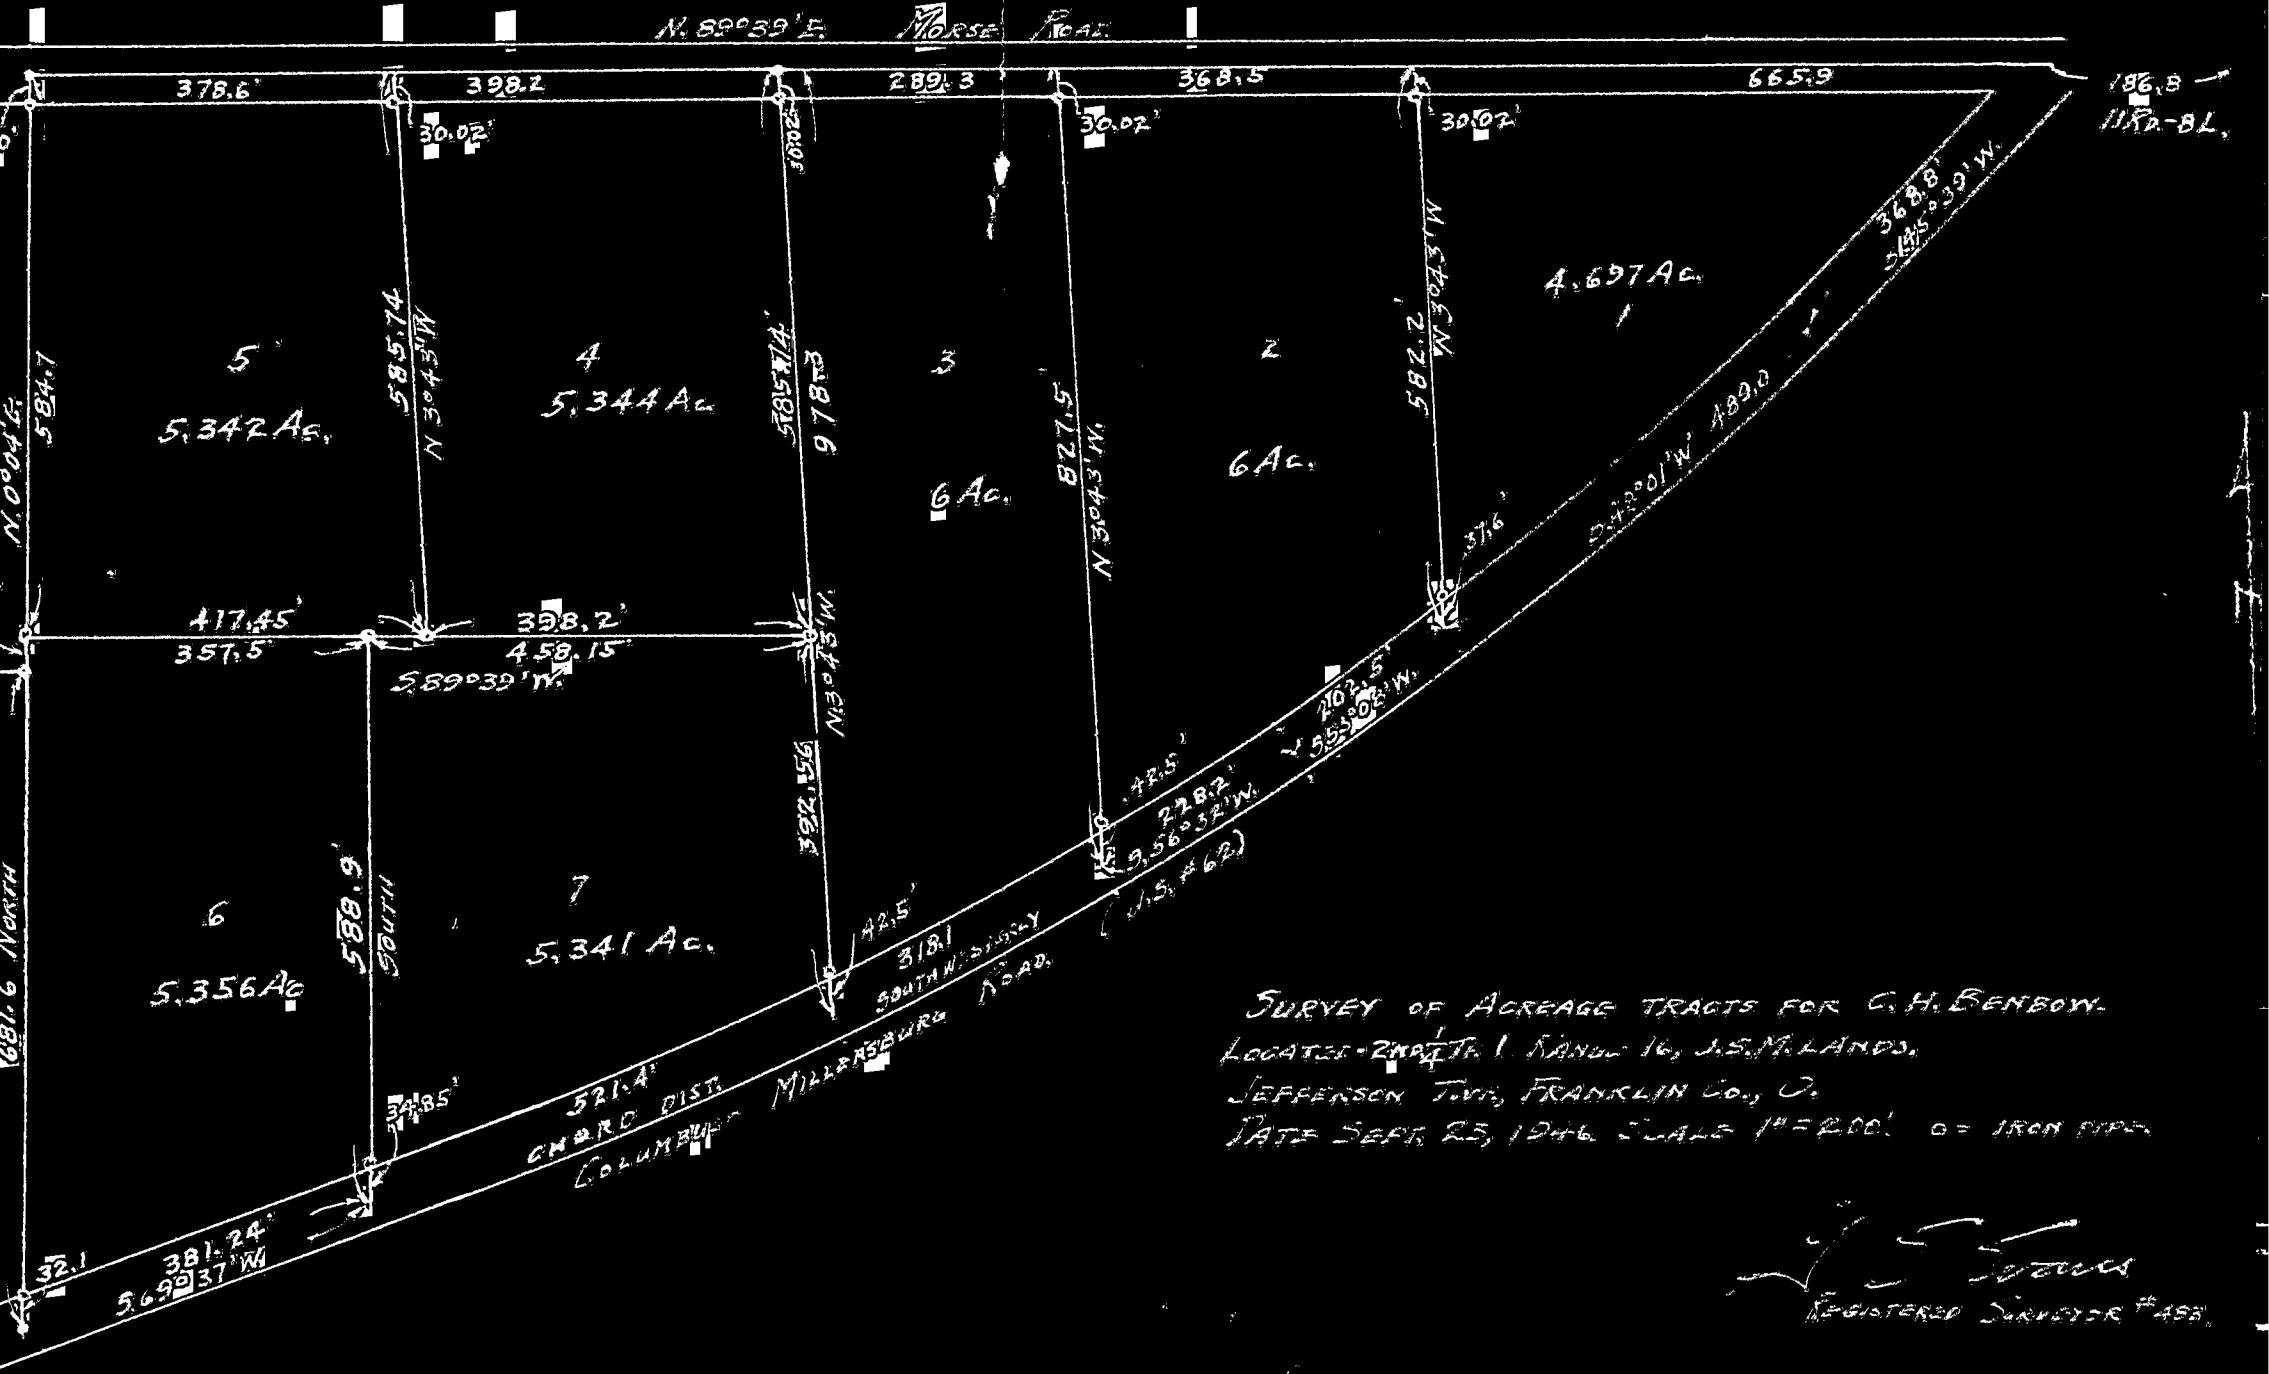

0920 120 091 113 S MORSE RD. 1946 0372 030