

EVANS MECHWART HAMBLETON & TILTON, INC.

CONSULTING ENGINEERS - SURVEYORS
GAHANNA, OHIO


SURVEY OF 2.021 ACRE TRACT

Located in Quarter Township 2, Township 1, Range 16
United States Military Lands
Jefferson Township, Franklin County, Ohio

SCALE 1" = 80'

o = Iron Pin
June 22, 1967

DEED BOOK 2809, PAGE 53
PLAT BOOK _____, PAGE _____

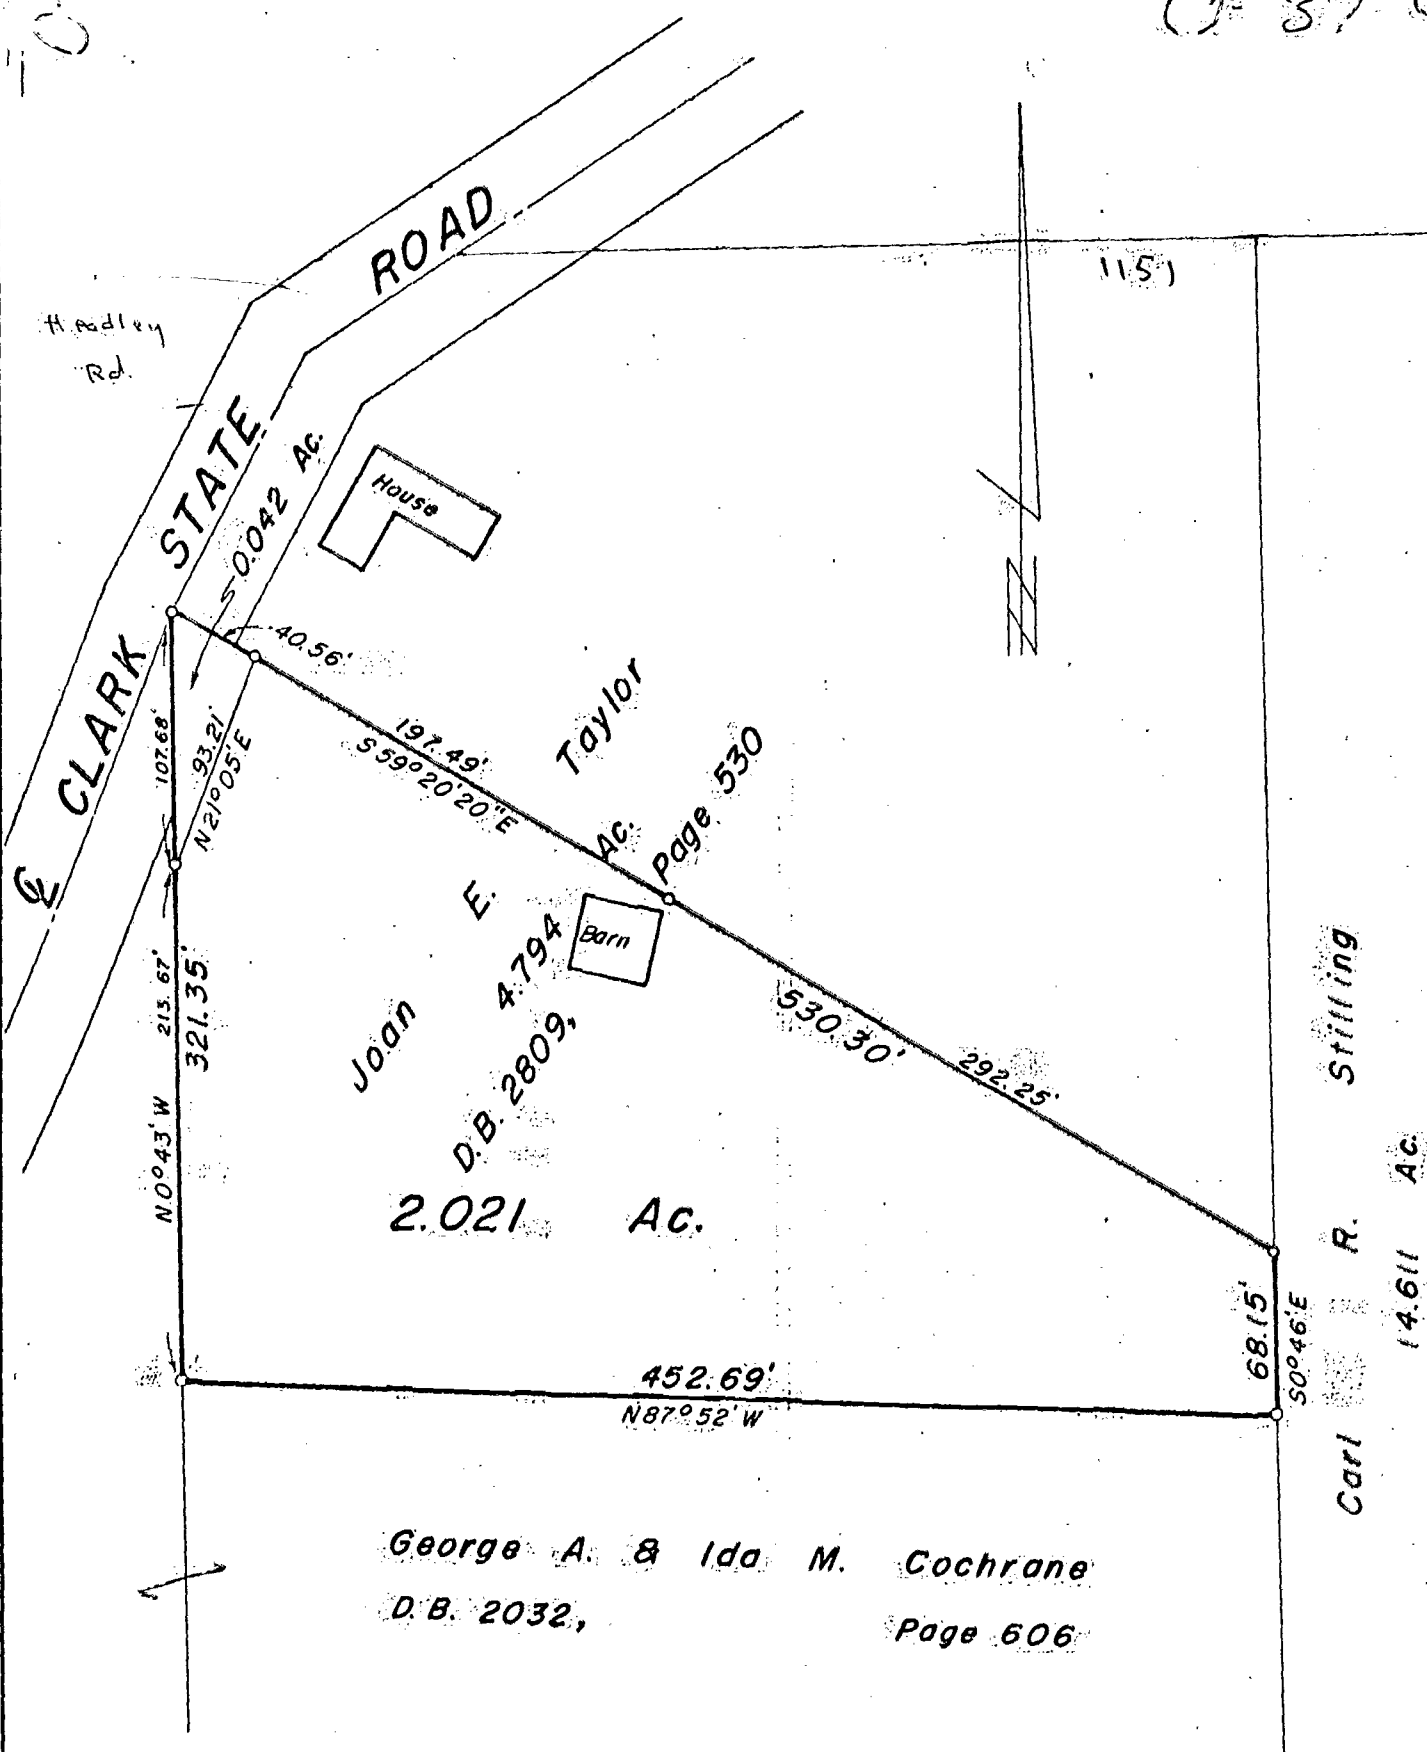

We hereby certify that the foregoing plat was prepared from an actual survey of the premises and shows the location of the boundaries.

EVANS MECHWART HAMBLETON & TILTON, INC.

BY: *J. Evans*
Registered Surveyor # 483

87657405

0730 1120 045 020 E CLARK STATE RD 11967 0373 030

Page 0-37


