188107473

CIVIL ENGINEERS - - SURVEYORS
GAHANNA, OHIO

0-16-6

SURVEY OF 1 ACRE TRACT LOCATED IN LOT 32, 4TH. QTR, T.P.2, R. 16, U.S.M. LANDS, FRANKLIN COUNTY, OHIO.

SCALE 1" = 80' 4-25-56 ∘ = IRON PIN DEED BOOK 1672, PAGE 22

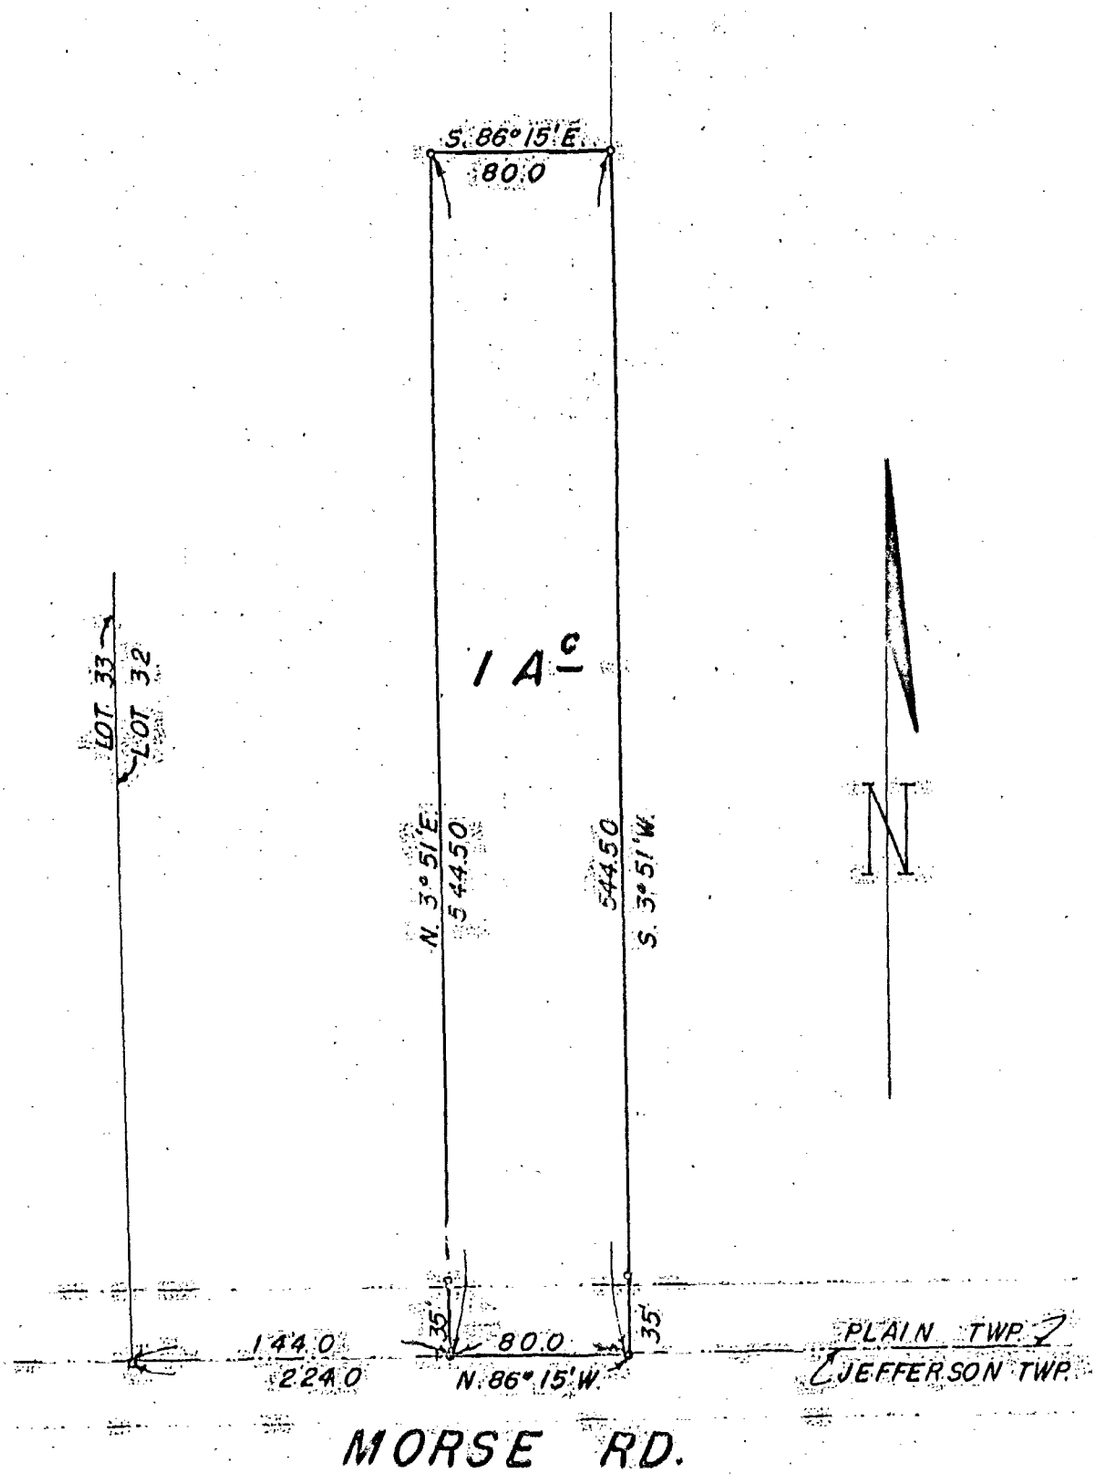


We hereby certify that the foregoing plat was prepared from an actual survey of the premises and shows the location of the boundaries.

EVANS & MECHWART

BY. Registered Surveyor # 483

3140 1120 0671 0008 M MORSE RD KITZMILLER 1956 0767 003