O-38 A

SURVEY FOR
GENE BRIGGS
LOCATION
JEFFERSON TOWNSHIP - FRANKLIN COUNTY
RANGE 16 - TOWNSHIP 1 - QTR. TWP. 1 - LOT 33

Scale 1" = 100' Date 10-10-73 P.B. ____ P. ____ D.V. 1290 P. 178 Lot No. 33

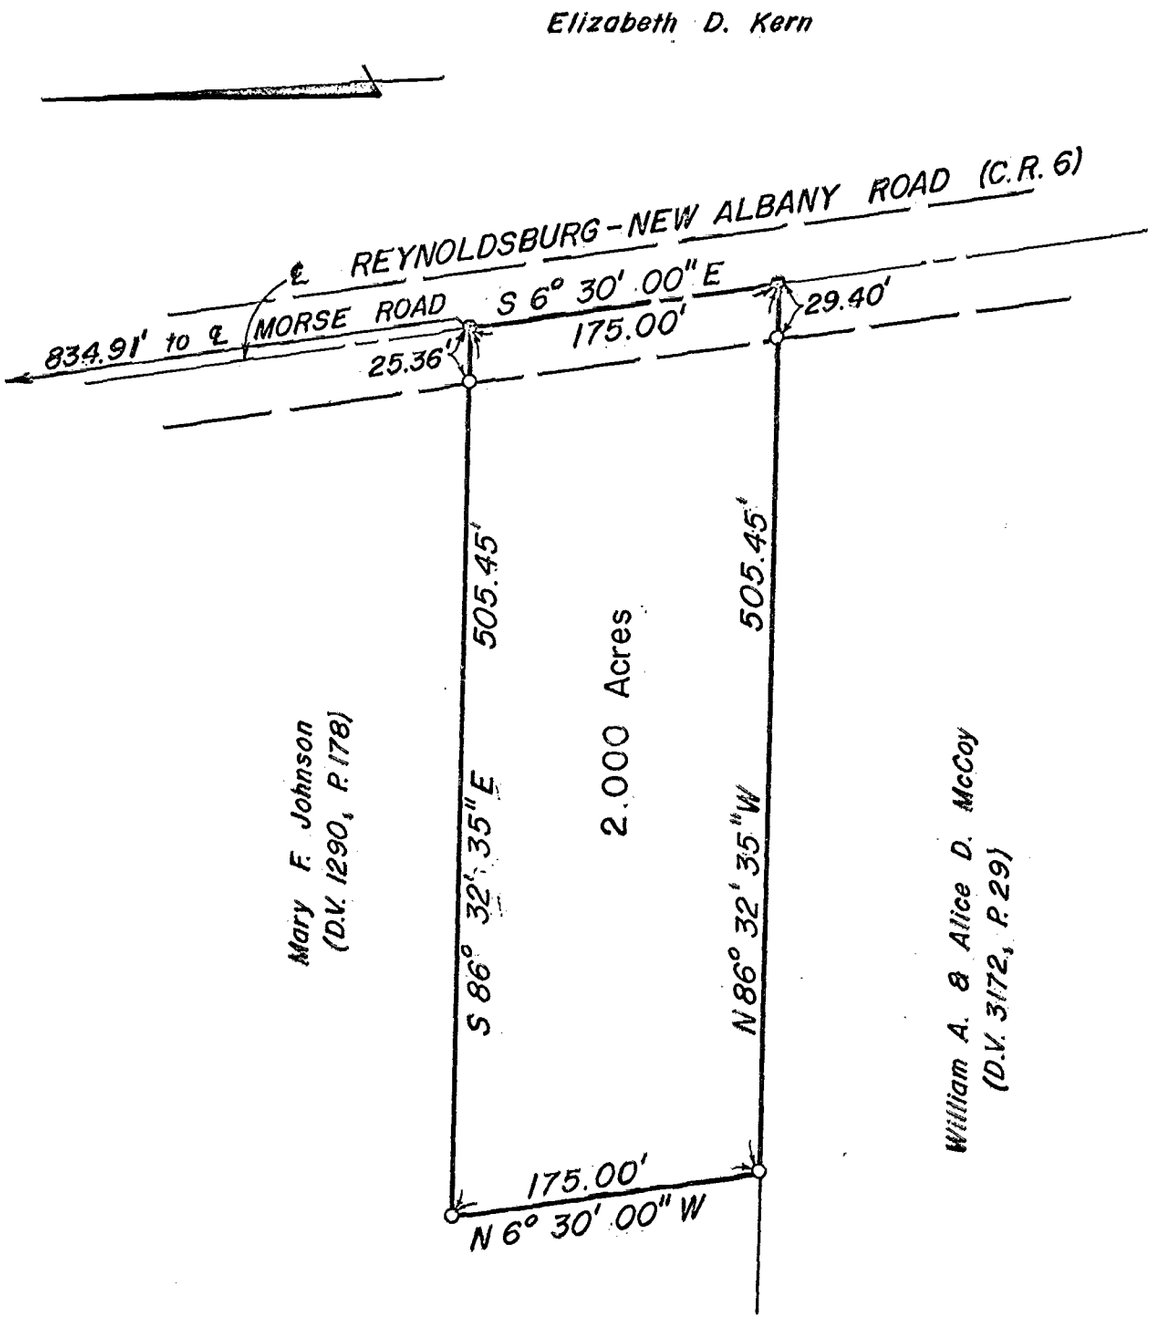

o - IRON PIN
o - SPIKE

STATE OF O
HENRY LELAND KUNZE 5219
REGISTERED SURVEYOR

I hereby certify that the foregoing drawing was prepared from an actual survey of the premises.

Drawn by M.F.K.

Henry L. Kunze
Registered Surveyor No. 5219

KUNZE and ASSOCIATES, INC.
CIVIL ENGINEERS AND LAND SURVEYORS
6912 SUNBURY ROAD, WESTERVILLE, OHIO 43081