0766

SURVEY FOR
MARY TOBIN
RANGE 16, TOWNSHIP 2, QUARTER TOWNSHIP 4, LOT 31, USML.
PLAIN TOWNSHIP, FRANKLIN COUNTY, OHIO

Scale 1"= 100' Date 4-9-1986 P.B.____ P.____ D.V. 1375 P. 270 Lot No.____

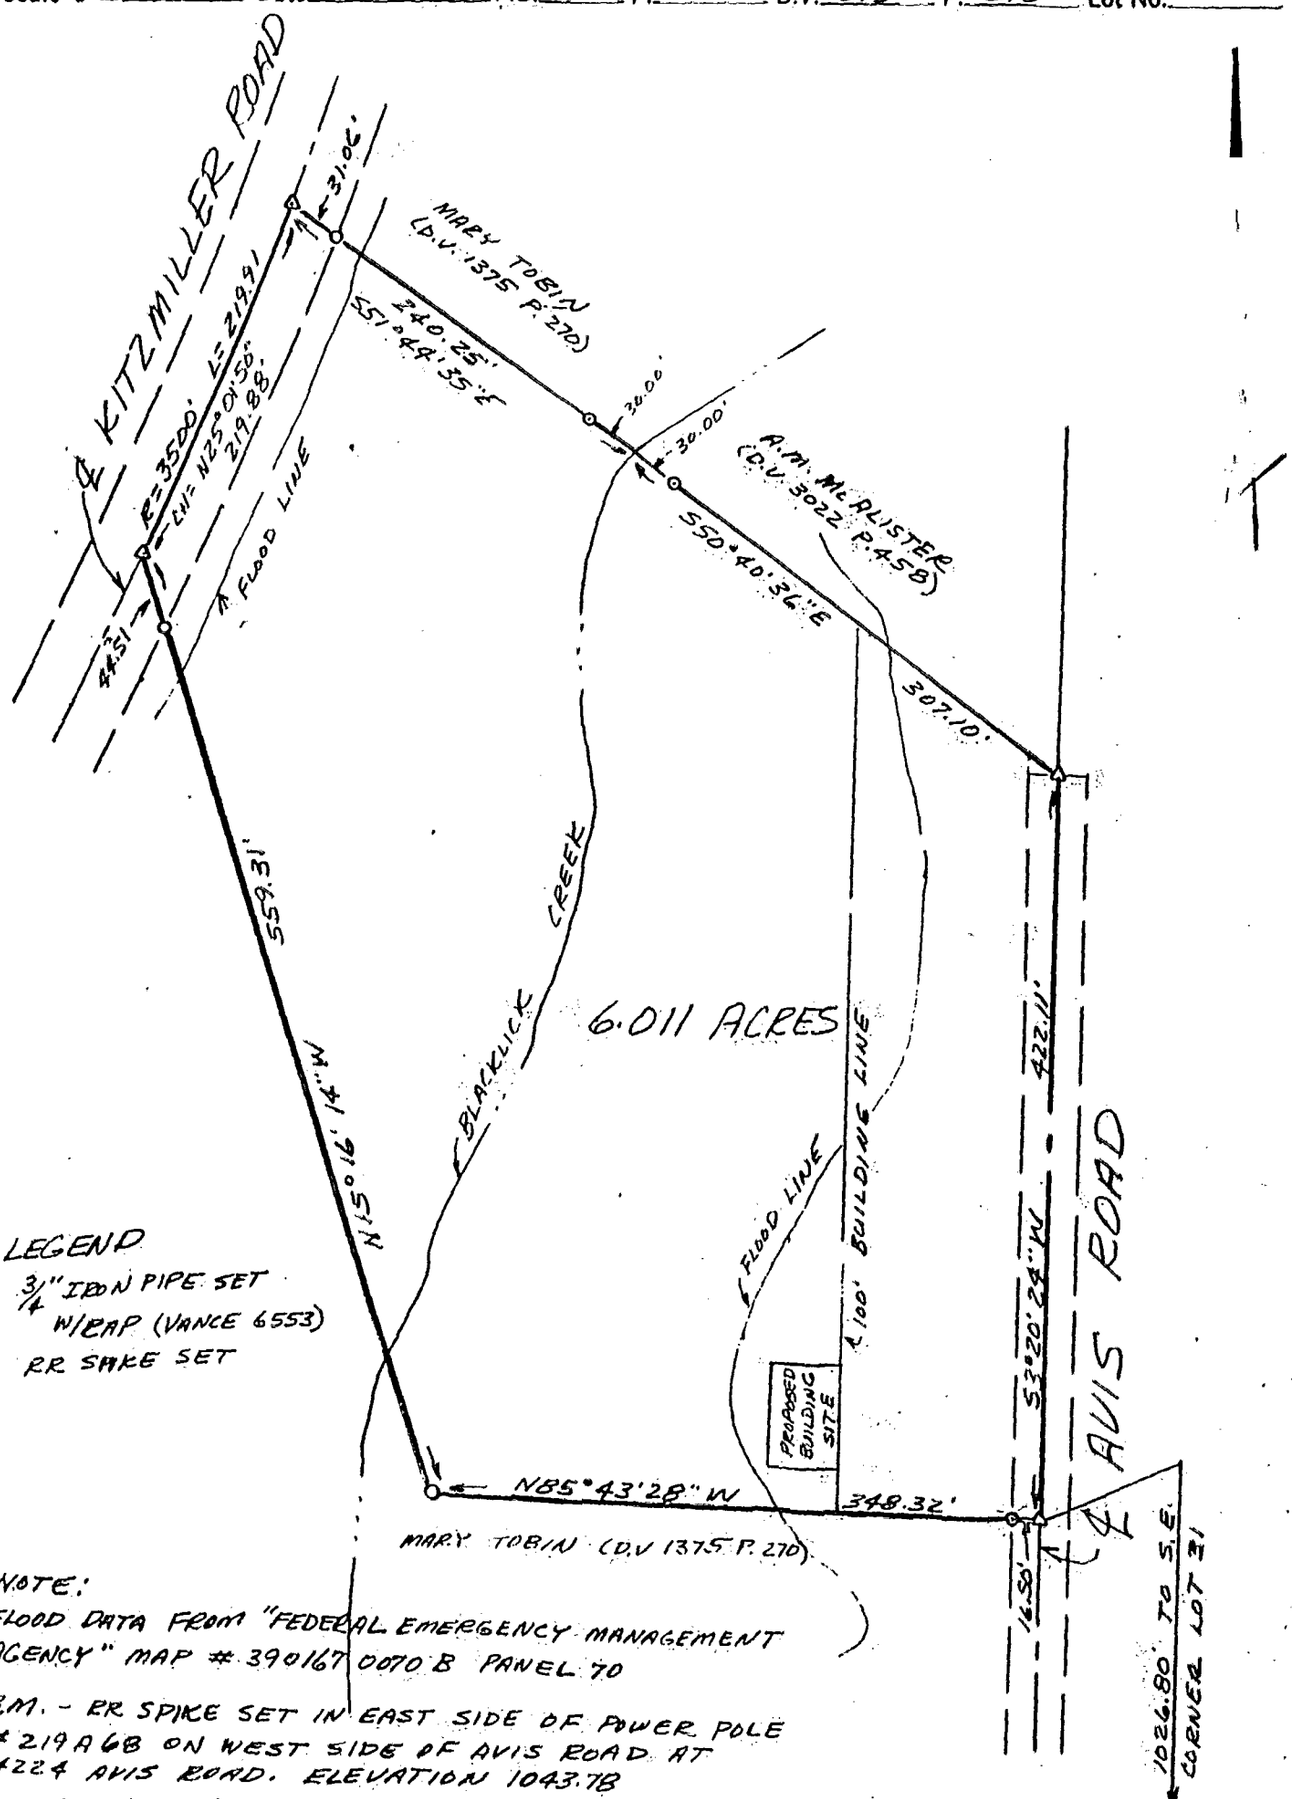

LEGEND
○ 3/4" IRON PIPE SET W/CAP (VANCE 6553)
△ RR SPIKE SET

NOTE:
FLOOD DATA FROM "FEDERAL EMERGENCY MANAGEMENT AGENCY" MAP # 390167 0070 B PANEL 70

B.M. - RR SPIKE SET IN EAST SIDE OF POWER POLE # 219A68 ON WEST SIDE OF AVIS ROAD AT #224 AVIS ROAD. ELEVATION 1043.78

I hereby certify that the foregoing drawing was prepared from an actual survey of the premises.

Drawn by S.W.V.

Samuel W. Vance
Registered Surveyor No. 6553

18635 1475

VANCE SURVEYING
LAND SURVEYOR