EVANS MECHWART HAMBLETON & TILTON

CIVIL ENGINEERS — SURVEYORS
GAHANNA, OHIO

0-3-

SURVEY OF 2 ACRE TRACT OUT OF THE SOUTHWEST CORNER OF THE JOHN L. & GLADYS R. HAMILTON 50 ACRE TRACT IN THE SOUTH PART OF LOT 3, FIRST QUARTER OF THE FIRST TWP., RANGE 16, U.S.M. LANDS, JEFFERSON TWP., FRANKLIN COUNTY, OHIO

0-38-C

SCALE 1" = 150'

. O = Iron Pin

May 18, 1961
Revised February 19, 1969

DEED BOOK _____, PAGE _____
PLAT BOOK 1587, PAGE 6

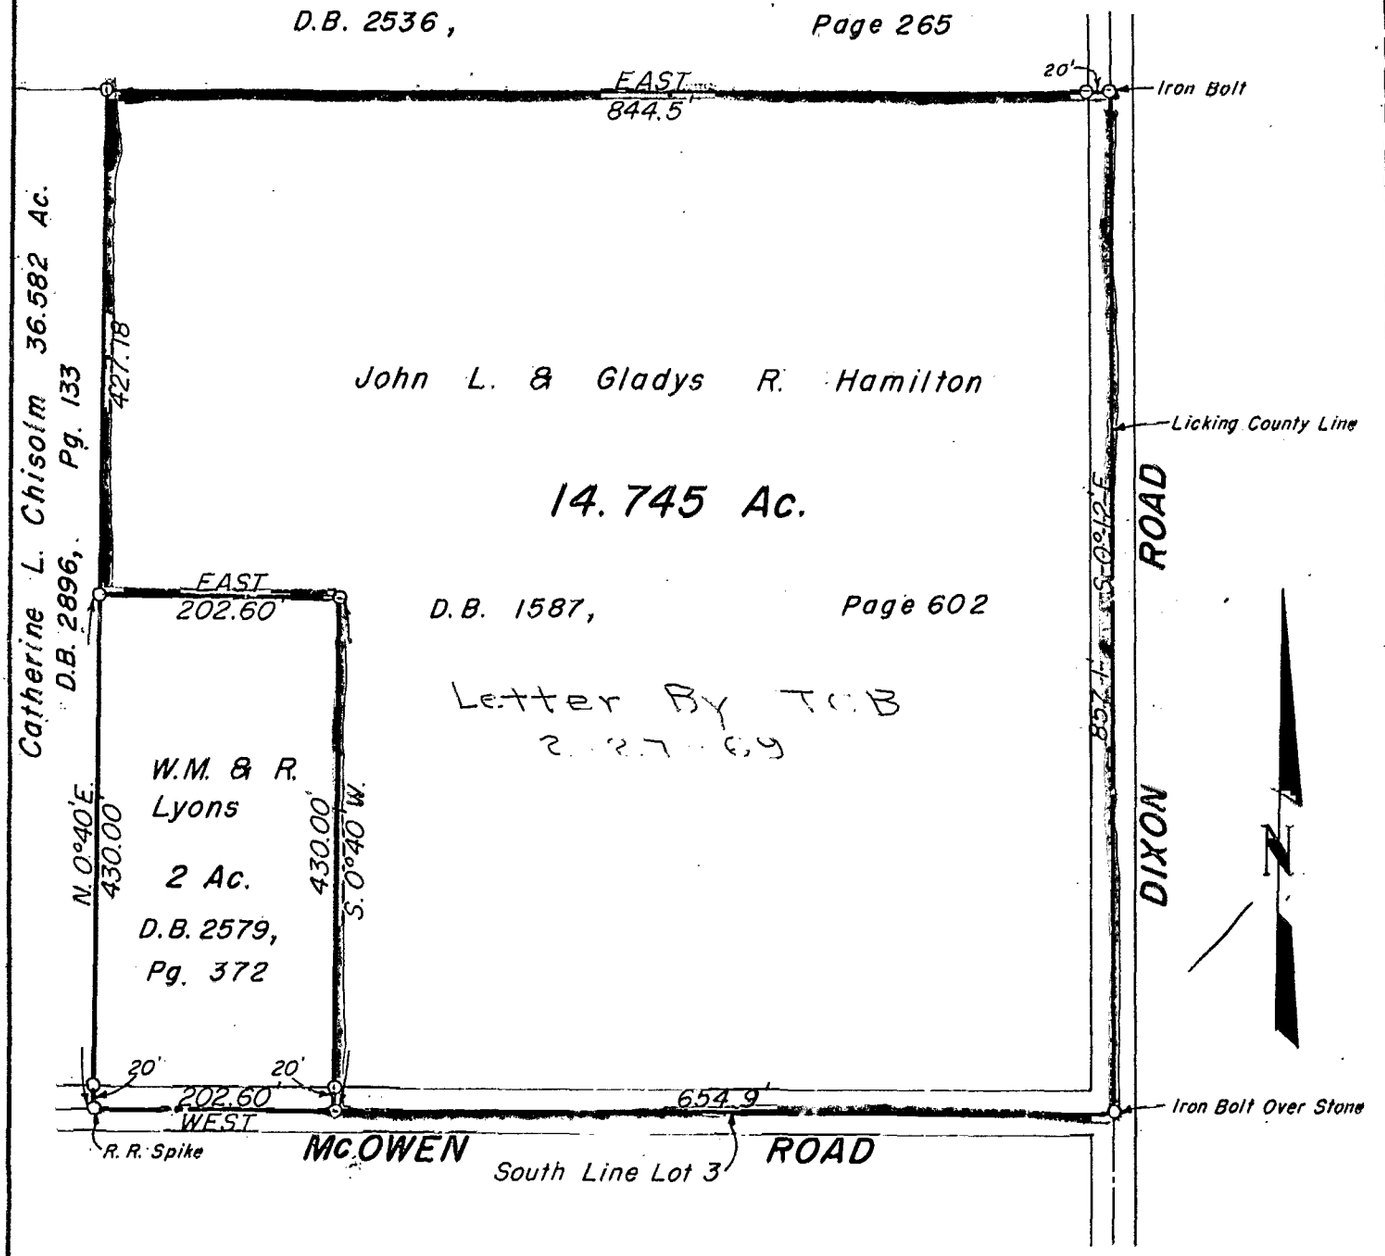

Letter By TCB
2-27-69

We hereby certify that the foregoing plat was prepared from an actual survey of the premises and shows the location of the boundaries

EVANS MECHWART HAMBLETON & TILTON

BY J. E. Evans

Registered Surveyor # 483

334-A