

88857425

O-38-C
JEFFERSON Twp.



SURVEY OF ACREAGE PARCEL

LOT 15, QUARTER TOWNSHIP 1, TOWNSHIP 1, RANGE 16, USML
JEFFERSON TOWNSHIP, FRANKLIN COUNTY, OHIO


SCALE 1" = 100'

No. 6784

STEWART TITLE

1:07PM

Sep. 1, 2000

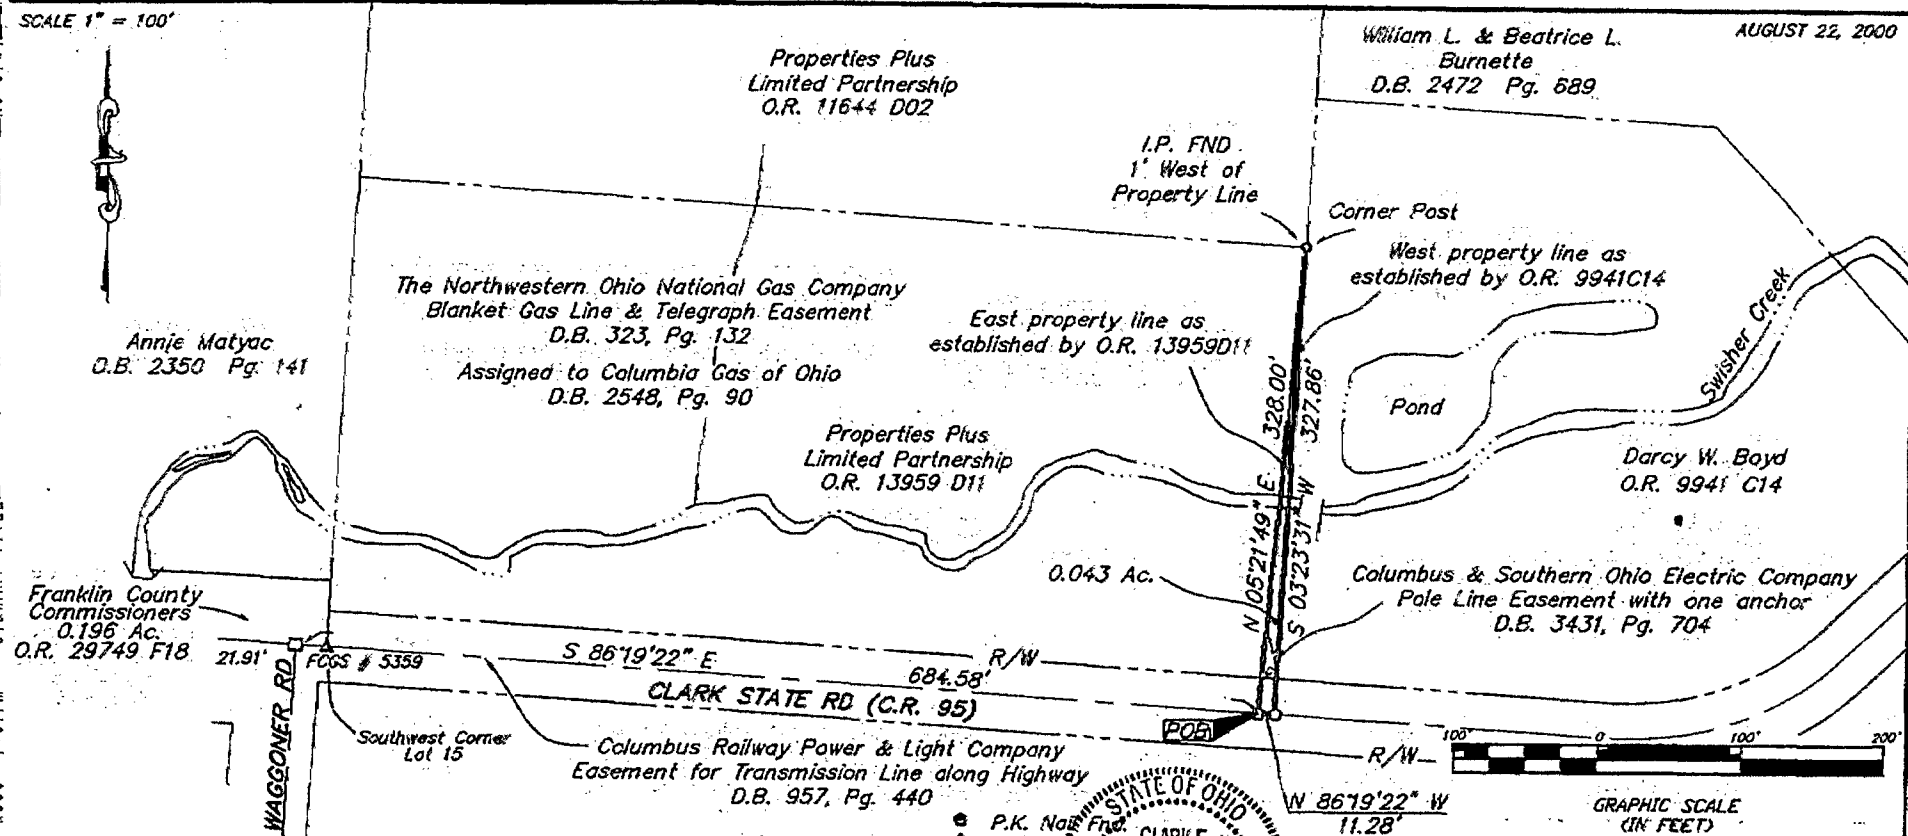

BASIS OF BEARINGS: Bearings are based on the Ohio State Plane Coordinate System as per NAD83. Control for bearings was from coordinates of monuments 6612 & 2208, having a bearing of South 86°23'15" East, established by the Franklin County Engineering Department, using Global Positioning System procedures and equipment.

STATE OF OHIO REGISTERED PROFESSIONAL SURVEYOR
CLARKE E. WHITE
7868
I.P. set are 3/4" O.D. x 30" long w/cap inscribed



EMH&T. INC.

By *Clarke E. White*
Professional Surveyor No. 7868