


BARBARA KIDD. N.

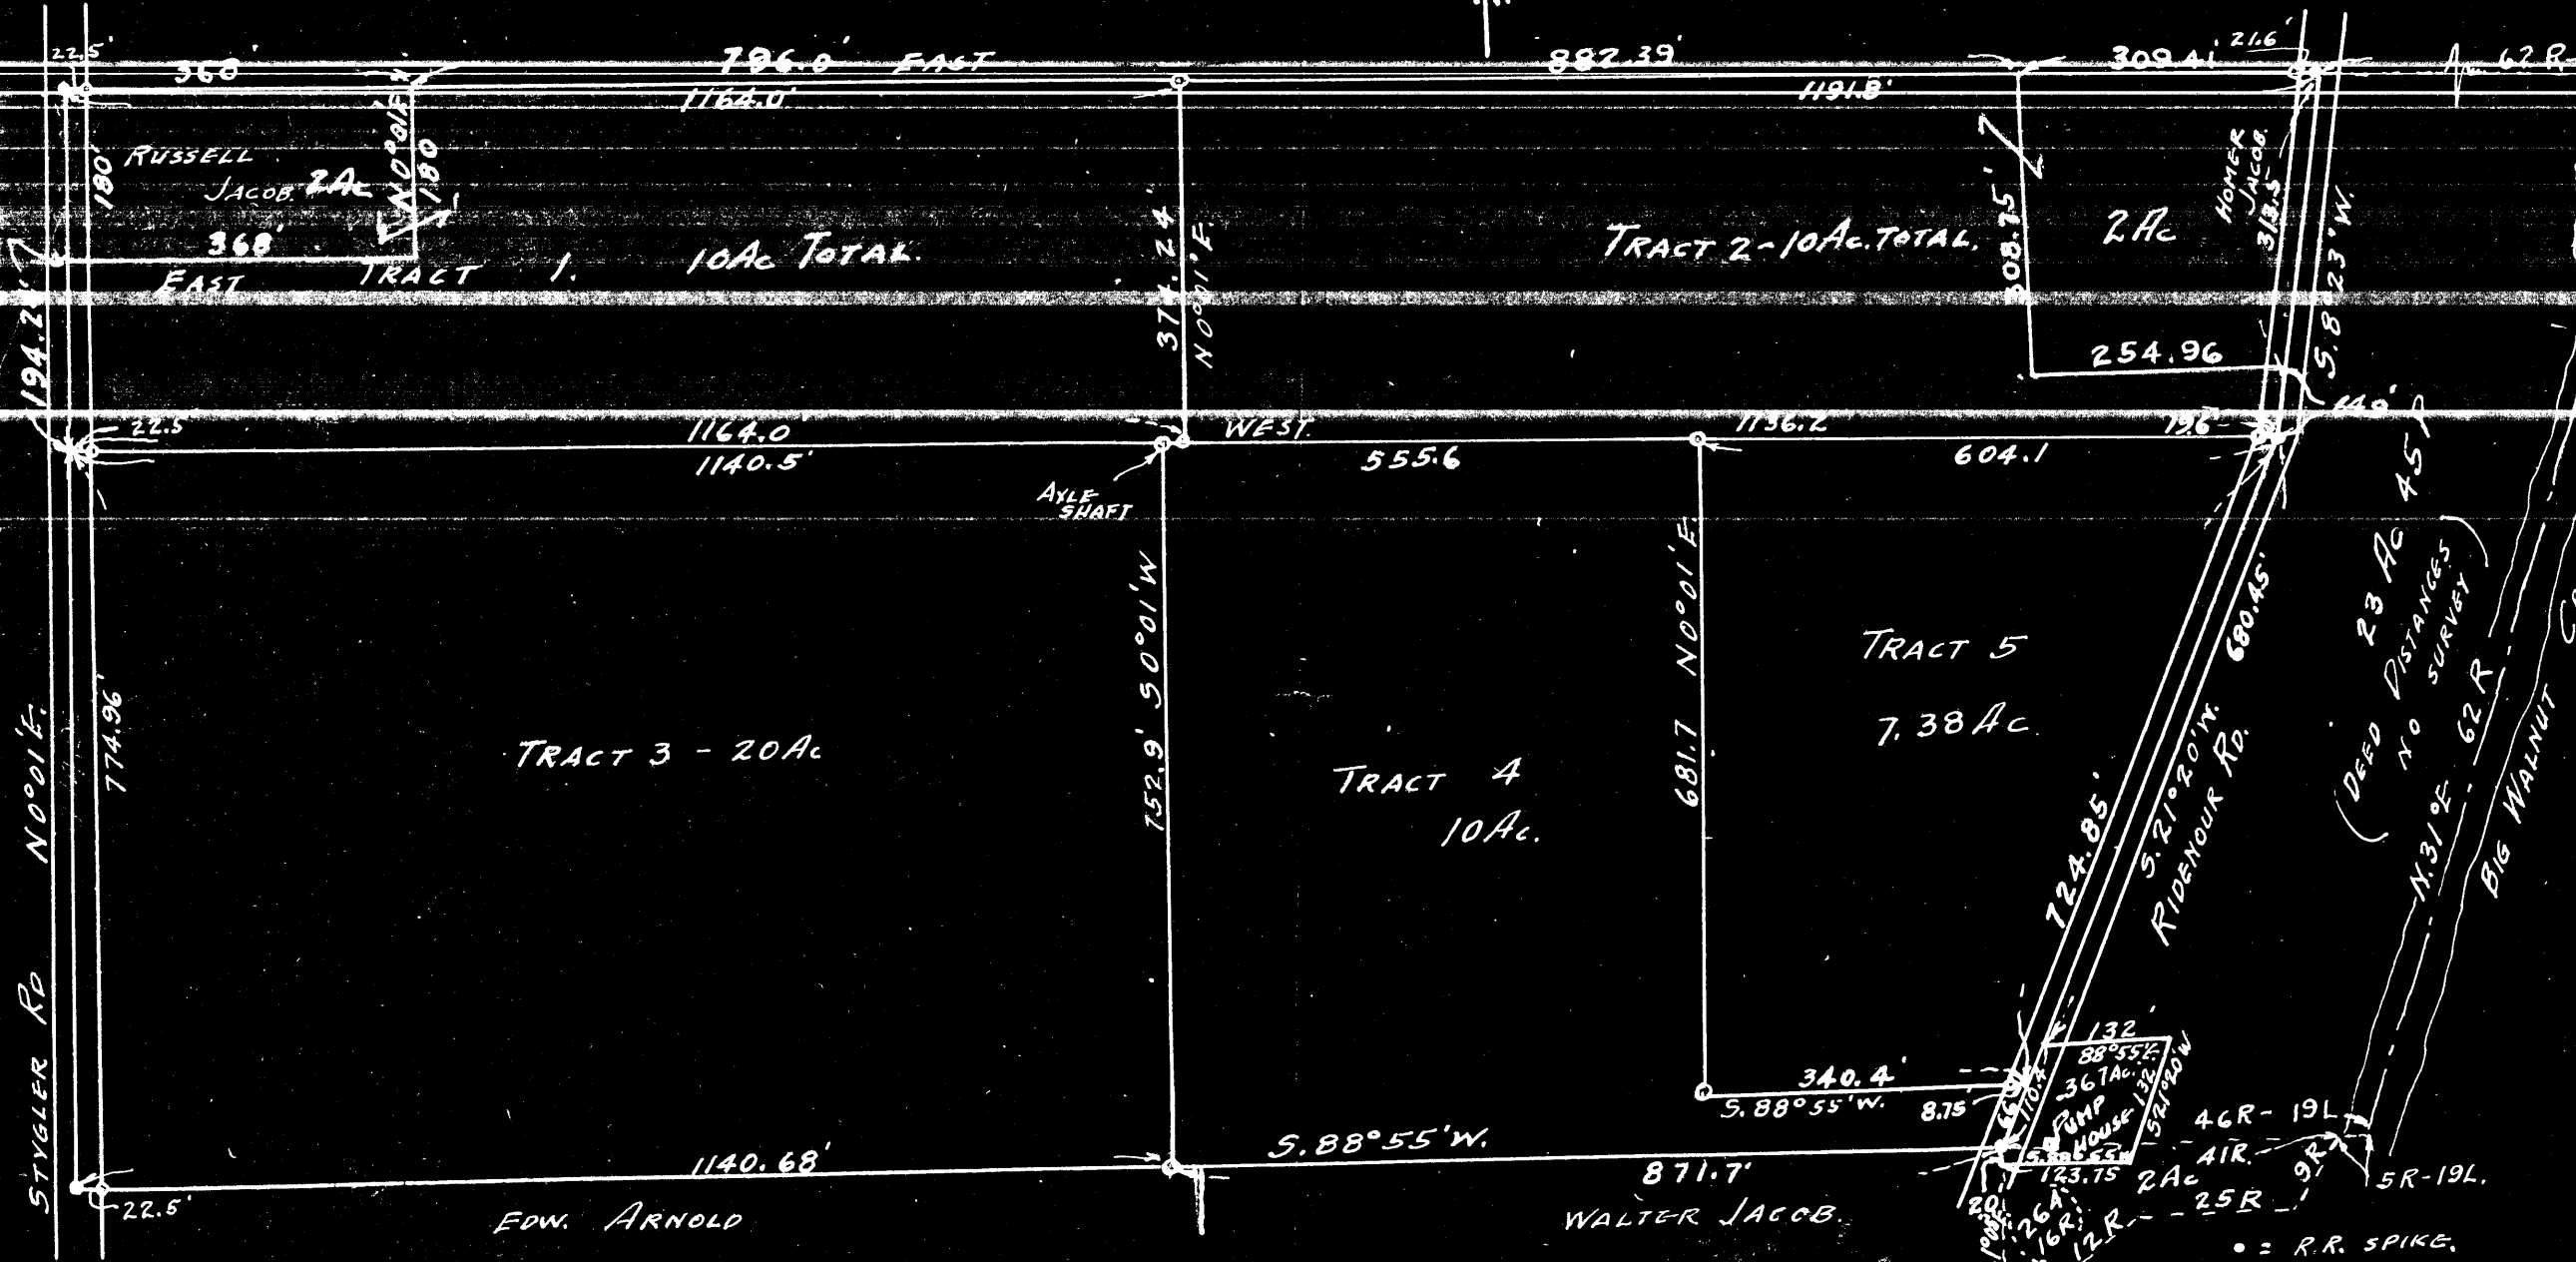

SURVEY OF WEST PART OF FRED JACOB FARM. DATE JUNE-JULY 1944.
 SCALE 1" = 200'. LOCATED IN R. 17, TP. 1, SEG. 1, MIFFLIN TWP.
 FRANKLIN CO. PA.

