

BAUER, BOROWITZ & MERCHANT, INC.

CONSULTING ENGINEERS

2607 1/2 NORTH HIGH STREET

0-59-C


COLUMBUS, OHIO 43202

BOUNDARY SURVEY MAP OF 0.606 ACRES OF LAND EAST OF JAMES ROAD AND SOUTH OF RIVER DRIVE IN THE CITY OF GAHANNA, COUNTY OF FRANKLIN, STATE OF OHIO

Graphic Scale
1" = 50'

March 15, 1983
Revised May 3, 1983

Order No. 397-83

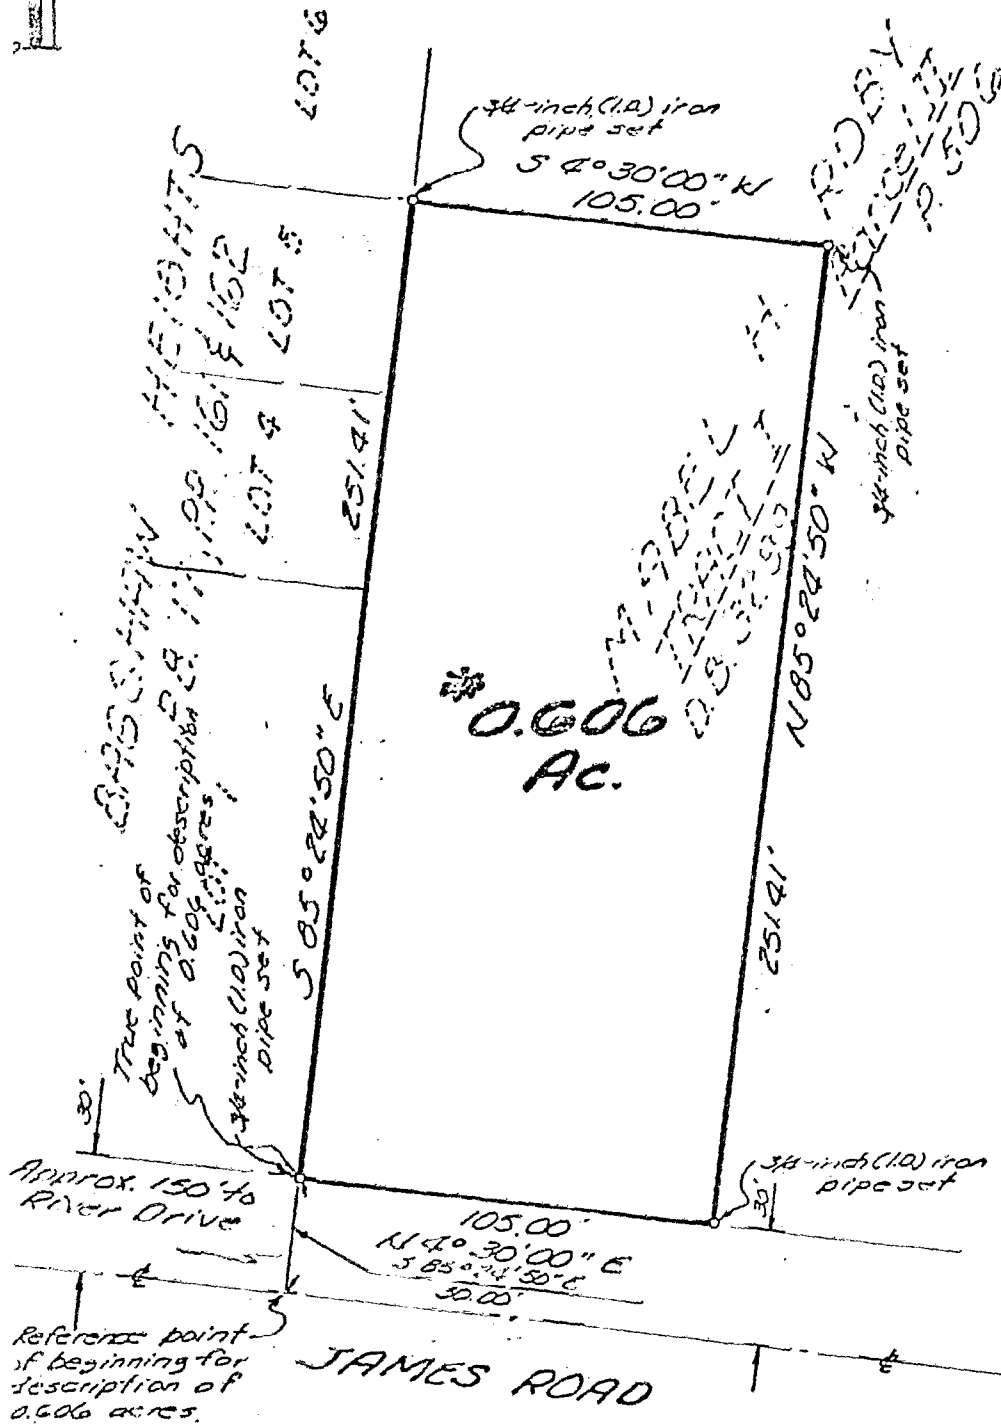

* Situated in the State of Ohio, County of Franklin, City of Gahanna, being in Quarter Township & Township 1, Range 17, United States Military Lands, containing 0.606 acres of land, more or less, said 0.606 acres being out of that 2 acre tract of land referred to as TRACT I, Parcel II and described in the deed to Mabel H. Roby of record in Deed Book 3299, Page 506, Recorder's Office, Franklin County, Ohio.

We hereby certify that the above map was prepared from information obtained from an actual field survey conducted by Bauer, Borowitz & Merchant, Inc. in March of 1983, and that, to the best of our knowledge and belief said map is correct.

The survey markers noted on the above map as "set" were set by Bauer, Borowitz & Merchant, Inc. and were in place on April 6, 1983

The bearings shown on the above map are based on an assumed meridian.

Bauer, Borowitz & Merchant, Inc.
Consulting Engineers

By Robert W. Davidson
Registered Surveyor No. 5722

86107325