

SURVEY OF 0.0023 ACRE TRACT

LOT 57

VILLAGE OF GAHANNA


CITY OF GAHANNA, FRANKLIN COUNTY, OHIO

JRS

FEBRUARY 15, 1995

RECORD REFERENCES P.B. 3, Pg. 213

SHORT ST. 59'

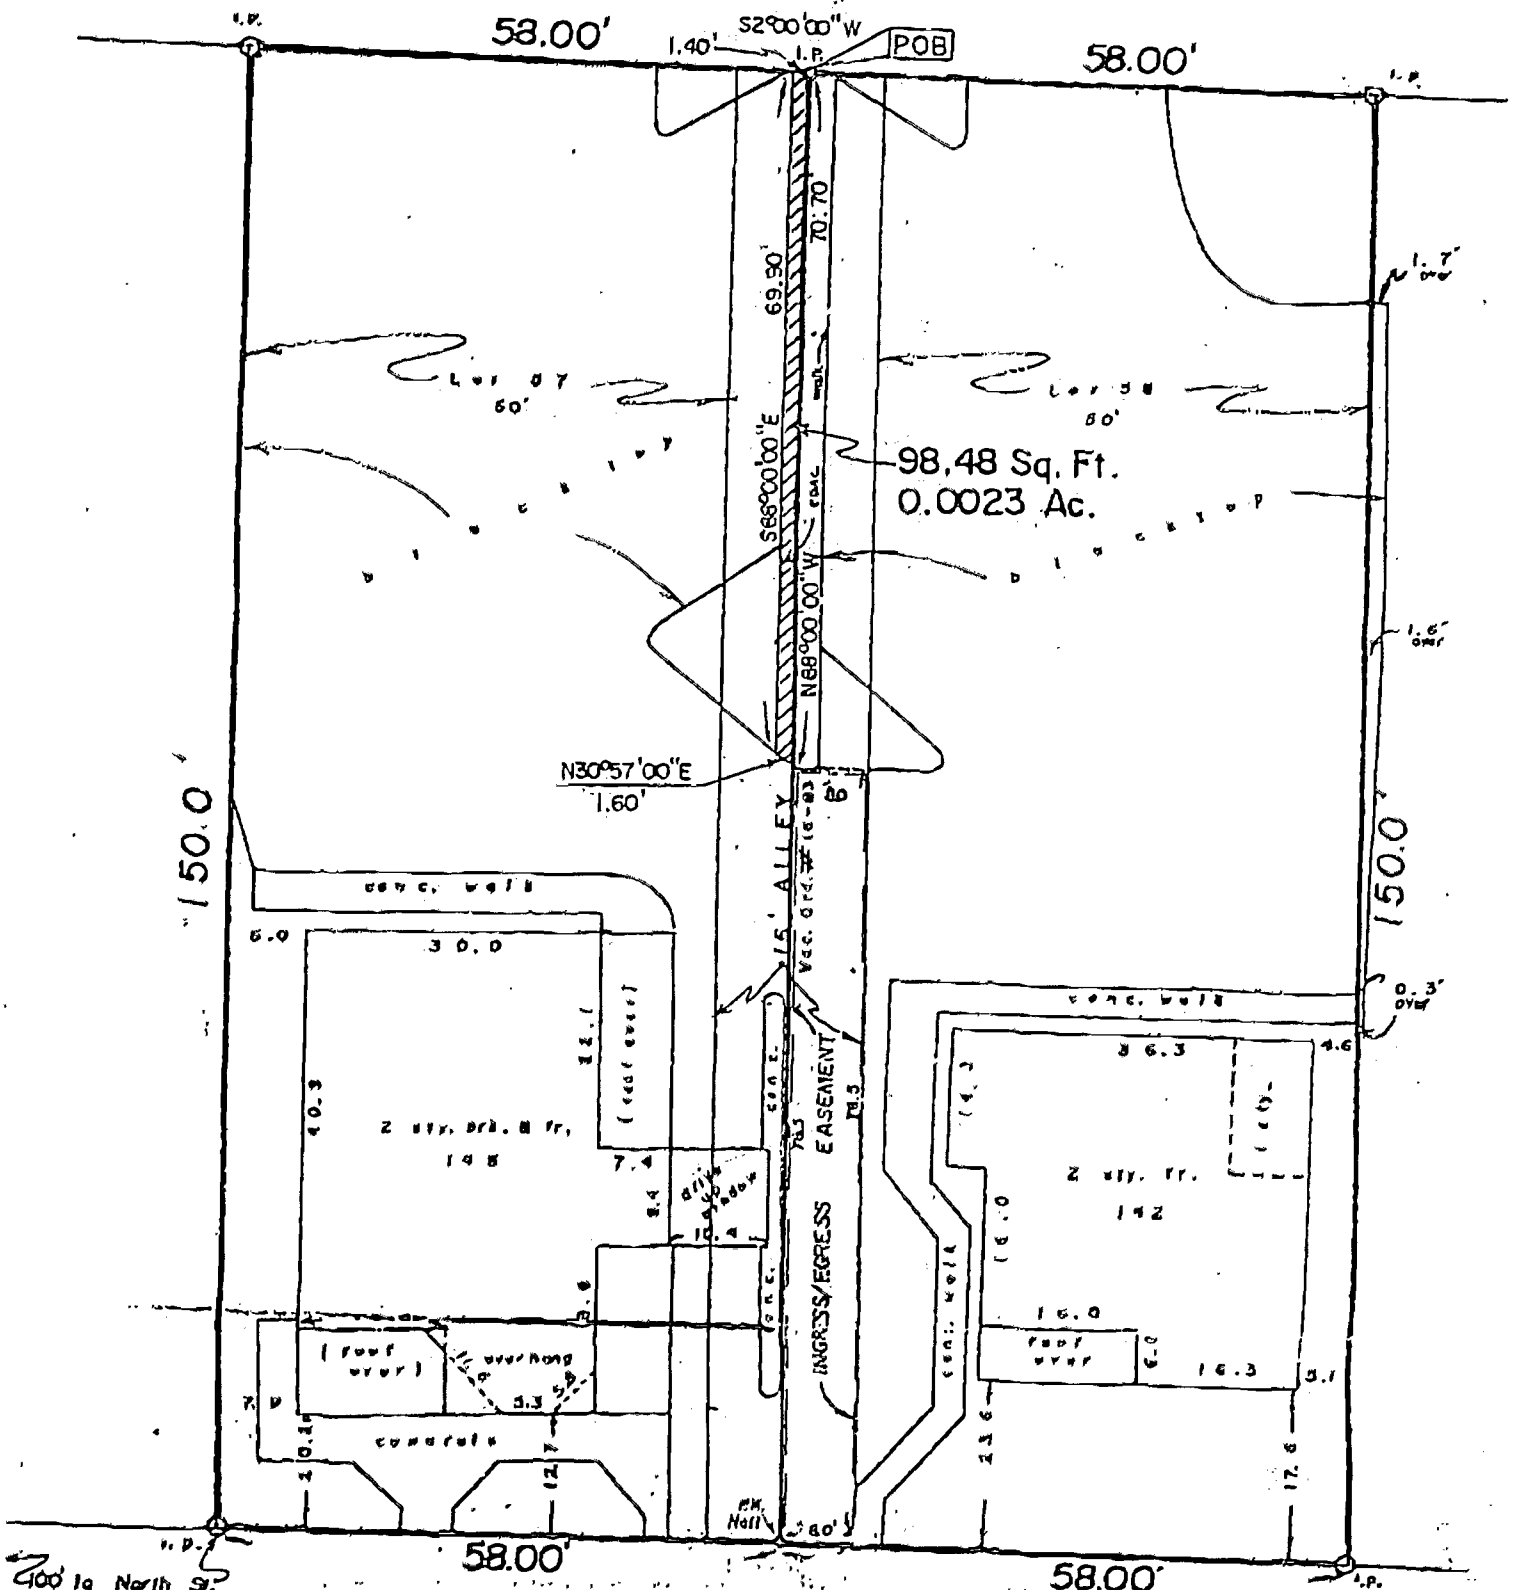

N. HIGH ST. 60'

Basis of Bearing is North 89° 00' 00" West for the centerline of said vacated 16.00 feet wide alley and all other bearings calculated from this meridian.



E.M.H. & SONS

By *Jeffrey A. Miller* 2-15-95
 Professional Surveyor No. 7211

MILLER 186 107 850 N-39