

86607275

0-39-D




SURVEY OF ACREAGE PARCEL  
LOCATED IN  
LOT 5, QUARTER TOWNSHIP 3, TOWNSHIP 1, RANGE 16  
UNITED STATES MILITARY LANDS  
CITY OF GAHANNA, FRANKLIN COUNTY, OHIO

JEFFERSON TWP

SCALE 1" = 100'

MARCH 2, 2001

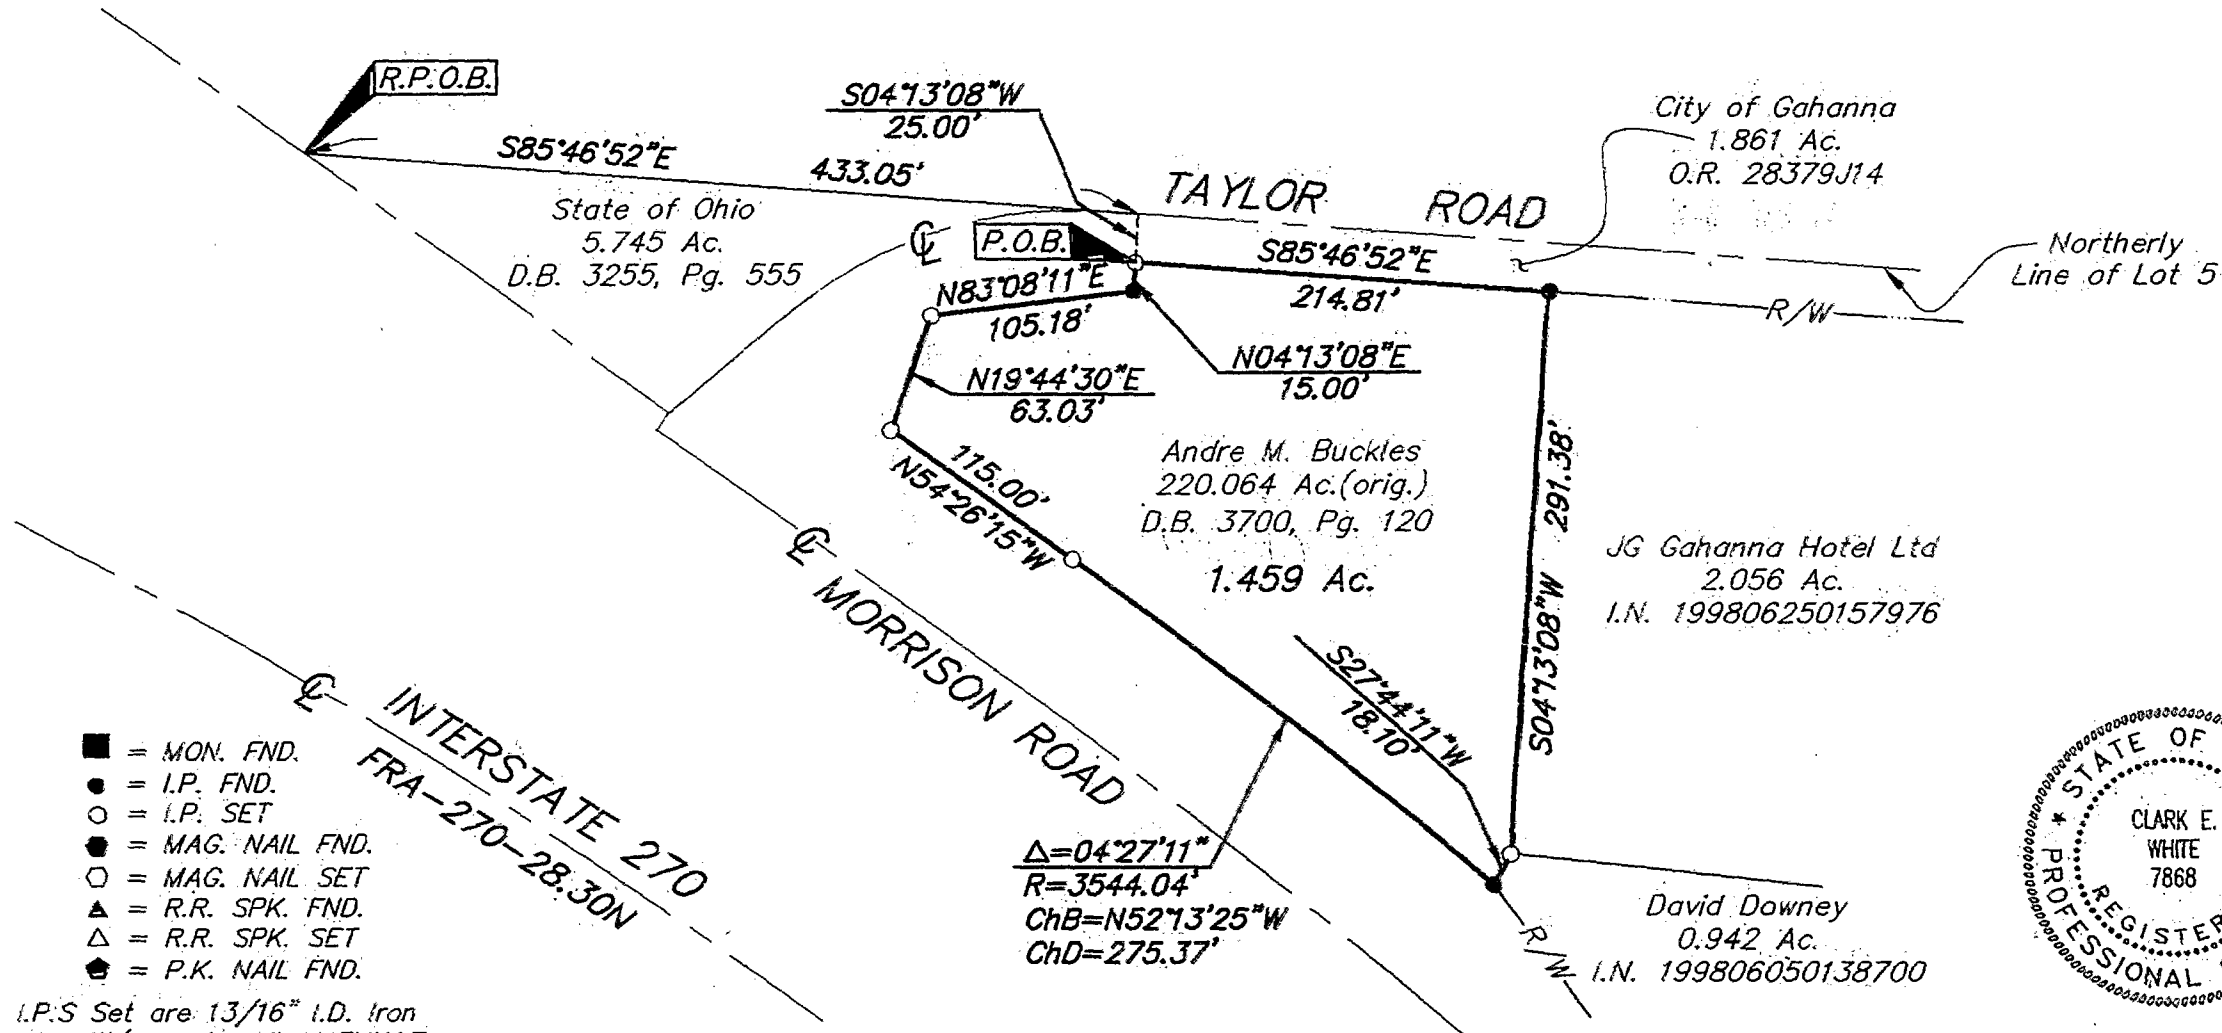


- = MON. FND.
- = I.P. FND.
- = I.P. SET
- = MAG. NAIL FND.
- = MAG. NAIL SET
- ▲ = R.R. SPK. FND.
- △ = R.R. SPK. SET
- ⊕ = P.K. NAIL FND.

I.P.S Set are 13/16" I.D. Iron pipe W/ cap inscribed EMH&T.



GRAPHIC SCALE (IN FEET)

BASIS OF BEARINGS: Bearings are based on the Ohio State Plane Coordinate System as per NAD83, established by the Franklin County Engineering Department, using Global Positioning System procedures and equipment.

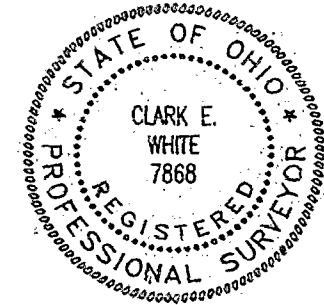

E.M.H.&T. INC.

By *Clark E. White*  
Professional Surveyor No. 7868

C:\PROJECT\20010189.01\DWG\10189BY.DWG - O XREFS - PLOTTED BY JBUSHBY - March 02, 2001 - 12:35 PM