HOCKADEN AND ASSOCIATES, INC.

187607225
187857225

CONSULTING ENGINEERS
883 N. CASSADY AVENUE
COLUMBUS, OHIO

M-96 HHH

Plat Showing A 6.370 Acre Tract North Of Broad Street, East Of McCormick Boulevard Columbus, Ohio.

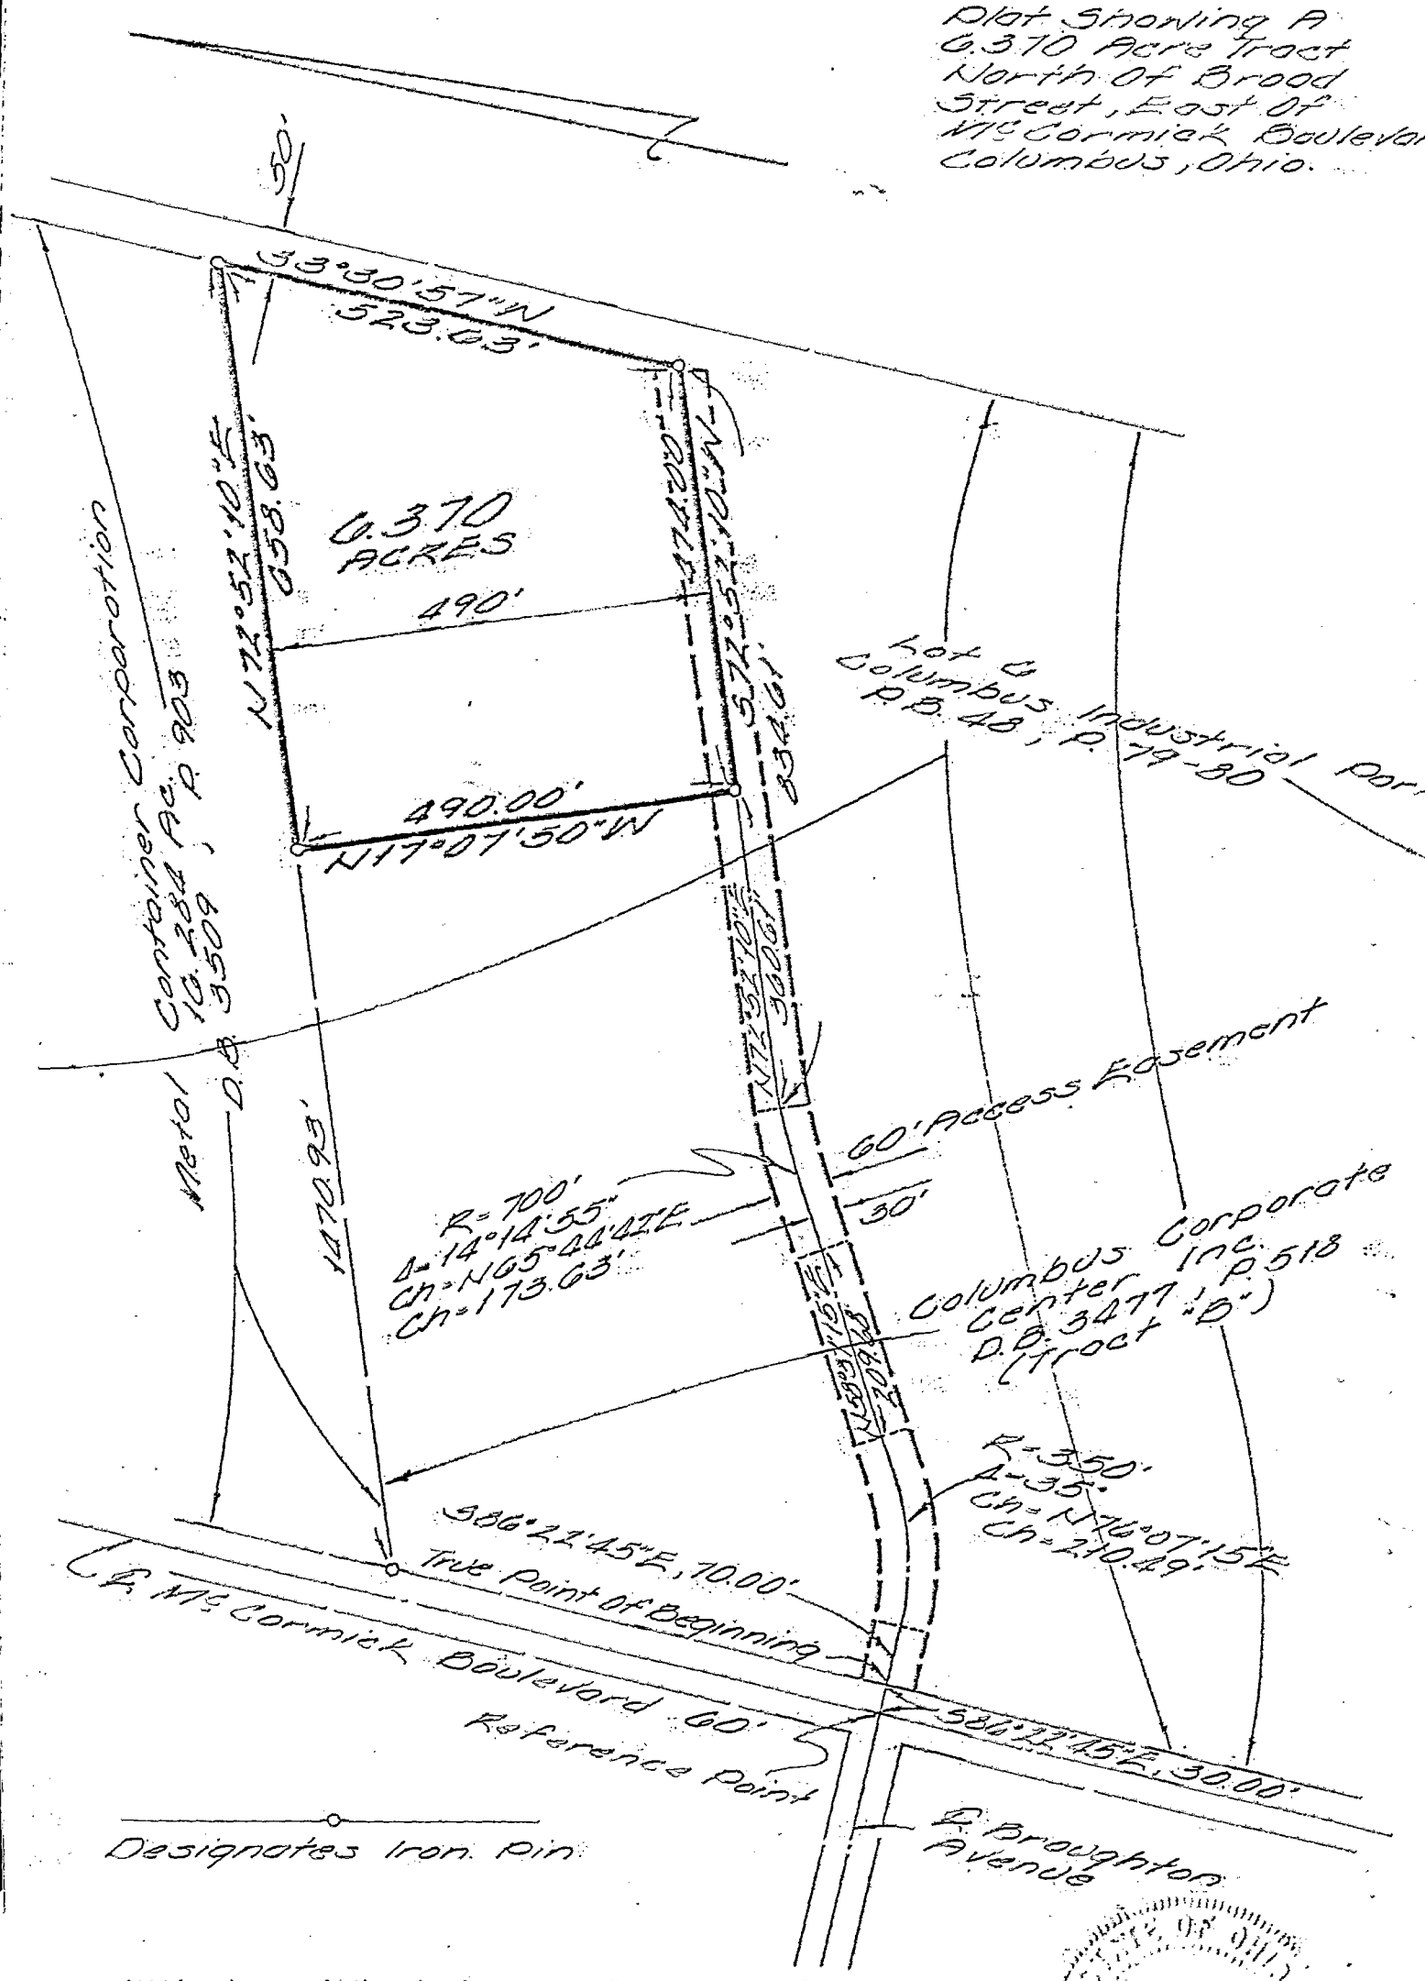

We hereby certify that the foregoing plat was prepared from an actual survey of the premises.

SCALE 1" = 200'

DATE: 14 July 77 P-490

SURVEYED DATES | CREW NUMBERS

SURVEYED | DRAWN | CHECKED

HOCKADEN AND ASSOCIATES, INC.