


**SURVEY OF ACREAGE PARCEL**  
 LOCATED IN  
 FARM LOT 1, QUARTER TOWNSHIP 4, TOWNSHIP 1, RANGE 16  
 UNITED STATES MILITARY LANDS  
 TOWNSHIP OF JEFFERSON, FRANKLIN COUNTY, OHIO

SCALE: 1" = 100'

FEBRUARY 12, 2001

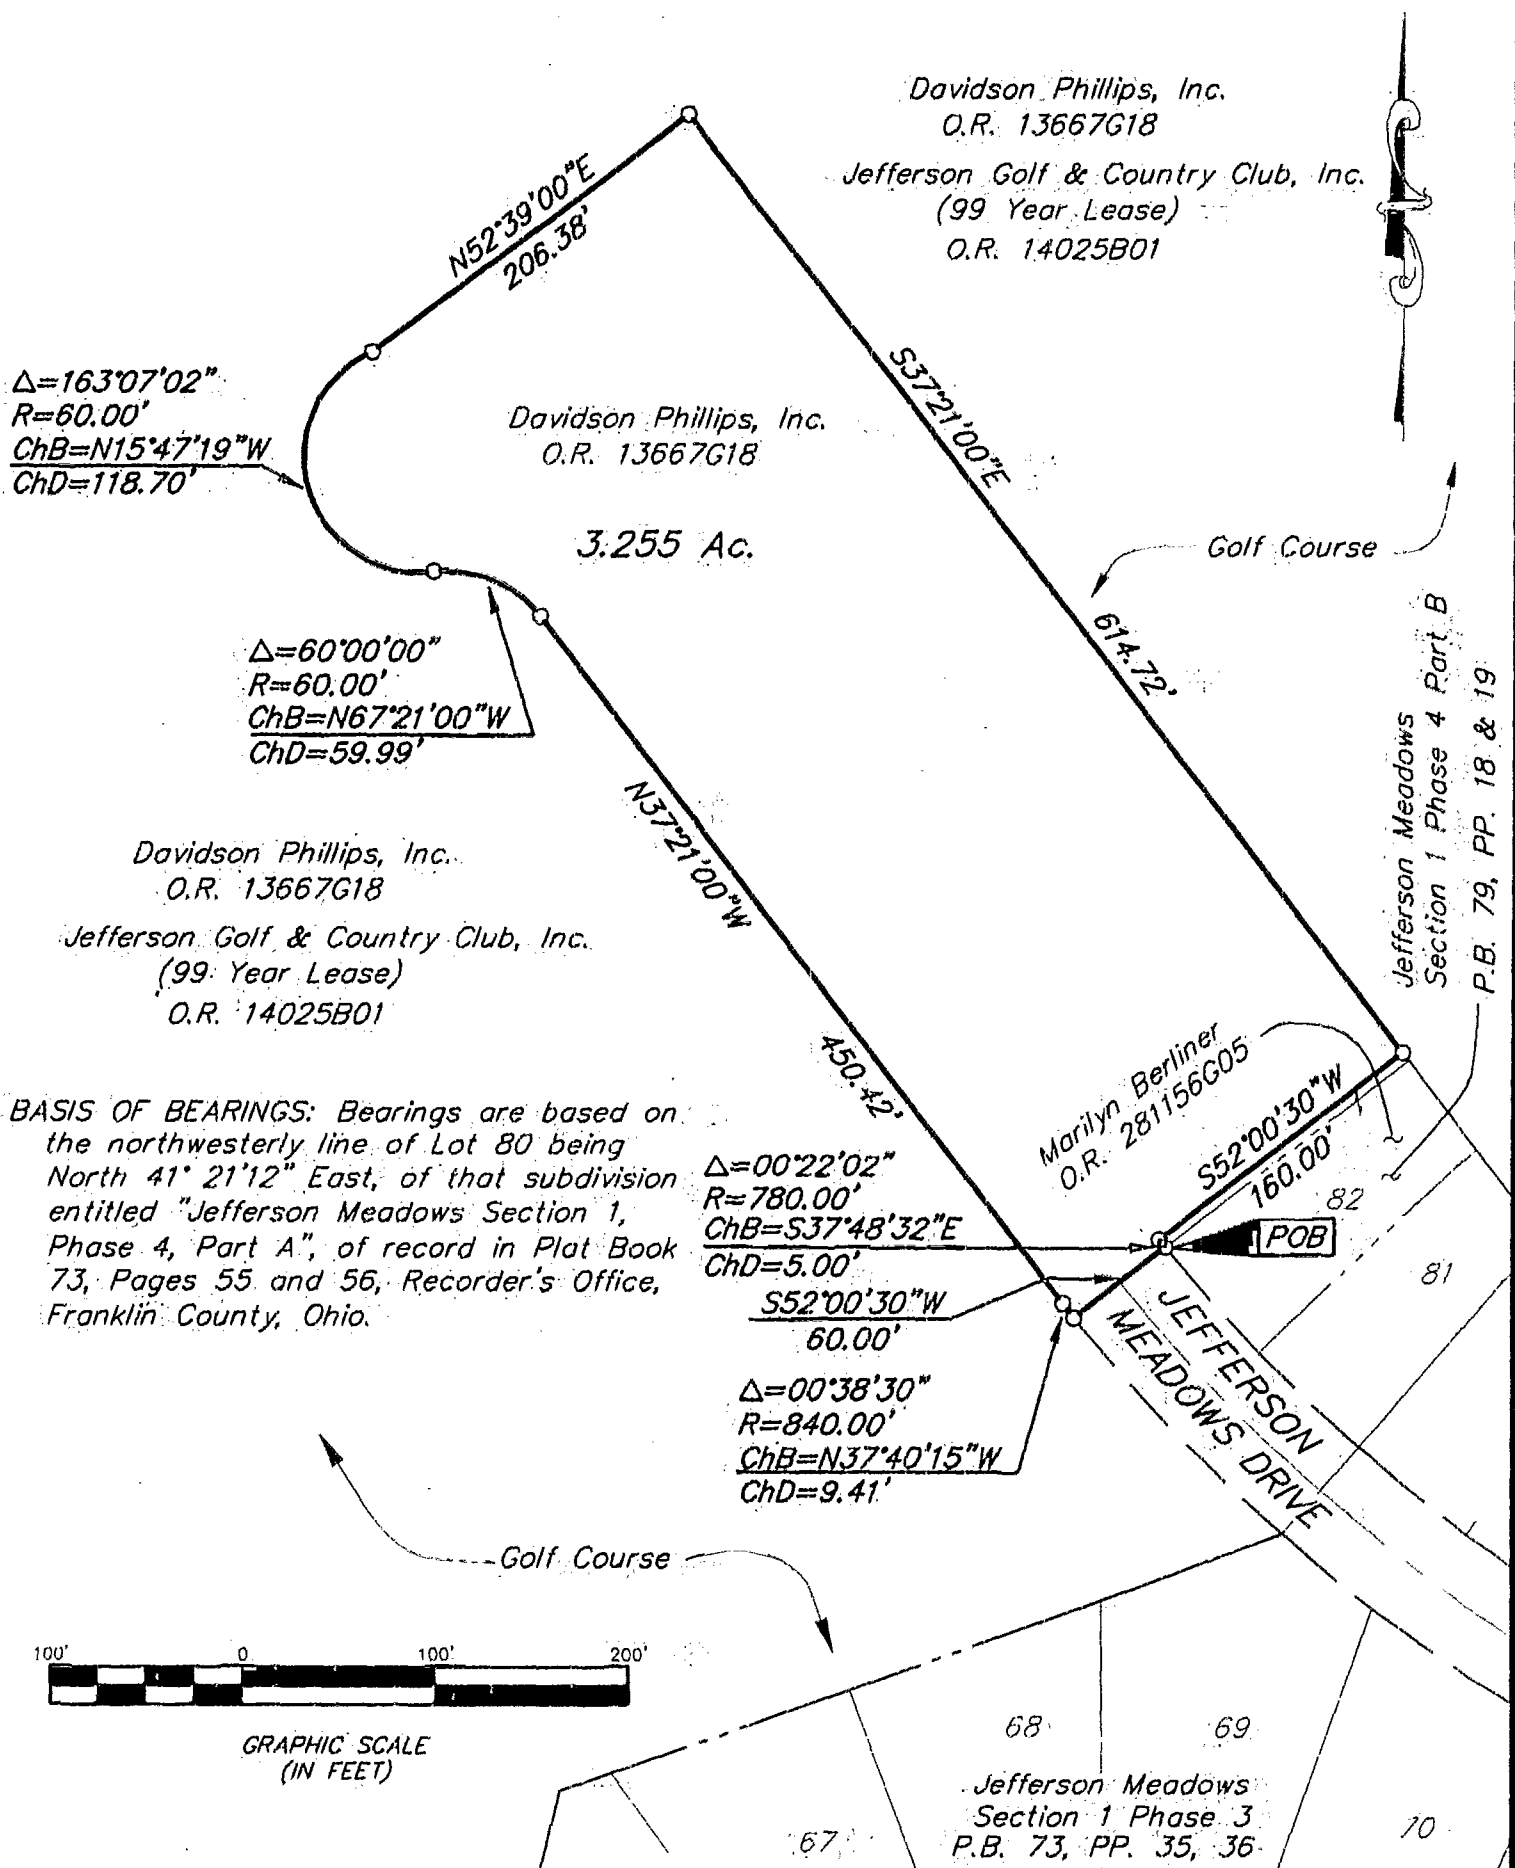

**BASIS OF BEARINGS:** Bearings are based on the northwesterly line of Lot 80 being North  $41^{\circ}21'12''$  East, of that subdivision entitled "Jefferson Meadows Section 1, Phase 4, Part A", of record in Plat Book 73, Pages 55 and 56, Recorder's Office, Franklin County, Ohio.



GRAPHIC SCALE (IN FEET)

- = MON. FND.
- = I.P. FND.
- = I.P. SET
- ⊙ = MAG. NAIL FND.
- ⊕ = MAG. NAIL SET
- ▲ = R.R. SPK. FND.
- △ = R.R. SPK. SET
- ◆ = P.K. NAIL FND.



**E.M.H.&T. INC.**

By Matthew A. Kirk  
 Professional Surveyor No. 7865

I.P.S. Set are 13/16" I.D. Iron pipe W/ cap inscribed EMH&T.

87857325

JEFFERSON TWP

0-39-C