


JEFFERSON TWP

C-38-D

039-7

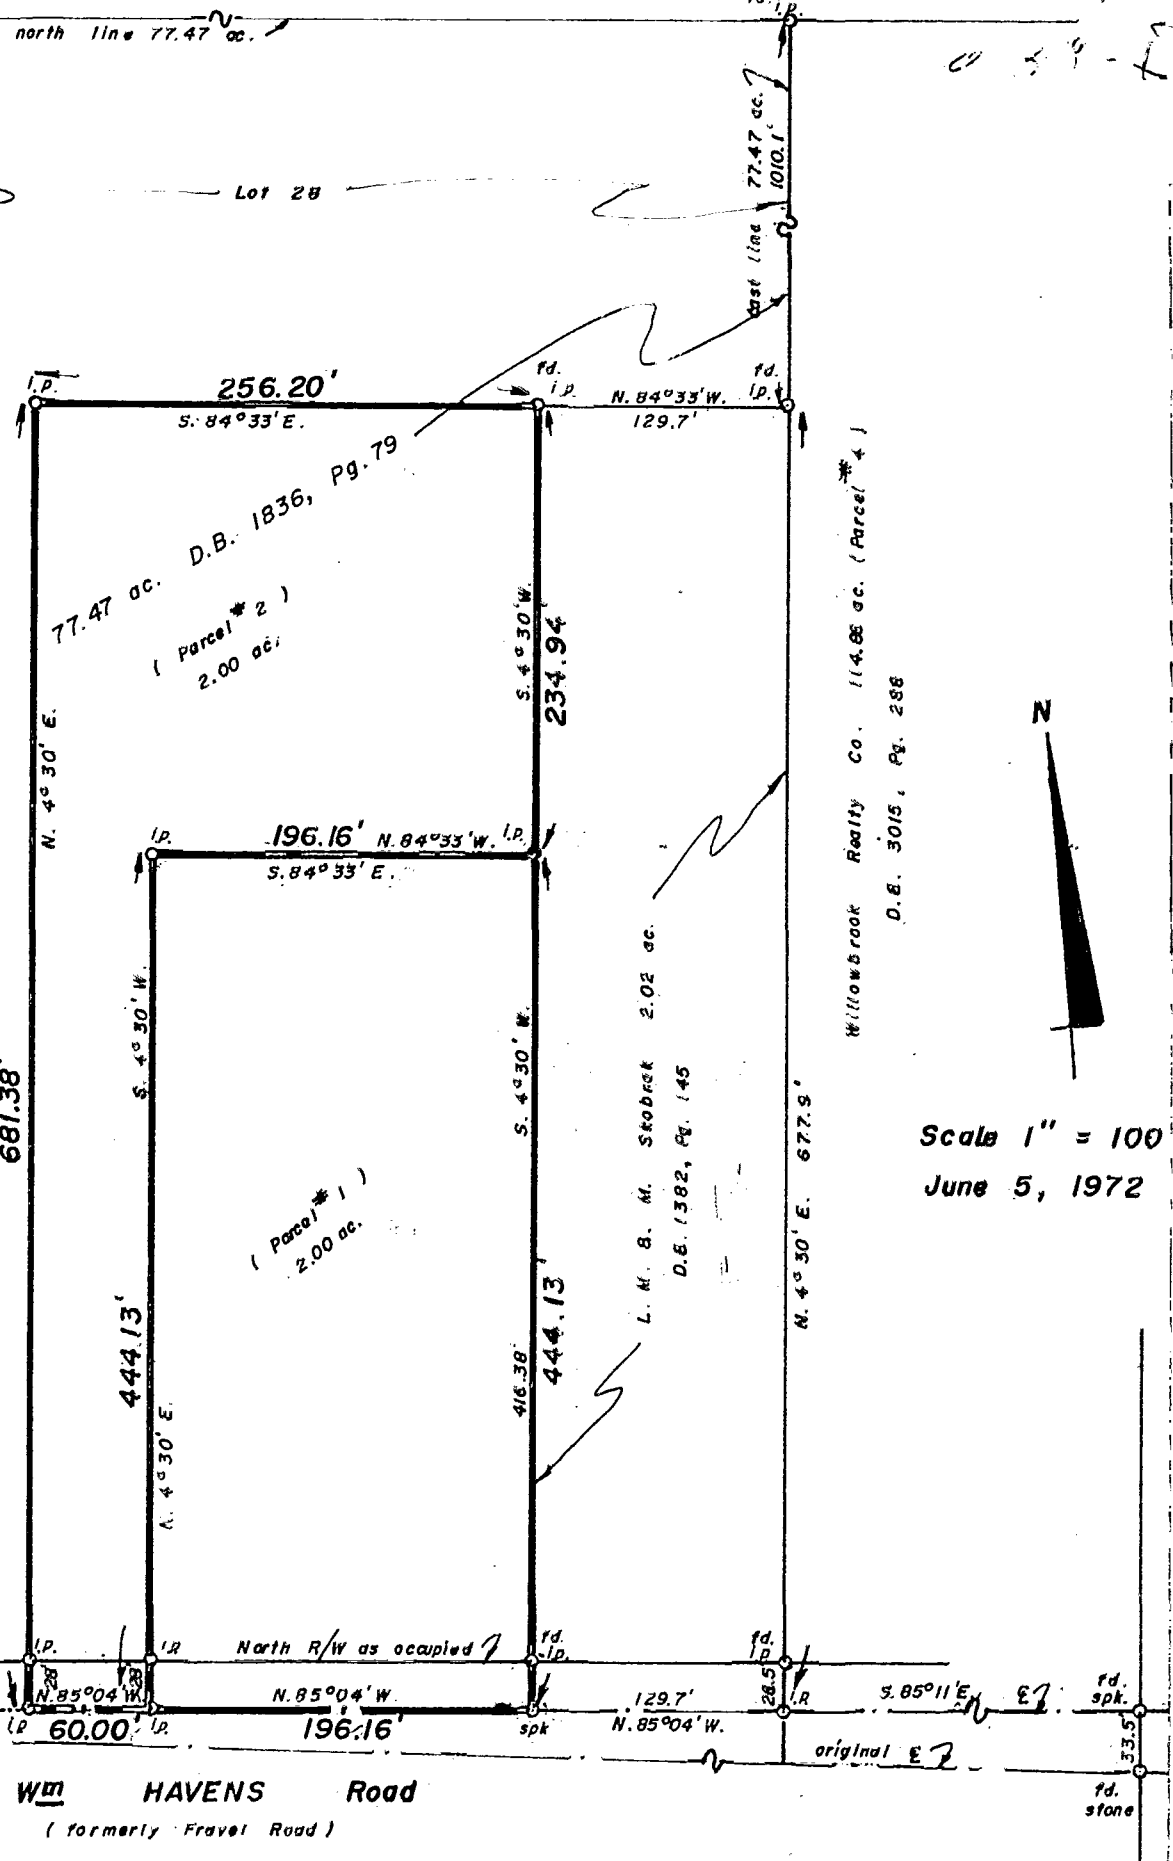

Scale 1" = 100  
June 5, 1972

**WM HAVENS Road**  
(formerly Fravel Road)

Being a part of Lot 28 of the Subdivision of Quarter Township 1, Range 16, United States Military Lands, and being a part of Lot 4 in the case of J. Farber vs. L. Sager shown in Complete Record 235, Page 508, Court of Common Pleas, Franklin County, Ohio, and being a part of a 77.47 acre tract conveyed to L. E. Heidorn shown of record in Deed Book 1836, Page 79, Recorder's Office, Franklin County, Ohio, and being situated in Jefferson Township, Franklin County, Ohio.

for  
**MR. L. E. HEIDORN**

88/67375

I hereby certify that the foregoing plat represents a true return of survey made by me in June 1972. Iron pins are indicated as thus —o—

*Albert H. Andrews*  
Albert H. Andrews Registered Surveyor #5699

ALBERT H. ANDREWS  
180 S. Warren Ave.  
Columbus, Ohio 43204

This survey is subject to all highways and easements of record, and of records, easements, and restrictions in the respective utility offices.

005  
0330  
1772  
106013  
120  
8473