70-118

MYERS SURVEYING CO.

2740 East Main Street, Columbus 9 (Bexley), Ohio

0-38

BEING A DIVISION OF A 4.344 ACRE TRACT (DEEDED TO ANITA M. McCLARY FROM R.E. AND L.F. SHAFFER AND D.M. AND M.S. BYERLY DB 1831, PG. 329) IN JEFFERSON TWP., FRANKLIN CO., OHIO.

FOR

MARVIN C. YERKE AND/OR

LAWYERS TITLE INS. CORP.

P.B. Page

Scale 1" = 100'

Franklin Co. Rec. Offic

NOV. 17, 1969

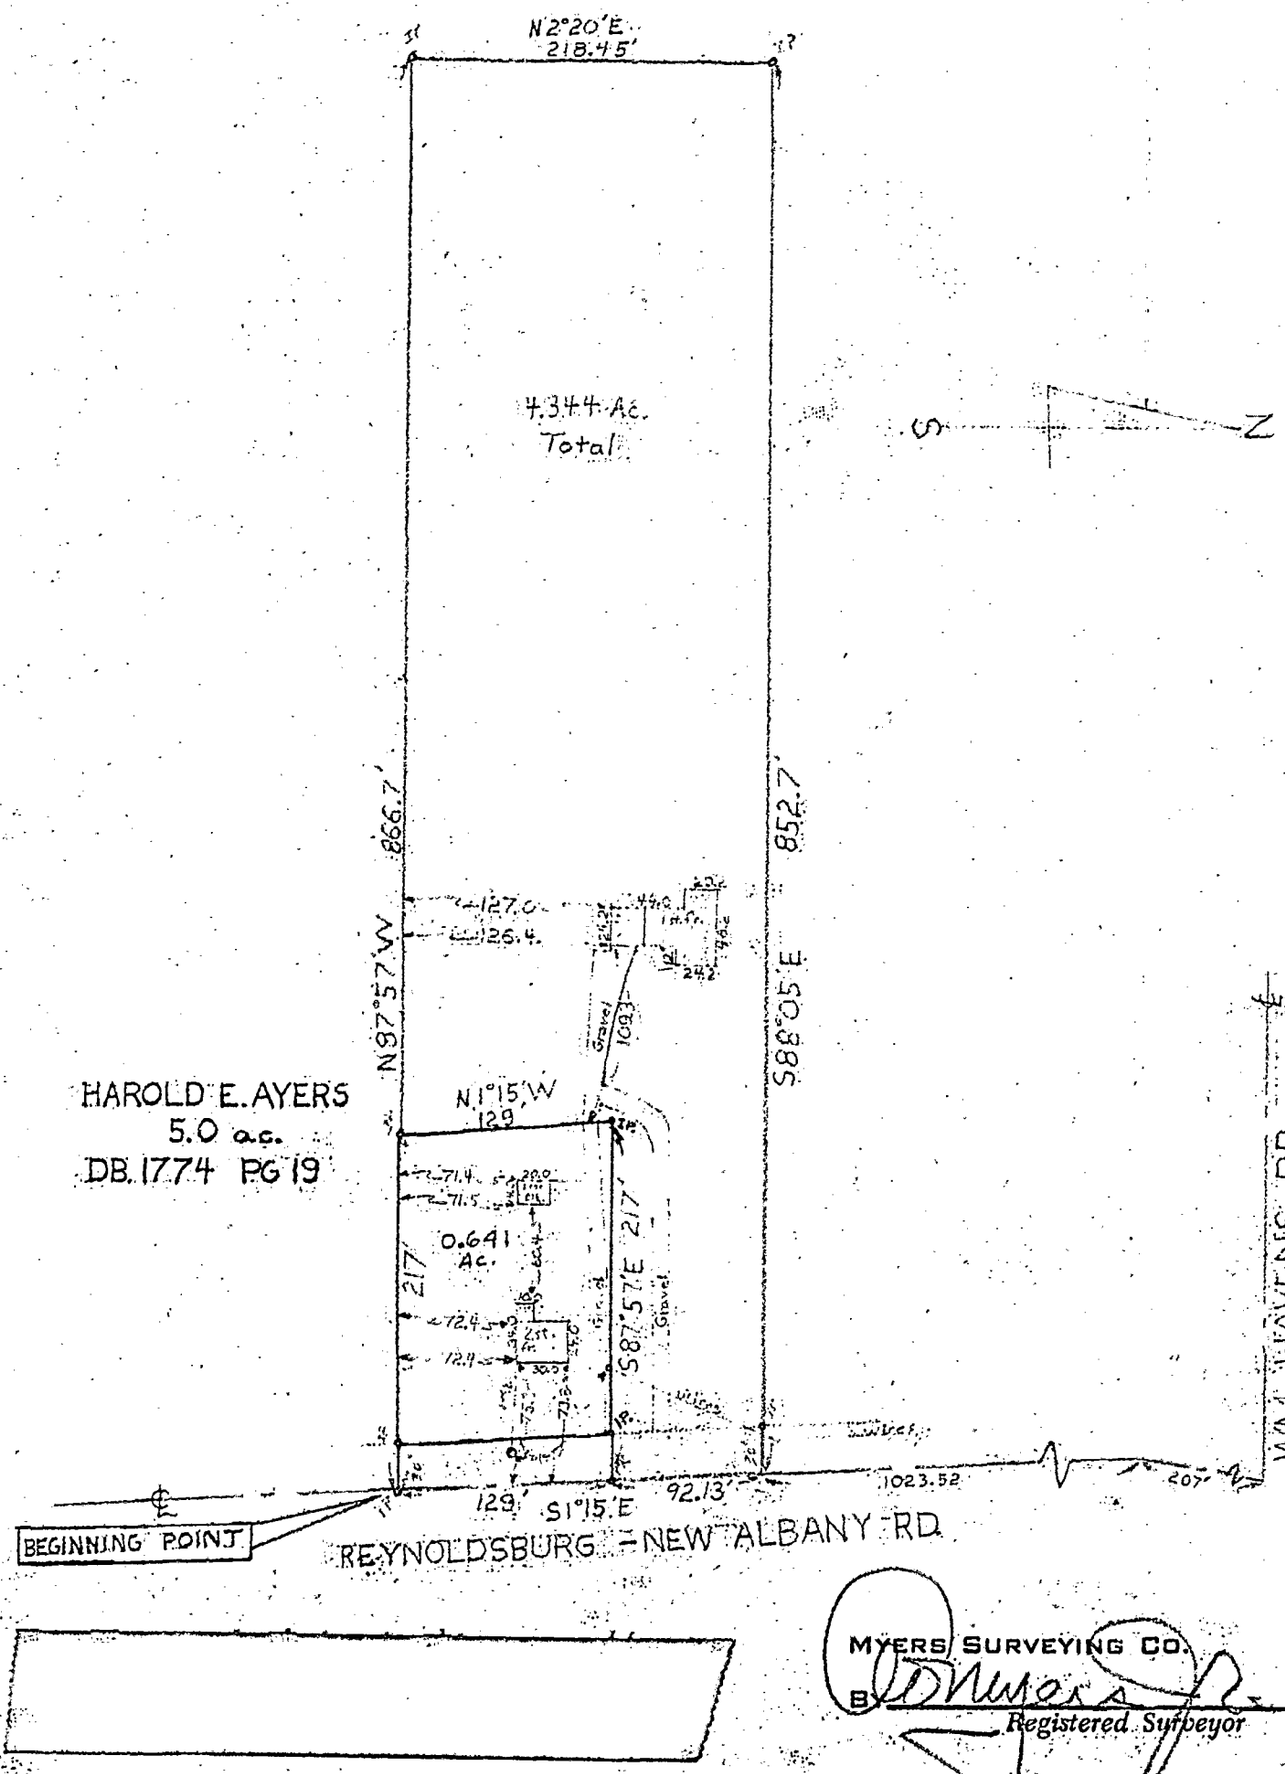

MYERS SURVEYING CO.

By

Registered Surveyor

F D L C