



38607275

JEFFERSON TWP.

040F

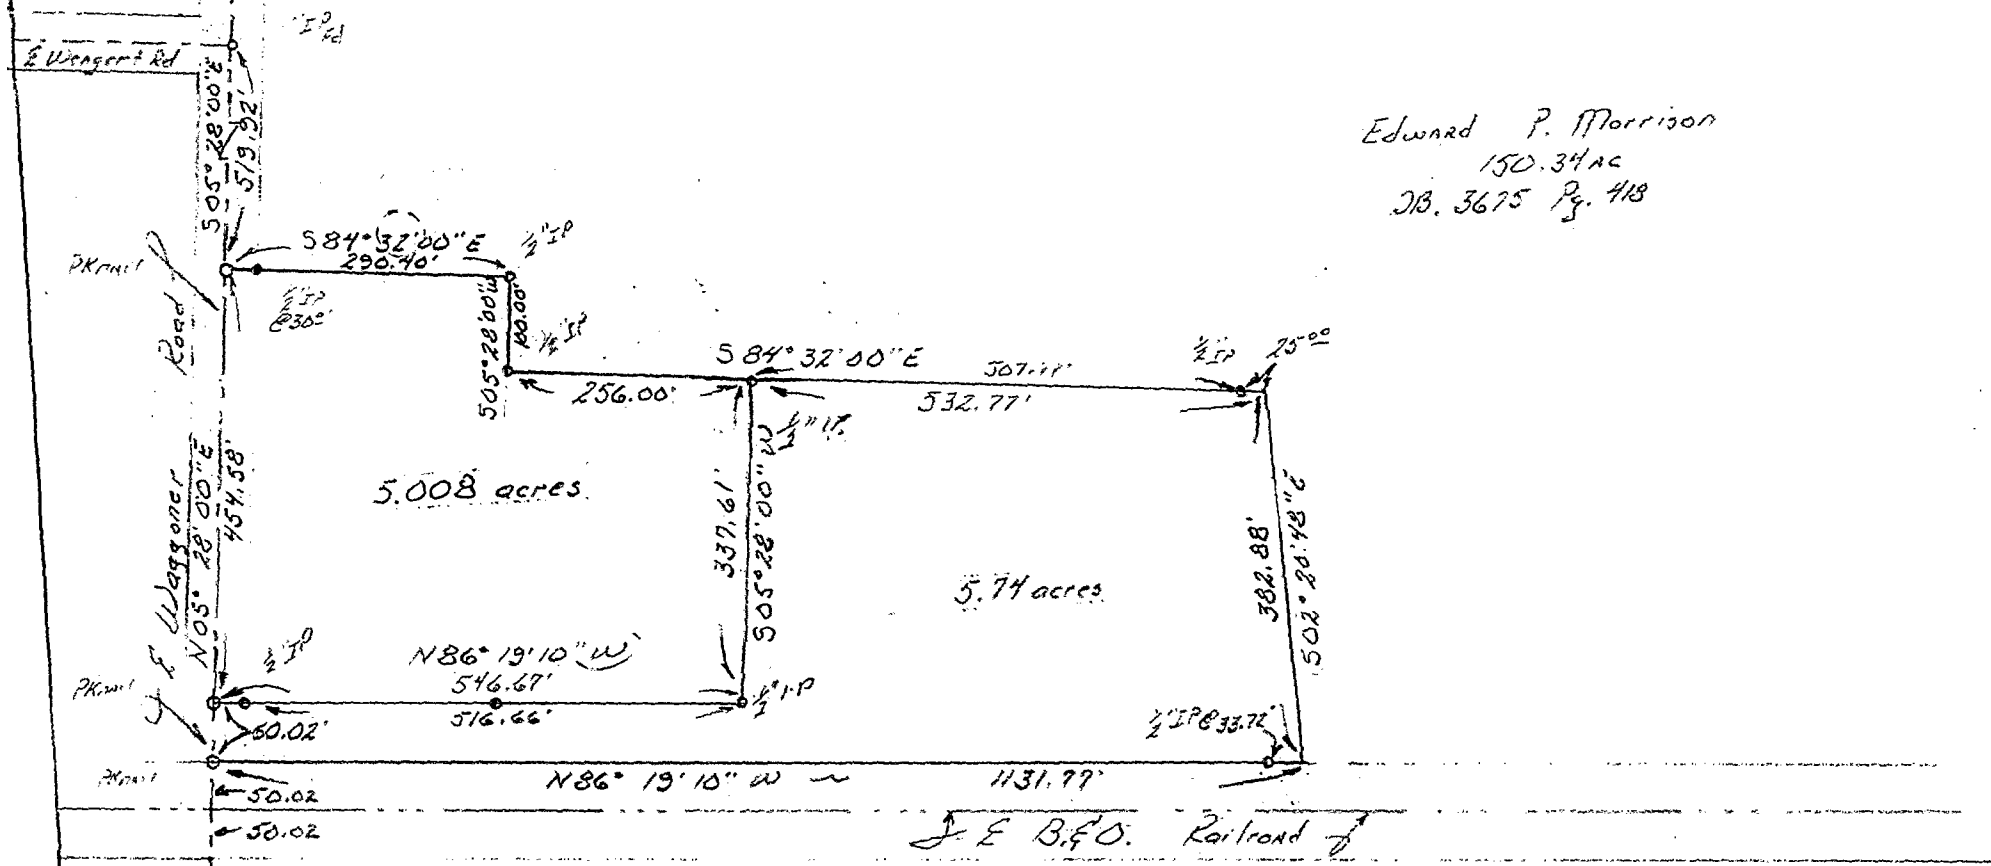

Edward P. Morrison
 150.34 AC
 DB. 3675 Pg. 418

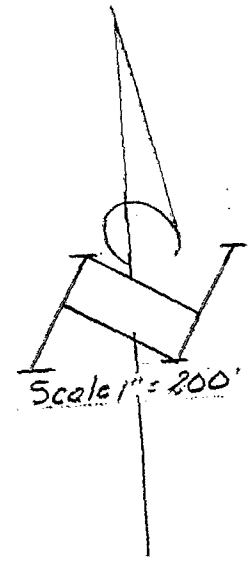

Survey of Two 5 acre tracts
 in the 4th 1/4 of Twp. 1, Rge. 16.
 Jefferson Twp., Franklin Co.,
 Ohio: For

Colvin Haulage Inc.



LOUIS F. HAINES
 SURVEYOR
 354 KESSLER ST. Phone 837-2181
 GROVEPORT, OH. 43125

I hereby certify that the plot shown hereon was prepared from
 an actual field survey, under my supervision and that said plot
 correctly represents said survey
 DATE: April 14, 1927. SIGNED: *Louis F. Haines*