


N-37-B

E OSSORN AVENUE

100'

7th AVENUE 110'

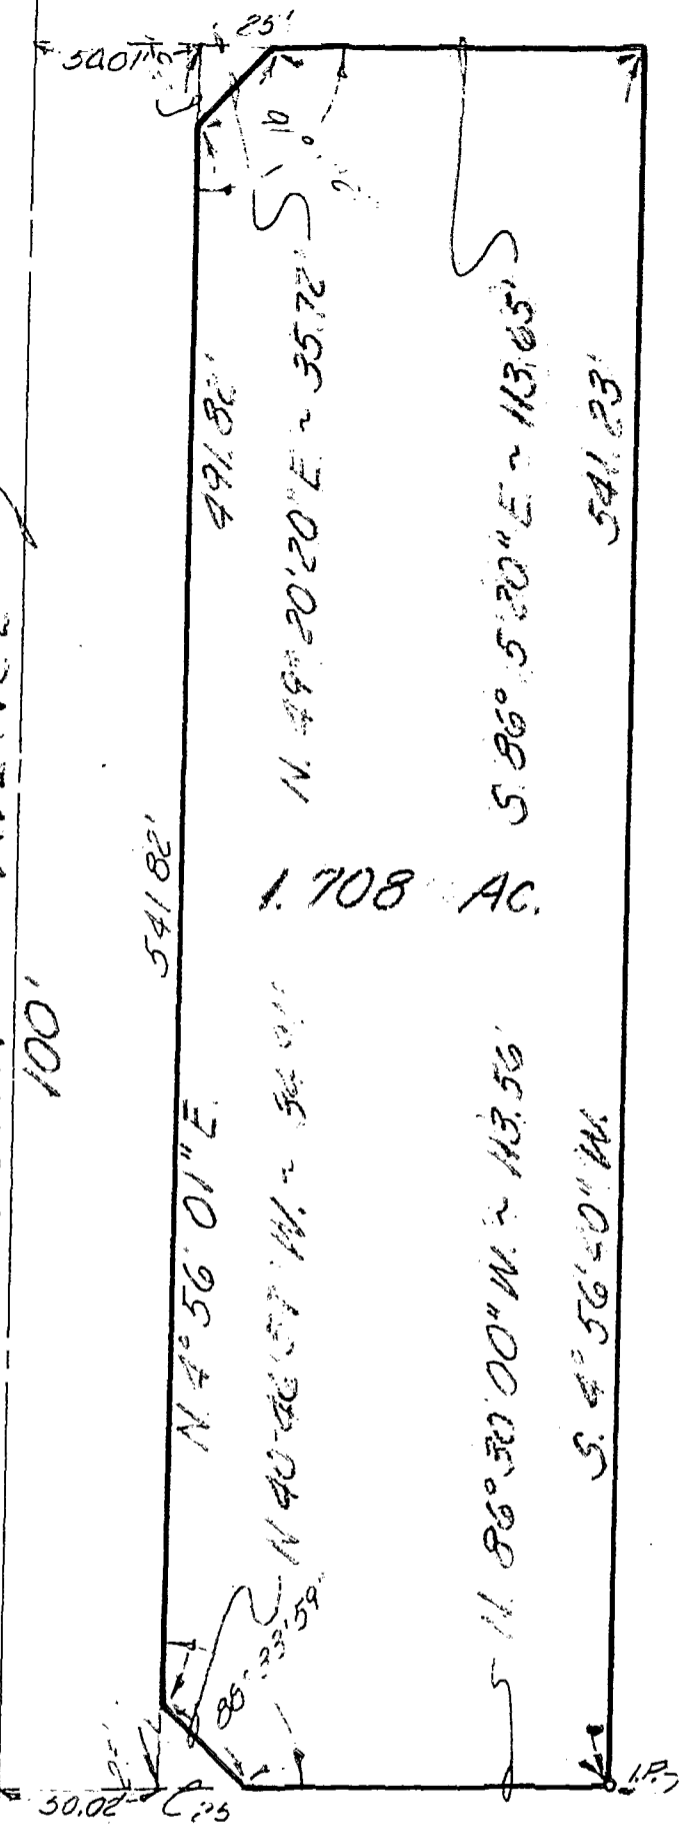

1.708 AC.

L. 5th AVENUE 100'

N-37-B
 Plat # 87202
 C.O.L.S.
 LOUIS SCHLONSKY
 5-8-61
 LETTER WRITTEN
 4-30-73



Scale: 1"=60'
 Date: Sept. 1972

PART LOT NO. 9
 JOHN STELZER'S
 AMICABLE PARTITION
 CITY OF COLUMBUS,
 FRANKLIN COUNTY, OHIO
 for
 LOUIS SCHLONSKY

THE JENNINGS-LAWRENCE CO.
 Civil Engineers and Surveyors
 555 Buttes Avenue
 Columbus 15, Ohio

By [Signature]
 Registered Surveyor

N-37-B 185707225