


PLAT OF 0.425 ACRE OUTLOT

Located in the City of Columbus, County of Franklin,
and State of Ohio, Quarter Township 2,
Township 1, Range 17 W, United States Military Lands

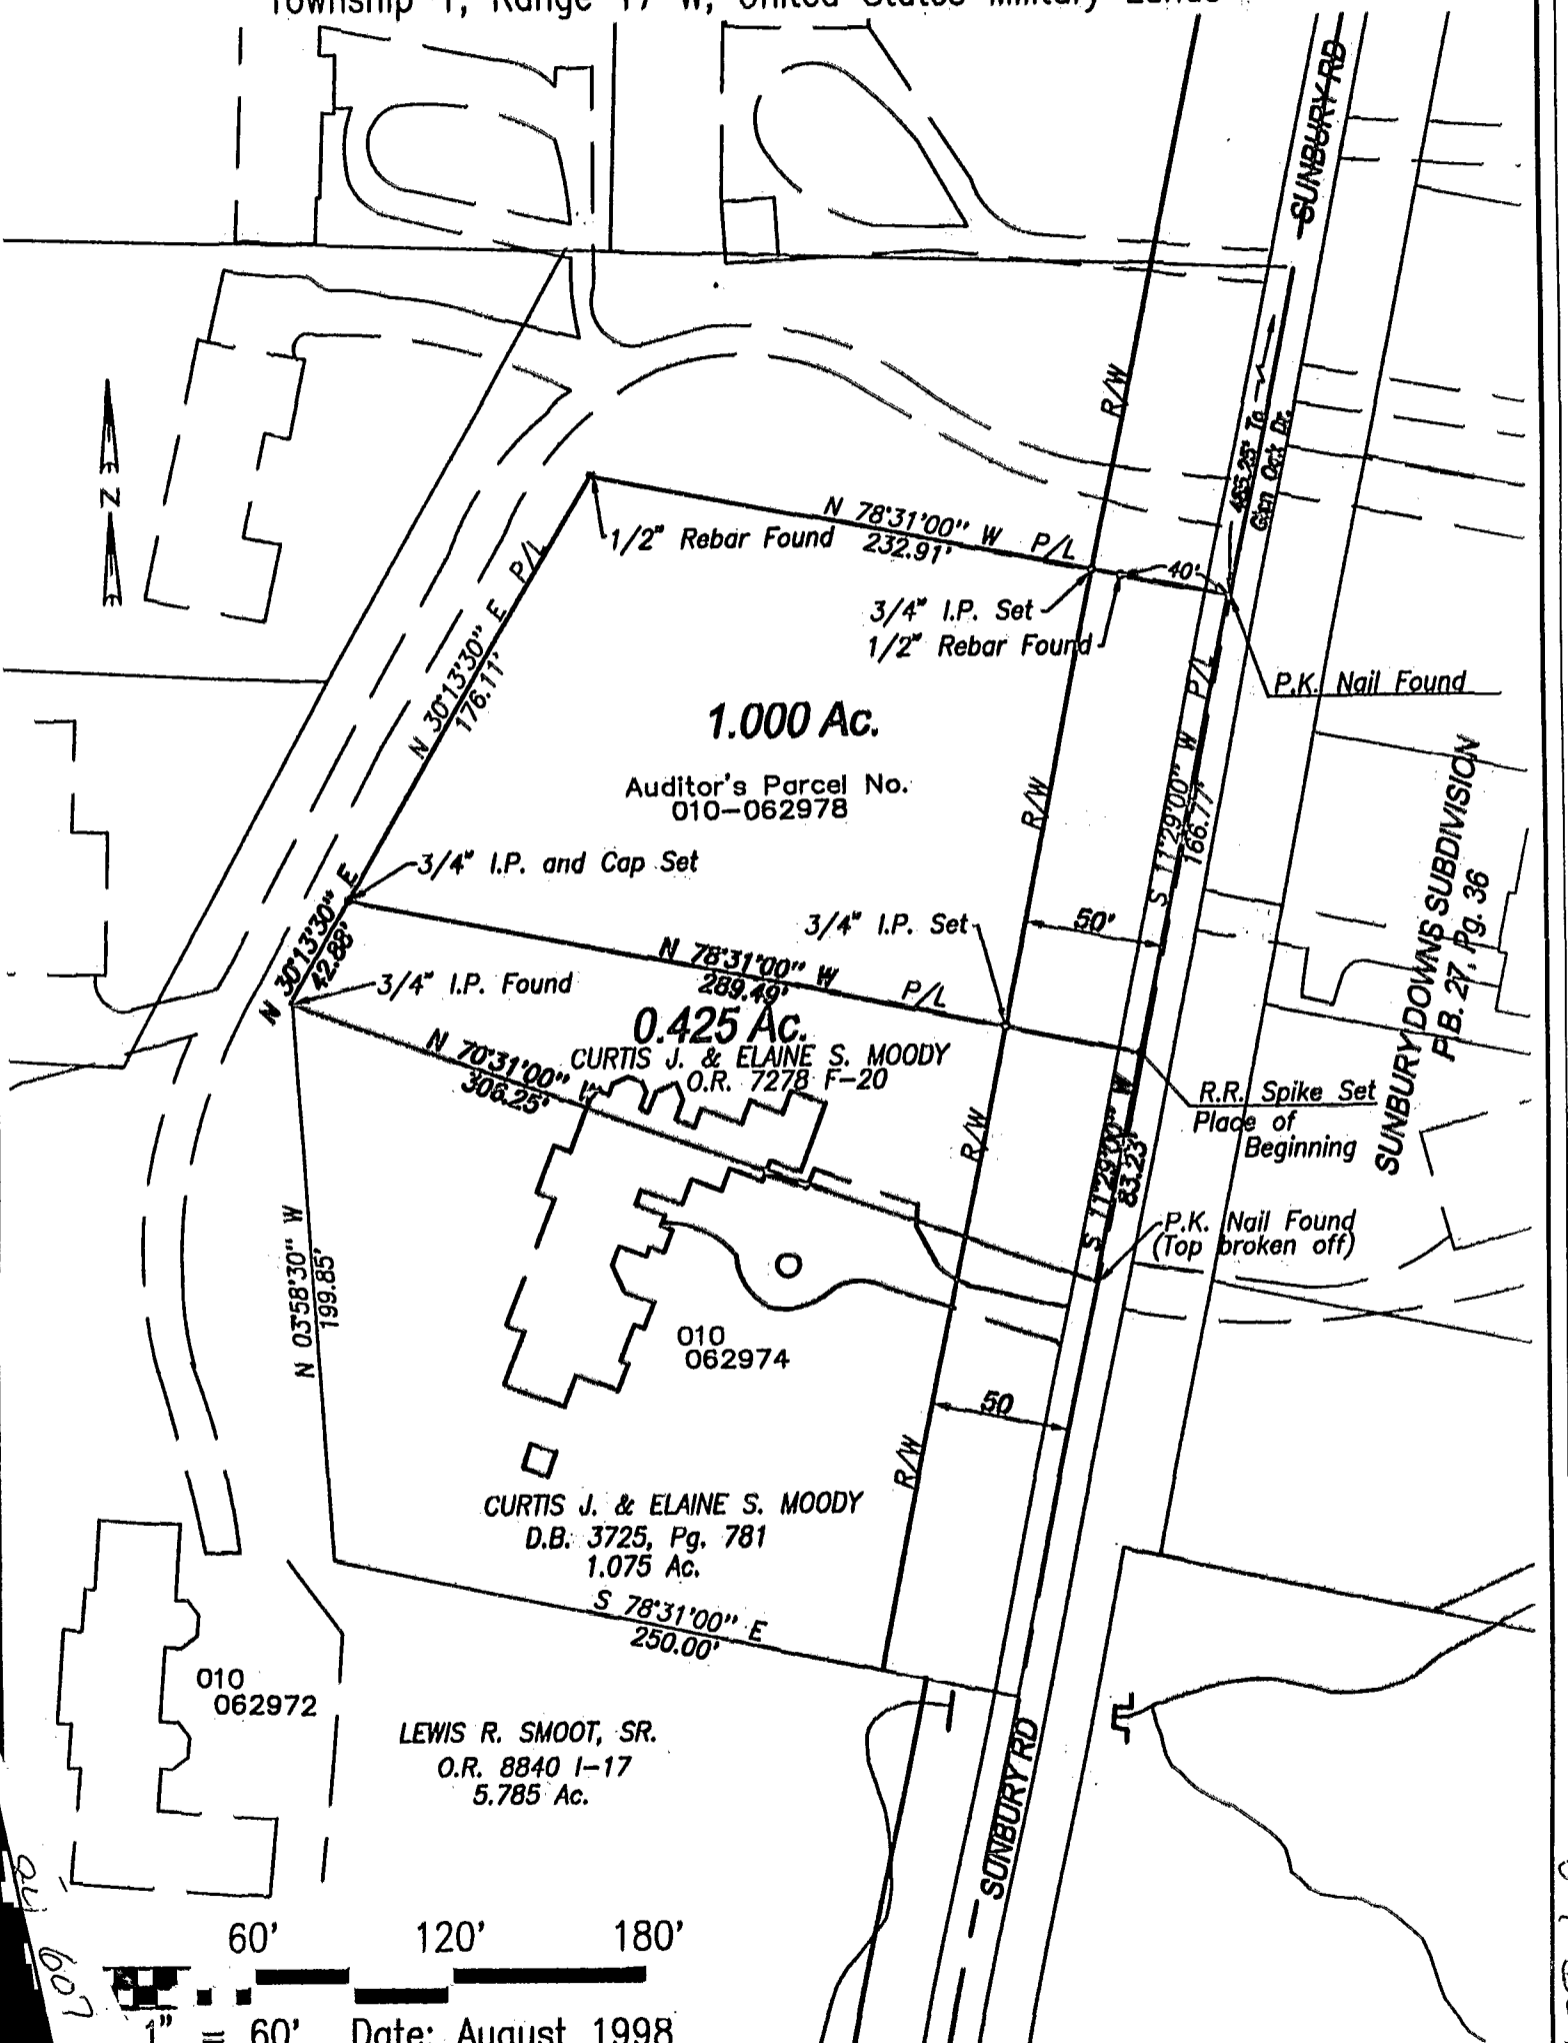

60' 120' 180'

1" = 60' Date: August 1998

Bearing:
based on the centerline of Sunbury
South 11°29'00" West, by deed of
7278 F-20

I certify that the foregoing plat
is from an actual survey
Alden M. McGee 8-27-98
Alden M. McGee, Registered Surveyor 5679

84 607 425