

0-101-C
TRURO Twp.

Myers Surveying Company, Inc.

2740 East Main Street, Columbus 43209 (Bexley), Ohio
614-235-8677 FAX: 614-235-4559



A Boundary Survey prepared for and certified to:
James Schmidt

Legal Description: Situated in Ohio, County of Franklin, City of Whitehall, Being Part of Lots 1 and 2 of W. Dehner Broad Street Farm (Unrecorded)

Applicant:
Posted Address: 4010 & 4012 E. Broad Street, Whitehall, Ohio



60' 30' 0' 60'
Scale: 1" = 60'
Date: 7-19-2002

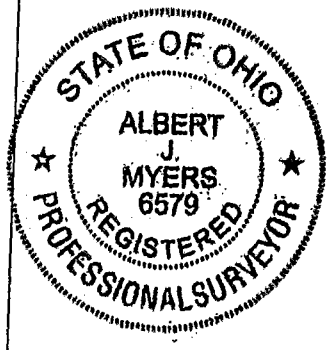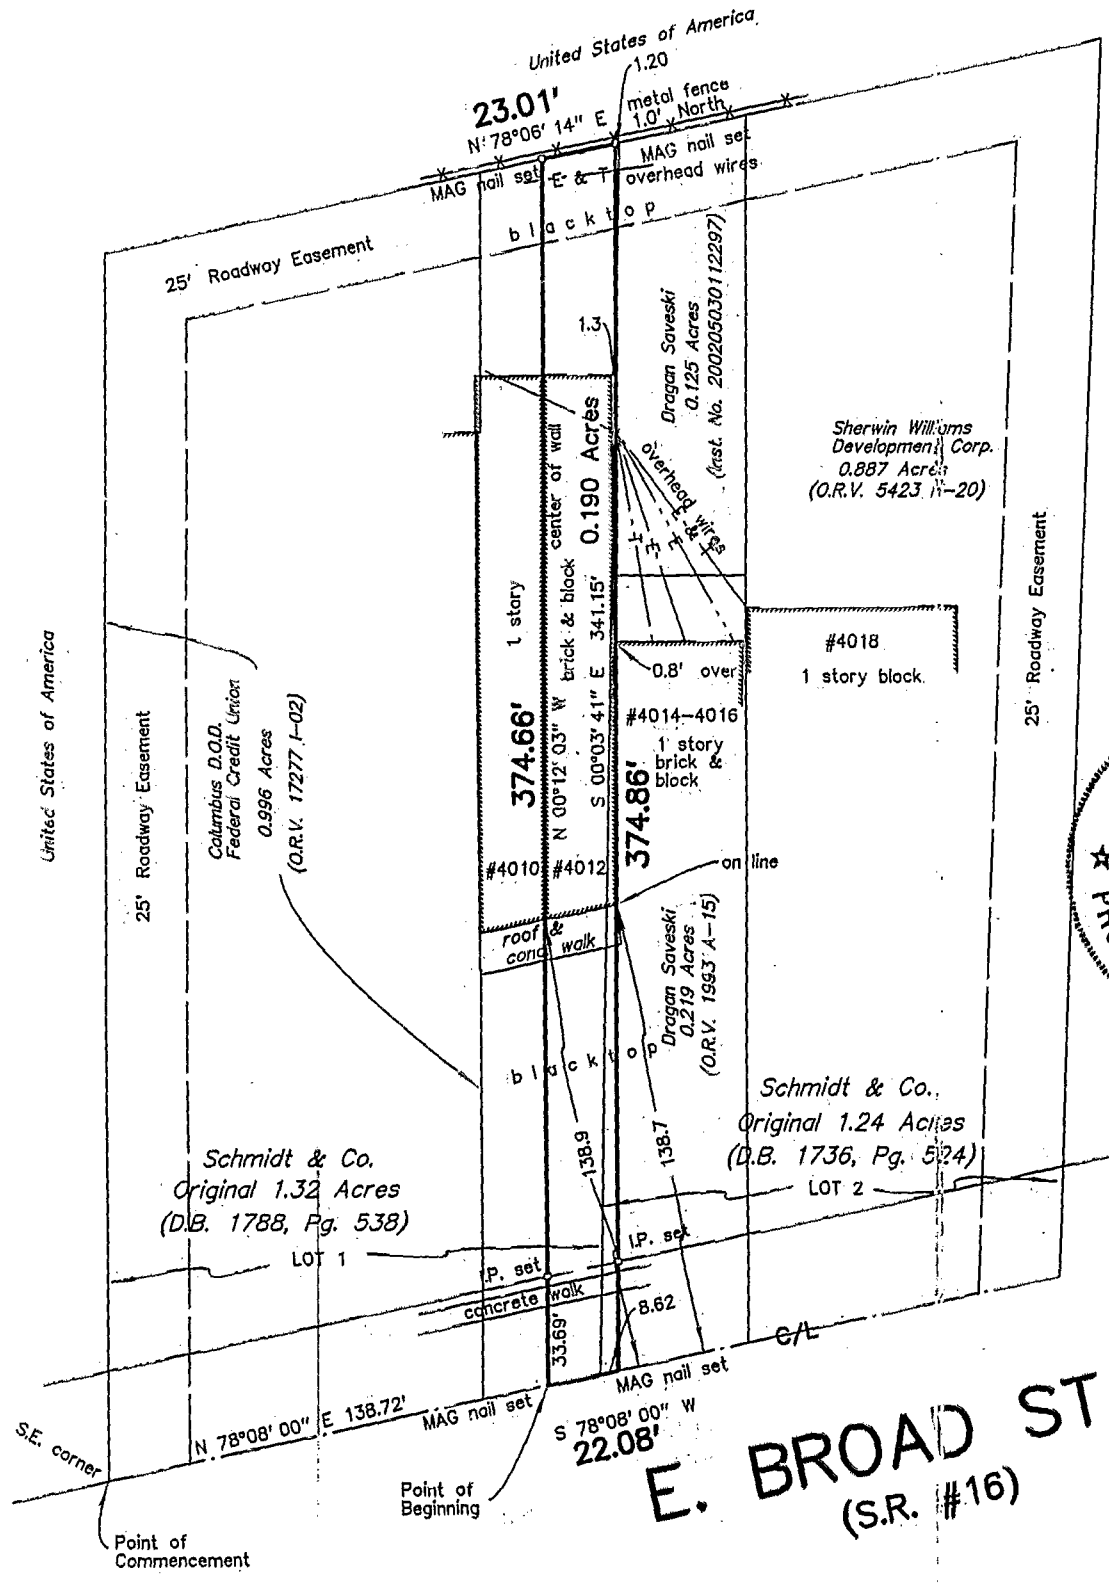

E. BROAD ST.
(S.R. #16)

We hereby certify that the foregoing Boundary Survey was prepared from actual field measurements in accordance with Chapter 4733-37 Ohio Administrative Code. Iron pins set are 30"x1" O.D. with an orange plastic plug inscribed "P.S. 6579", unless otherwise noted. Basis of bearing is the centerline of E. Broad Street held as North 78 degrees 08 minutes 00 seconds East as per Deed Book 1788 Page 538.

Myers Surveying Co., Inc.
By *Albert J. Myers*
Professional Surveyor

Myers Order No. - 37-06/24/02 | Rec. *Calvin* | Field *AST/ABO* | DWG *Nony* | Ltr. *Proctor* | Ck. *Proctor*

95607175