O-39-E
JEFFERSON TWP

BOUNDARY SURVEY OF
0.5112 ACRES
CITY OF GAHANNA, OHIO

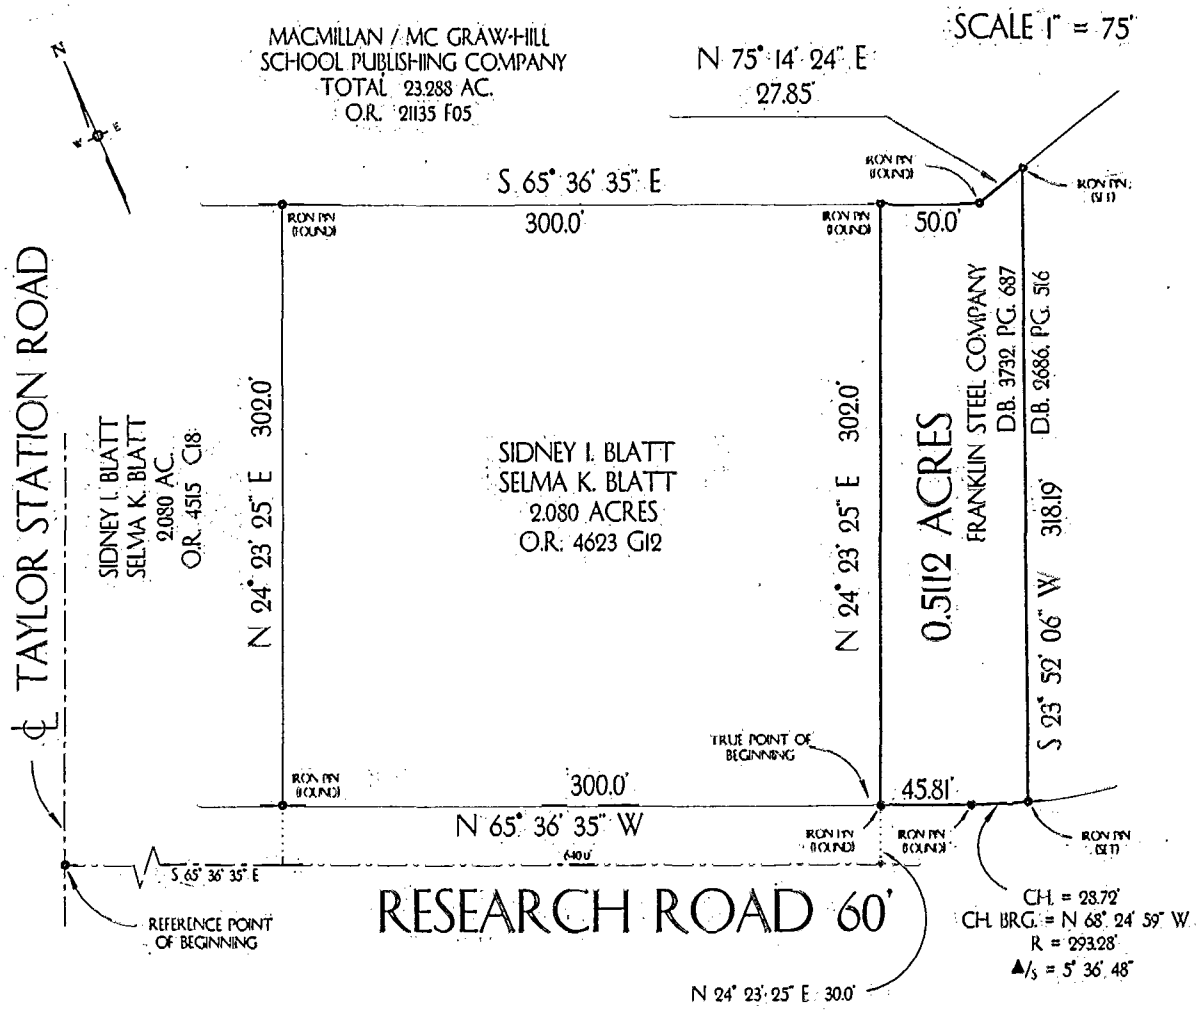

THE BEARINGS SHOWN ON THE FOREGOING PLAT ARE INTENDED TO CORRESPOND WITH THOSE SHOWN ON THE SURVEY PLAT OF SAID 2.080 ACRE TRACT, OF RECORD IN OFFICIAL RECORD 4623 G14, RECORDER'S OFFICE, FRANKLIN COUNTY, OHIO.

ALL IRON PINS DENOTED AS "SET" ARE 5/8" (I.D.) X 30" IRON PIPE PLUGGED WITH A PLASTIC CAP STAMPED ELSCO S 5519 AND HAVE BEEN SET BY ERLENBACH LAND SURVEYING COMPANY. ALL IRON PINS DENOTED AS "FOUND" HAVE BEEN SET BY OTHERS.

THE FOREGOING PLAT WAS PREPARED FROM EXISTING DEED, PLAT AND SURVEY INFORMATION ALSO A FIELD SURVEY IN ACCORDANCE WITH CHAPTER 4733-37 OHIO ADMINISTRATIVE CODE ON MAY 7, 1999 BY ERLENBACH LAND SURVEYING COMPANY.

STATE OF OHIO
GARY L. ERLENBACH
5519
REGISTERED PROFESSIONAL SURVEYOR

BY [signature]
GARY L. ERLENBACH
REGISTERED SURVEYOR NO. 5519

87107250
87857250