

HOCKADEY-LIPES-ROUSCUP, INC.


CONSULTING ENGINEERS

883 N. CASSADY AVENUE  
COLUMBUS, OHIO

040-1

JEFFERS ON

PLAT SHOWING 4.110 ACRE TRACT

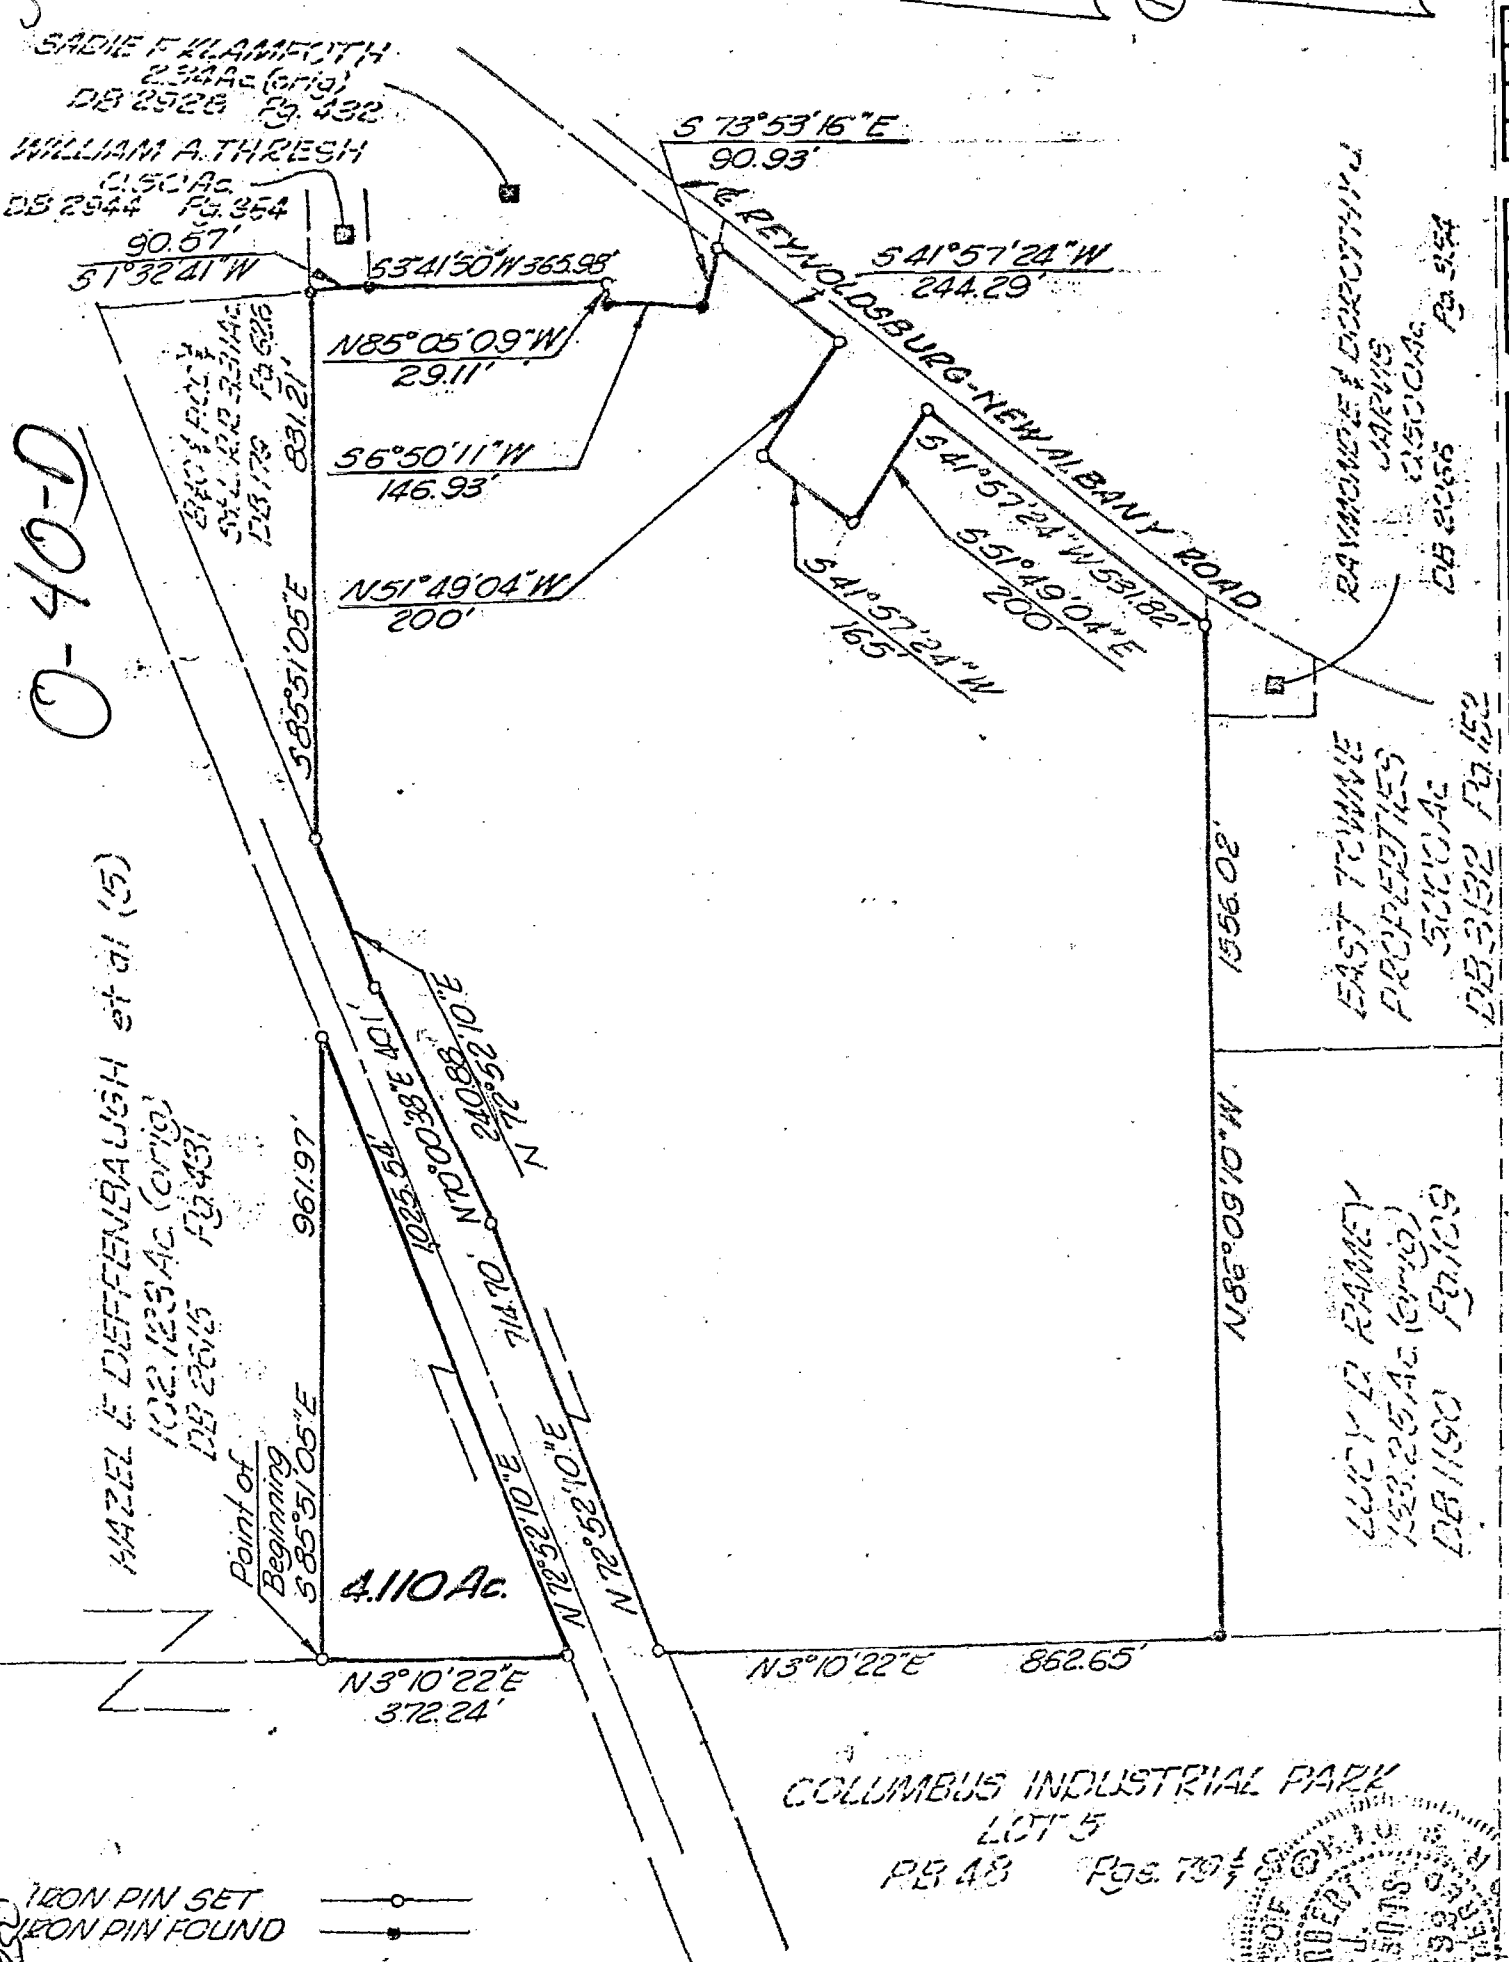

0-40-D

HAZEL E. DIEFFENBALGH et al (5)  
102.123 AC (orig)  
DB 2565 Pg 431

Point of Beginning

4.110 Ac.

COLUMBUS INDUSTRIAL PARK  
LOT 5  
Pg 48 Pg 79

EAST TOWNE  
PROPERTIES  
5000 AC  
DB 3132 Pg 152

LUCY E. RAMSEY  
123.26 AC (orig)  
DB 1190 Pg 109


IRON PIN SET  
IRON PIN FOUND

We hereby certify that the foregoing plat was prepared from an actual survey of the premises.

SCALE 1" = 300'

DATE: 1/15/74 32033  
REVISED DATES: ORDER NUMBER

HOCKADEY-LIPES-ROUSCUP, INC.

By: Herbert J. Roberts  
Registered Surveyor

SURVY'D	DRAWN	ENGINEER'D
	JW	

030  
040  
1974  
A  
120  
106  
021  
W  
REYNOLDSBURG  
NEW ALBANY ROAD  

8785 7220