

18783 7250

MYERS SURVEYING CO.

2740 East Main Street, Columbus 9 (Bexley), Ohio

LOT 12 & 39' OFF NORTHSIDE LOT 13 EZEKIEL COMPTONS ADD'N. TO (SMITHVILLE) BLACKLICK, JEFFERSON TWP., FRANKLIN CO., OHIO

FOR
OHIO TITLE CORP. AND/OR
BLACKLICK MACHINE COMPANY

P.B. 3 Page 40
Scale 1" = 25'

Franklin Co. Rec. Office.

8 · 5 · '67

SURVEY Book 2
Page 124


M-95

15' ALLEY

(109' rec. plat + 9.23')

118.23' survey

41)
410
Jeff

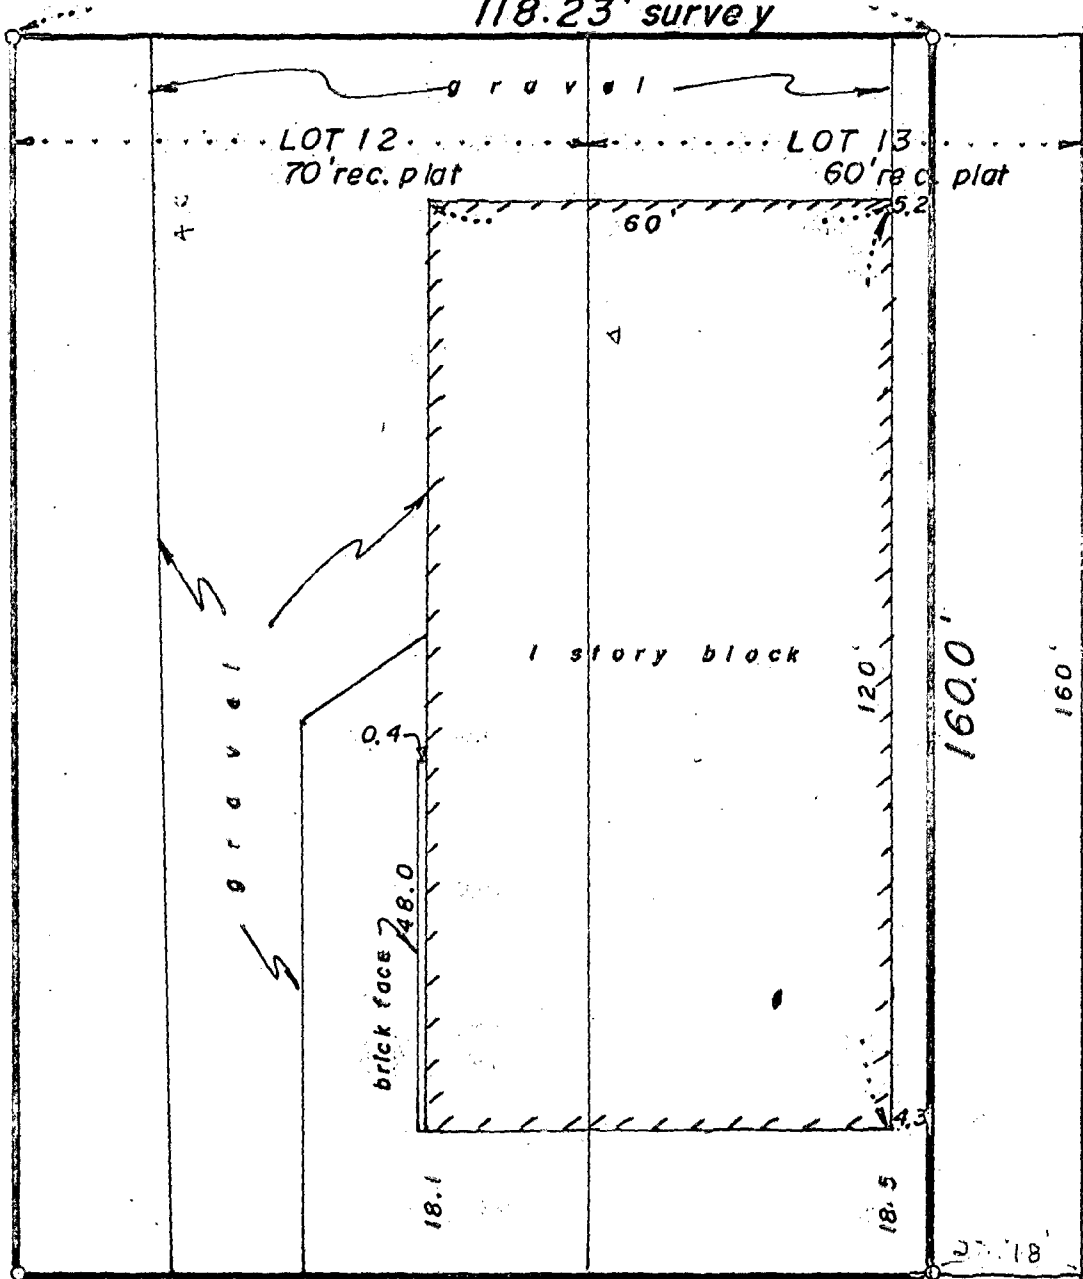

(180' + 1524')
195.24' To
NORTH ST.

118.23' survey

(109' rec. plat + 9.23')

MULBERRY ST. 60'

M-95

We hereby certify that the foregoing plat was prepared from an actual survey of the premises. No side line of principal building is less than dimension shown. Iron pins not set unless indicated thus -0-.

MYERS SURVEYING CO.
BY *[Signature]*
Registered Surveyor

80665 #72687