E.M.H.&T. INC.
CONSULTING ENGINEERS & SURVEYORS
GAHANNA, OHIO 43230

SURVEY OF LEASE PARCEL
LOCATED IN QUARTER TOWNSHIP 4, TOWNSHIP 1, RANGE 16
UNITED STATES MILITARY LANDS
CITY OF COLUMBUS, COUNTY OF FRANKLIN, STATE OF OHIO

SCALE 1" = 60' | APRIL 3, 1998 | RECORD REFERENCES O.R. 33851J11

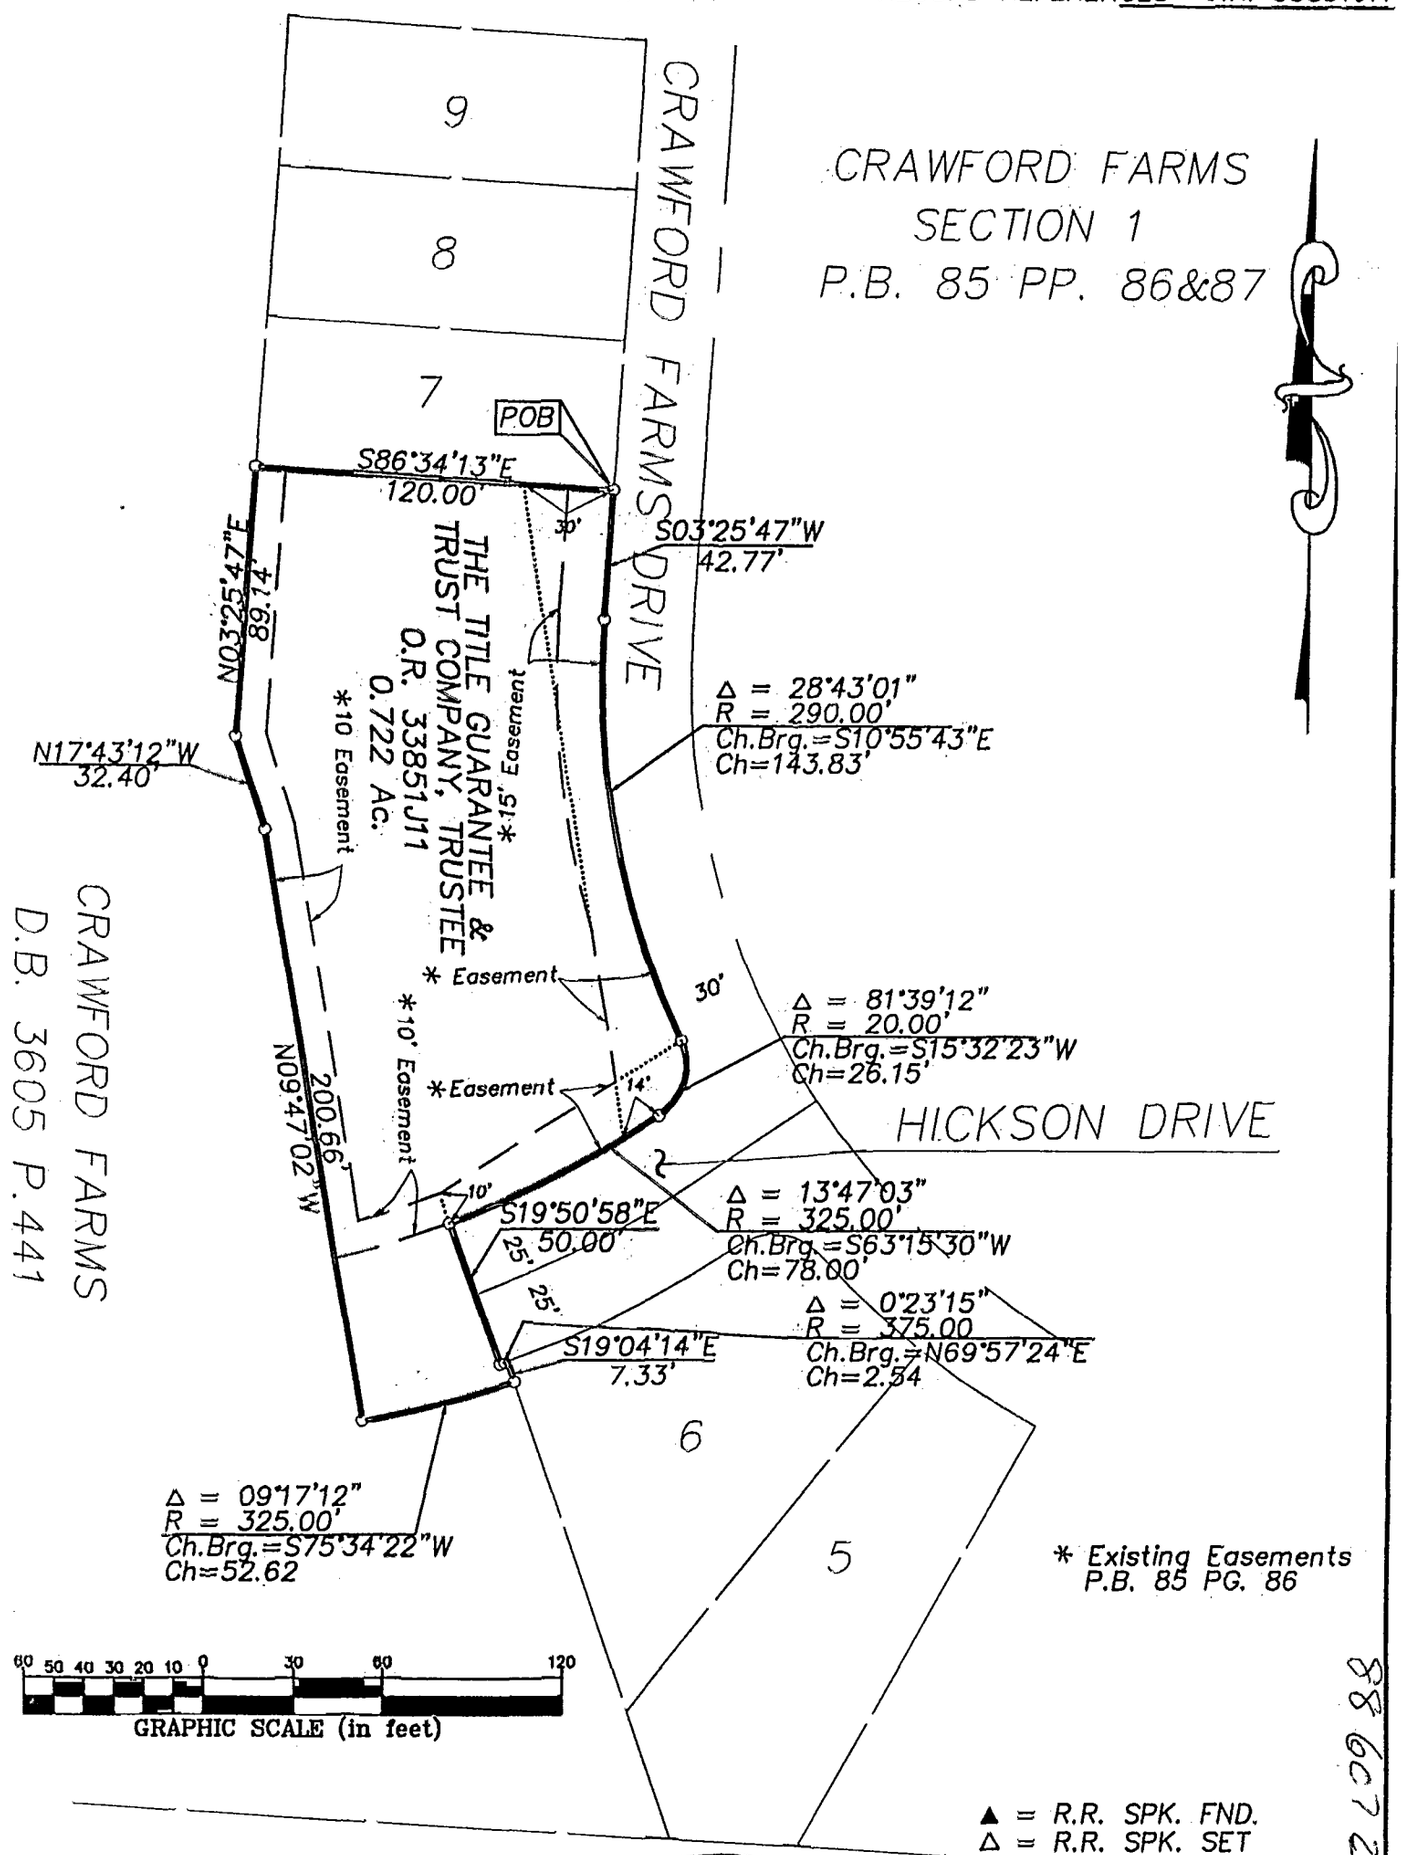

* Existing Easements P.B. 85 PG. 86

60 50 40 30 20 10 0 30 60 120
GRAPHIC SCALE (in feet)

▲ = R.R. SPK. FND.
Δ = R.R. SPK. SET
• = I.P. FND.
o = I.P. SET
I.P.S Set are 13/16" I.D. Iron pipe with cap inscribed E.M.H.T. INC.

BASIS OF BEARINGS: The bearings shown on this plat are based on the same meridian as the bearings shown on the subdivision plat entitled "Crawford Farms Section 1", of record in Plat Book 85, Page 86, Recorder's Office, Franklin County, Ohio.

STATE OF OHIO
MATTHEW A KIRK
7865
REGISTERED
PROFESSIONAL SURVEYOR

E.M.H.&T. INC.

By _____
Professional Surveyor No. 7865

88 6C7 250

419-98